


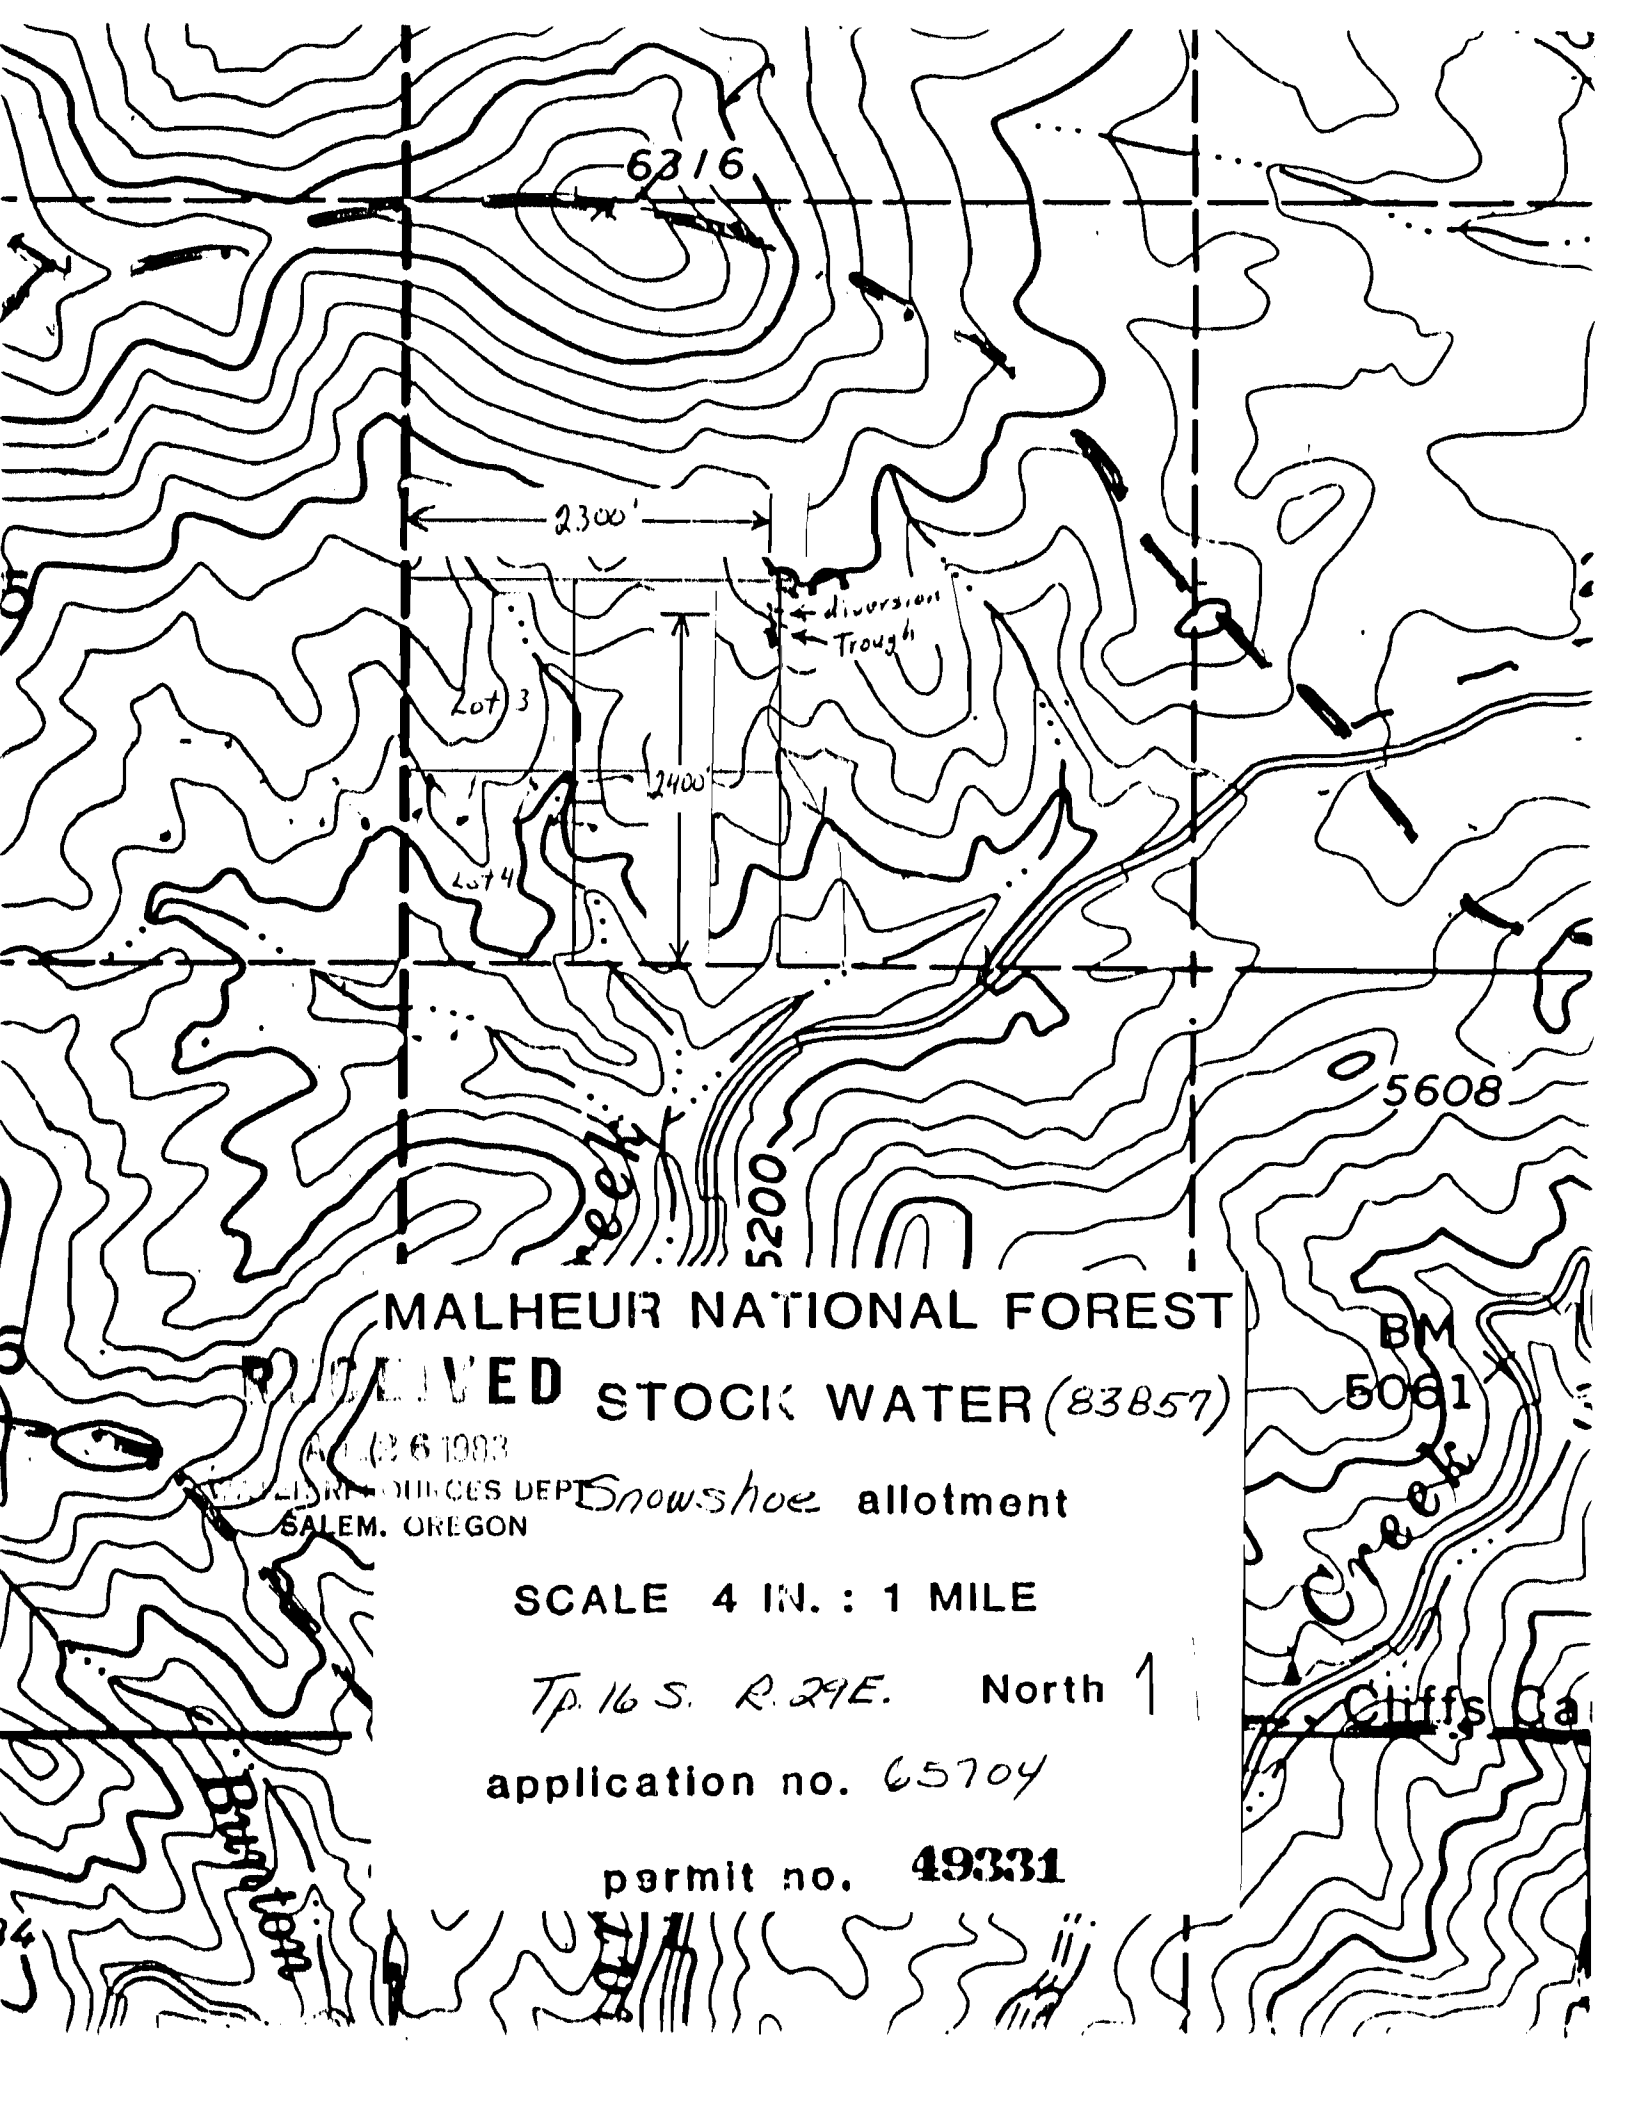

6316

2300'

Lot 3

2400'

Lot 4

diversion
Trough

5608

5200

MALHEUR NATIONAL FOREST



WATER RESOURCES DEPT
SALEM, OREGON

Snowshoe allotment

BM
5061

SCALE 4 IN. : 1 MILE

Tp. 16 S. R. 29 E. North 1

application no. 65704

permit no. **49331**

Creek

Cliffs Ca