


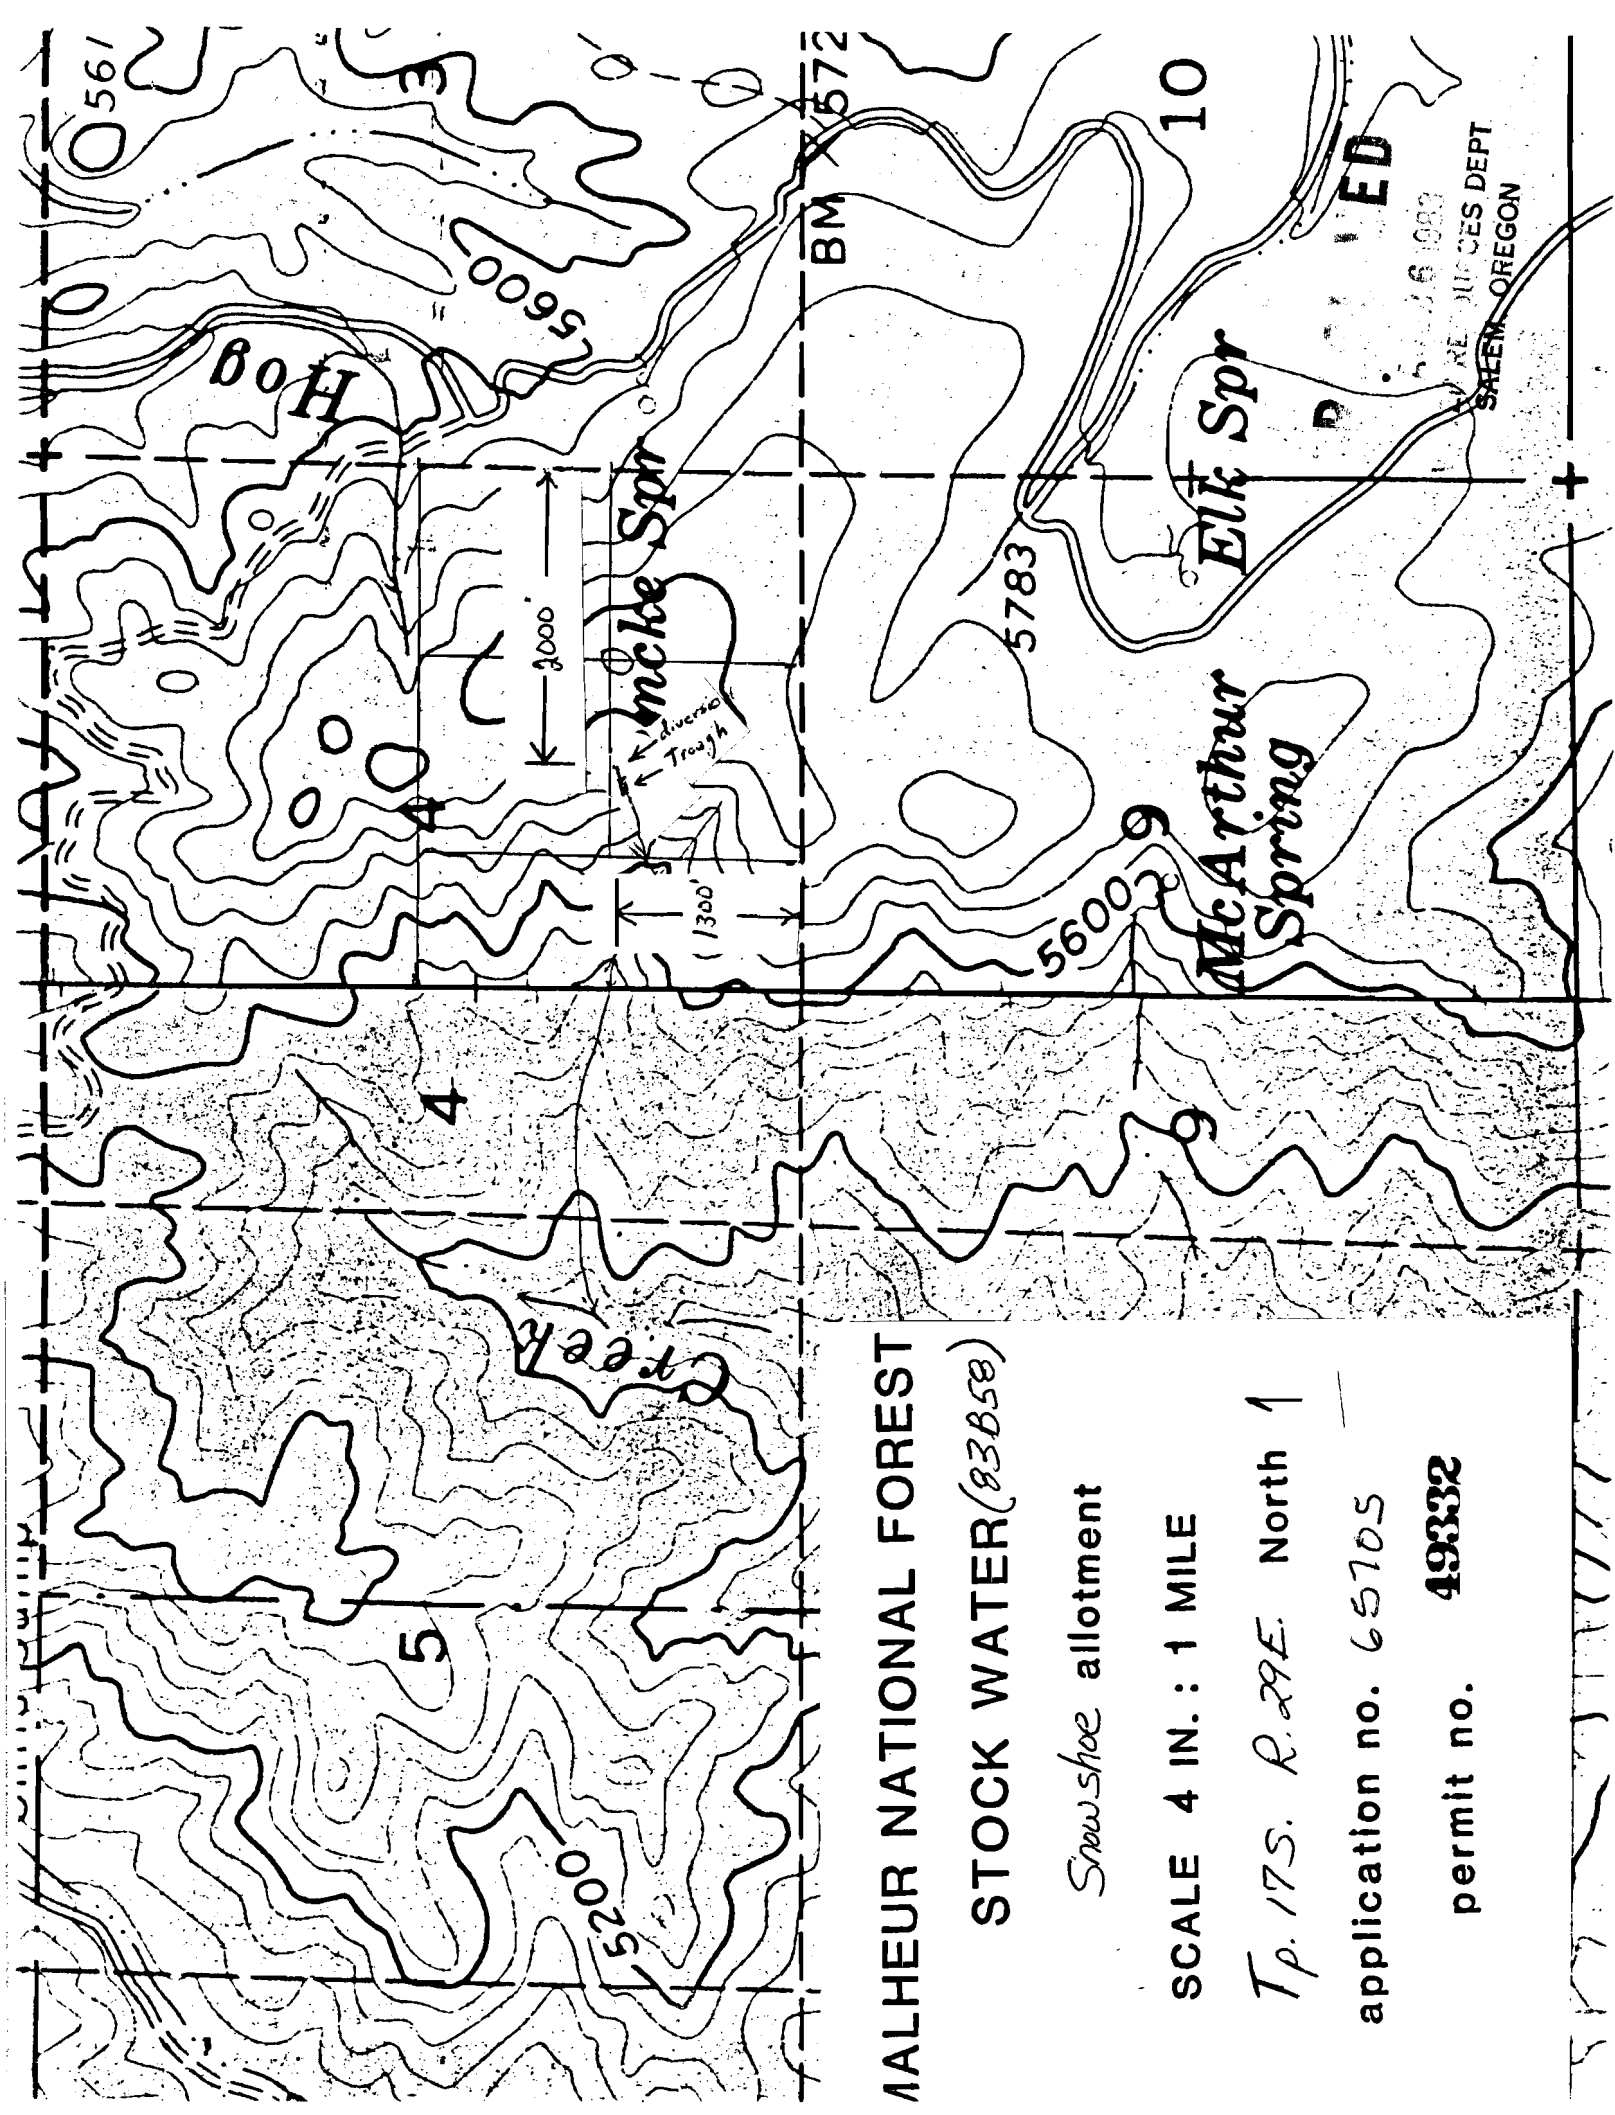

MALHEUR NATIONAL FOREST

STOCK WATER(83858)

Snowshoe allotment

SCALE 4 IN. : 1 MILE

Tp. 17S. R. 29E. North 1

application no. 65705

permit no. **49332**