


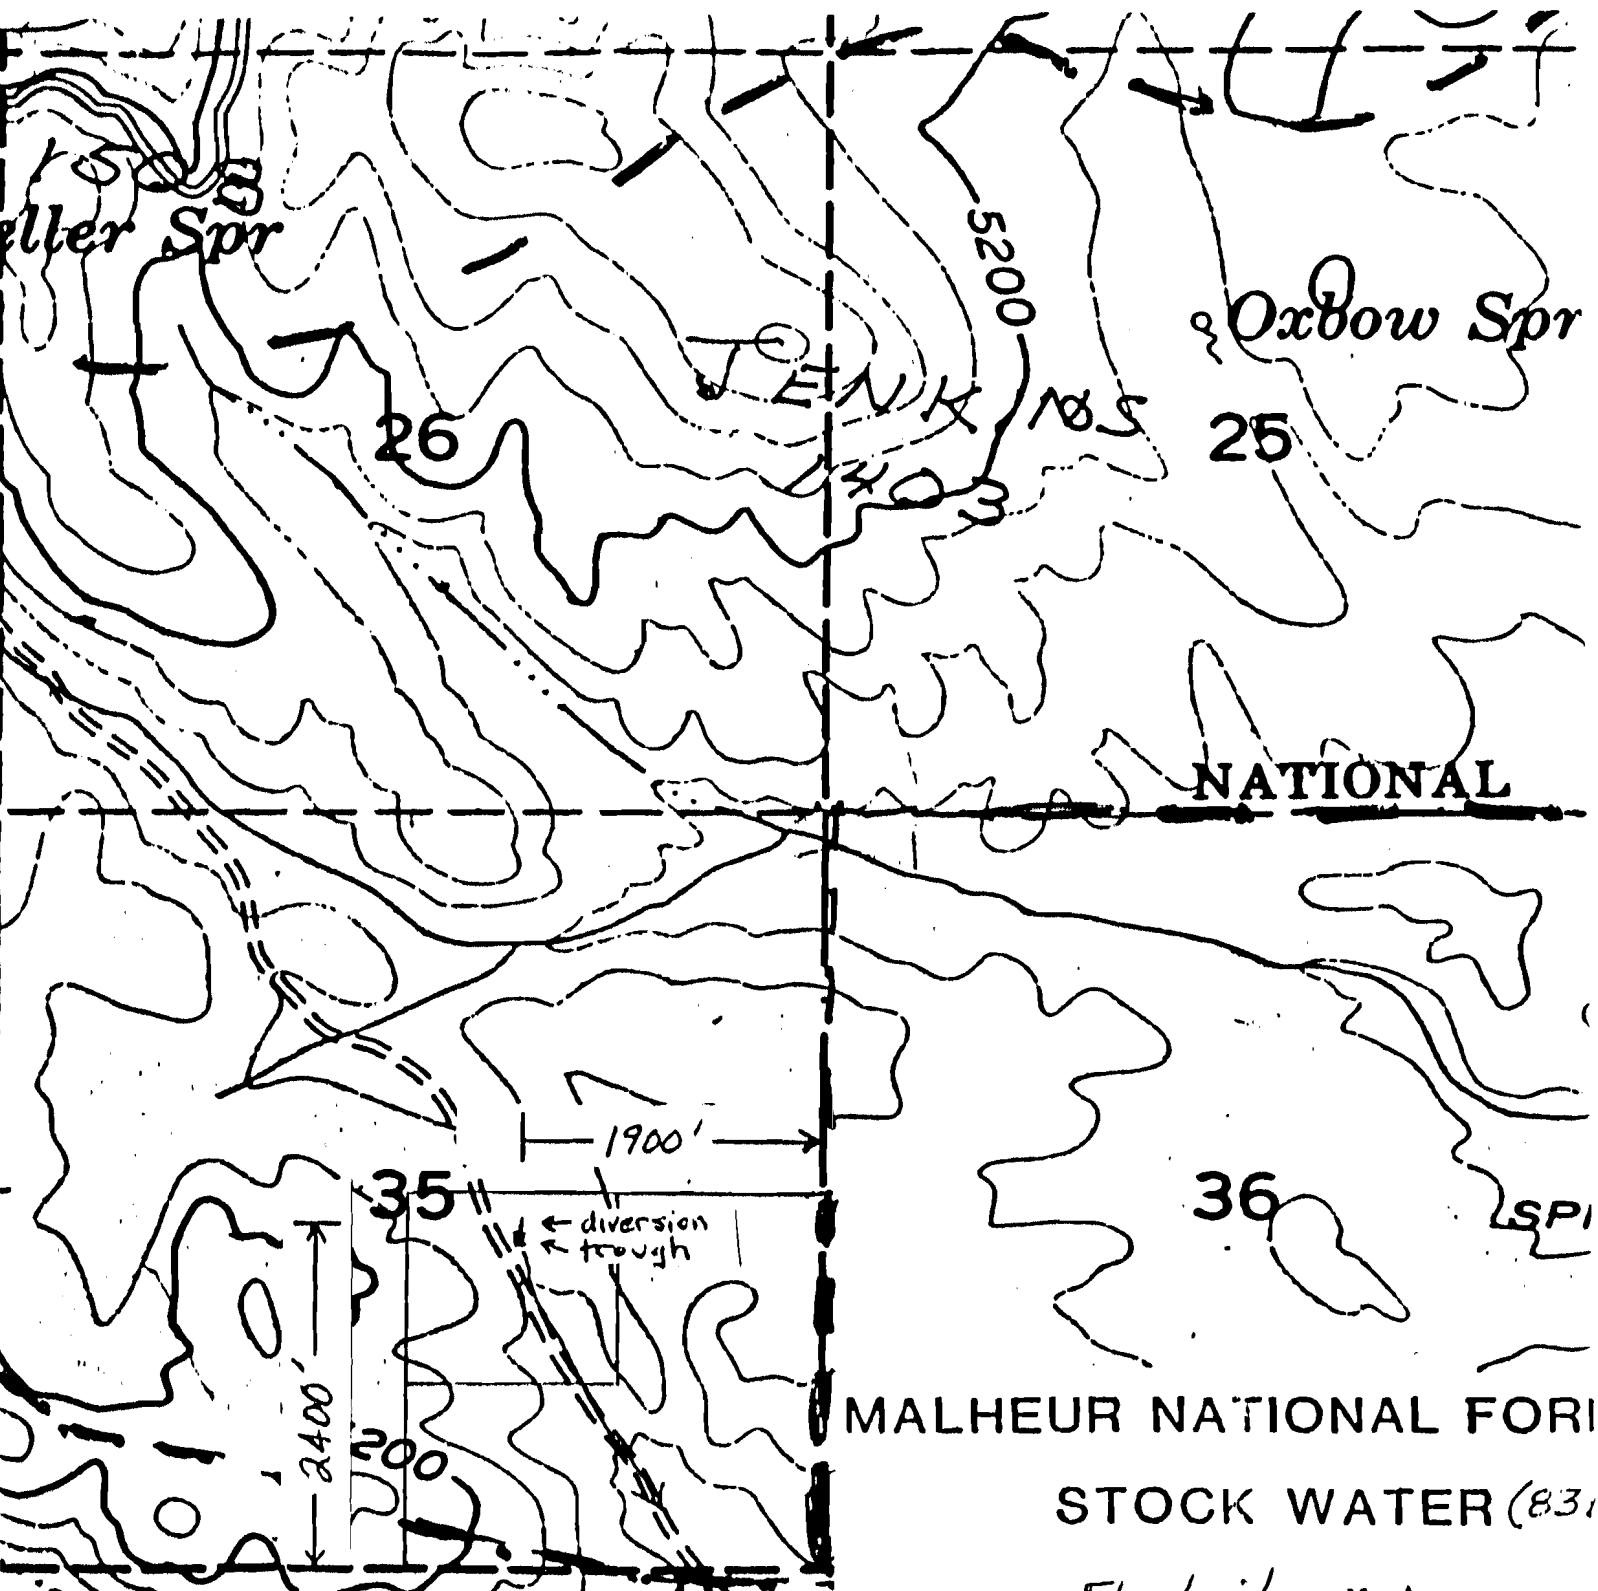

MALHEUR NATIONAL FORI
STOCK WATER (83)

Flagtail allotment

RECEIVED

Aug 26 1983
WATER RESOURCES DEPT.
SALEM, OREGON

SCALE 4 IN. : 1 MILE

Tp. 15 S. R. 29 E. North

application no. 65706

Permit no. 4933?