


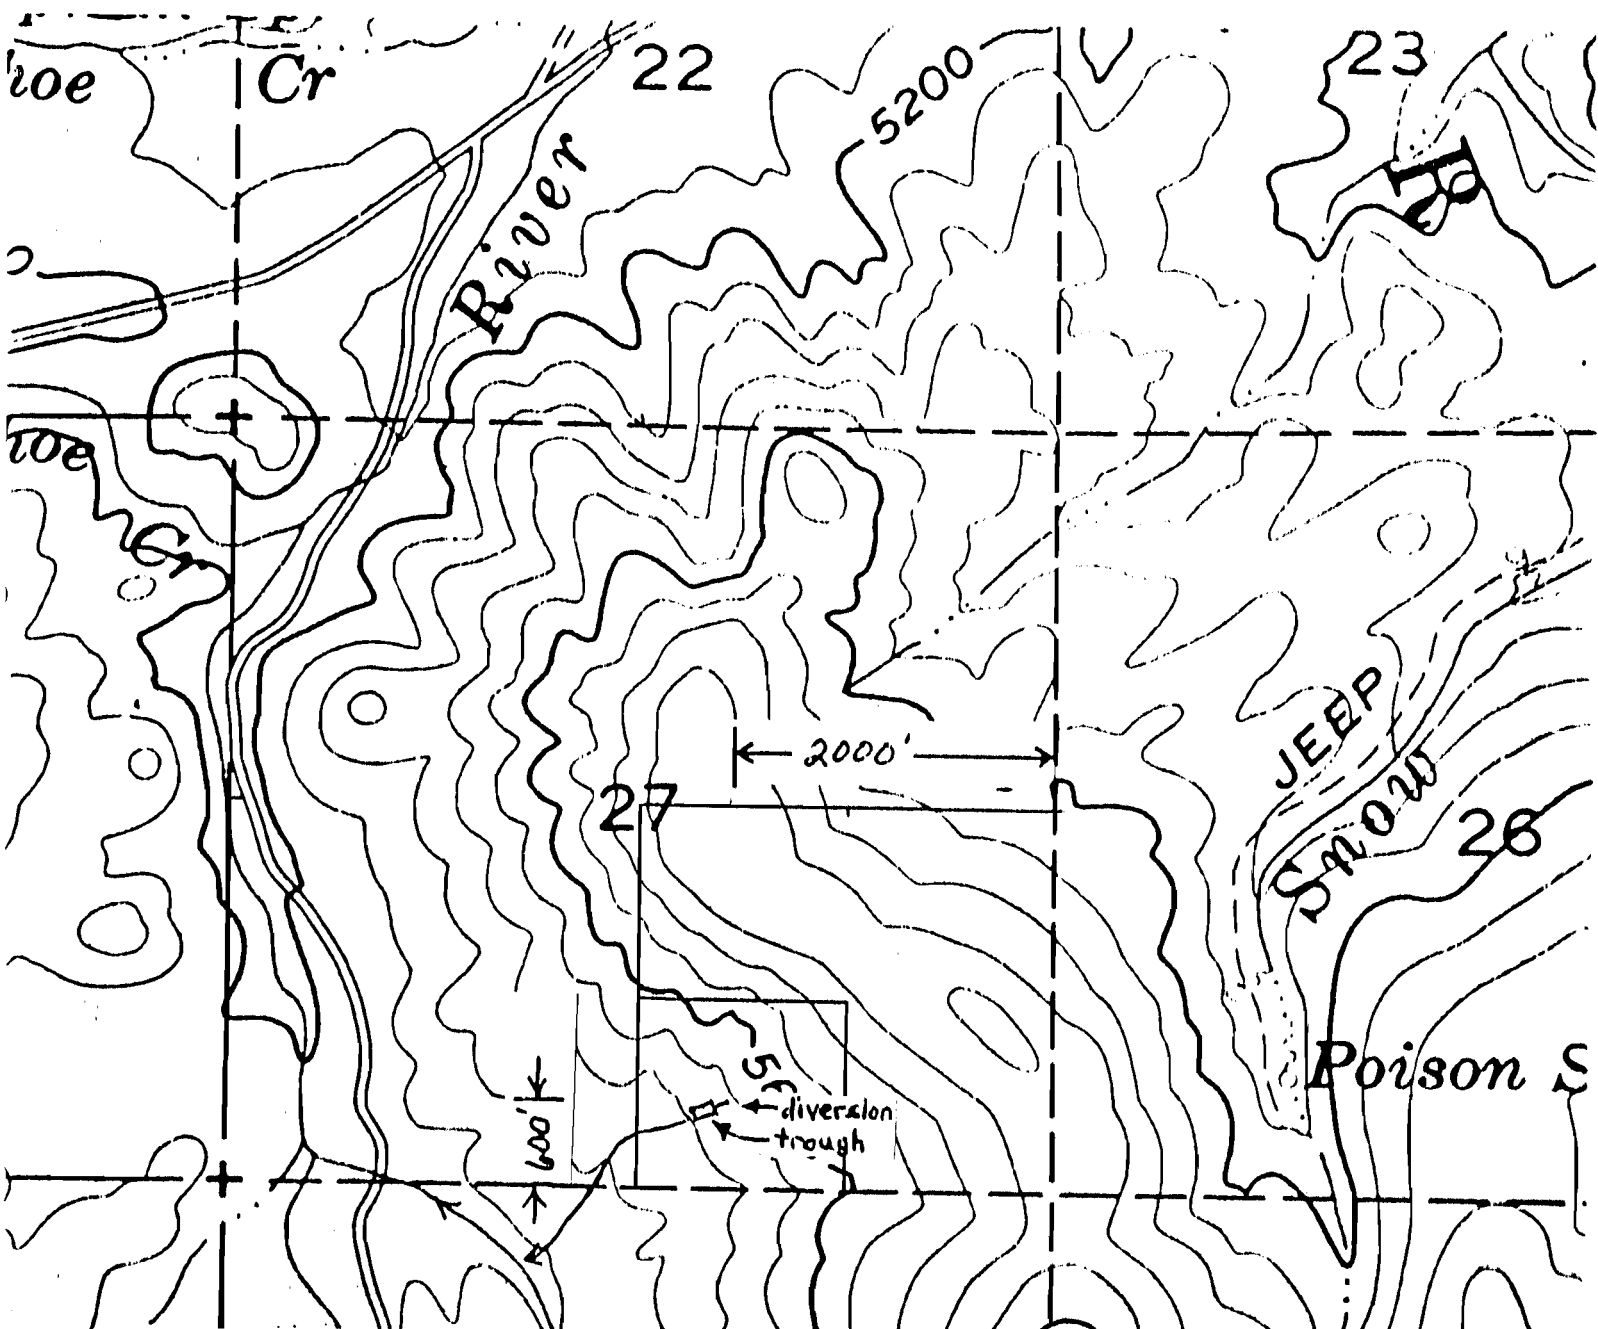

MALHEUR NATIONAL FOREST
STOCK WATER (83B60)

Jack Creek allotment

SCALE 4 IN. : 1 MILE

Tp 16S. R. 29E. North ↑

application no. 65707

permit no. 49334

REVISED
JUL 26 1983
WILDLIFE RESOURCES DEPT
EM. OREGON

X 6135

35 X
6060

Roll
Sp

5617