


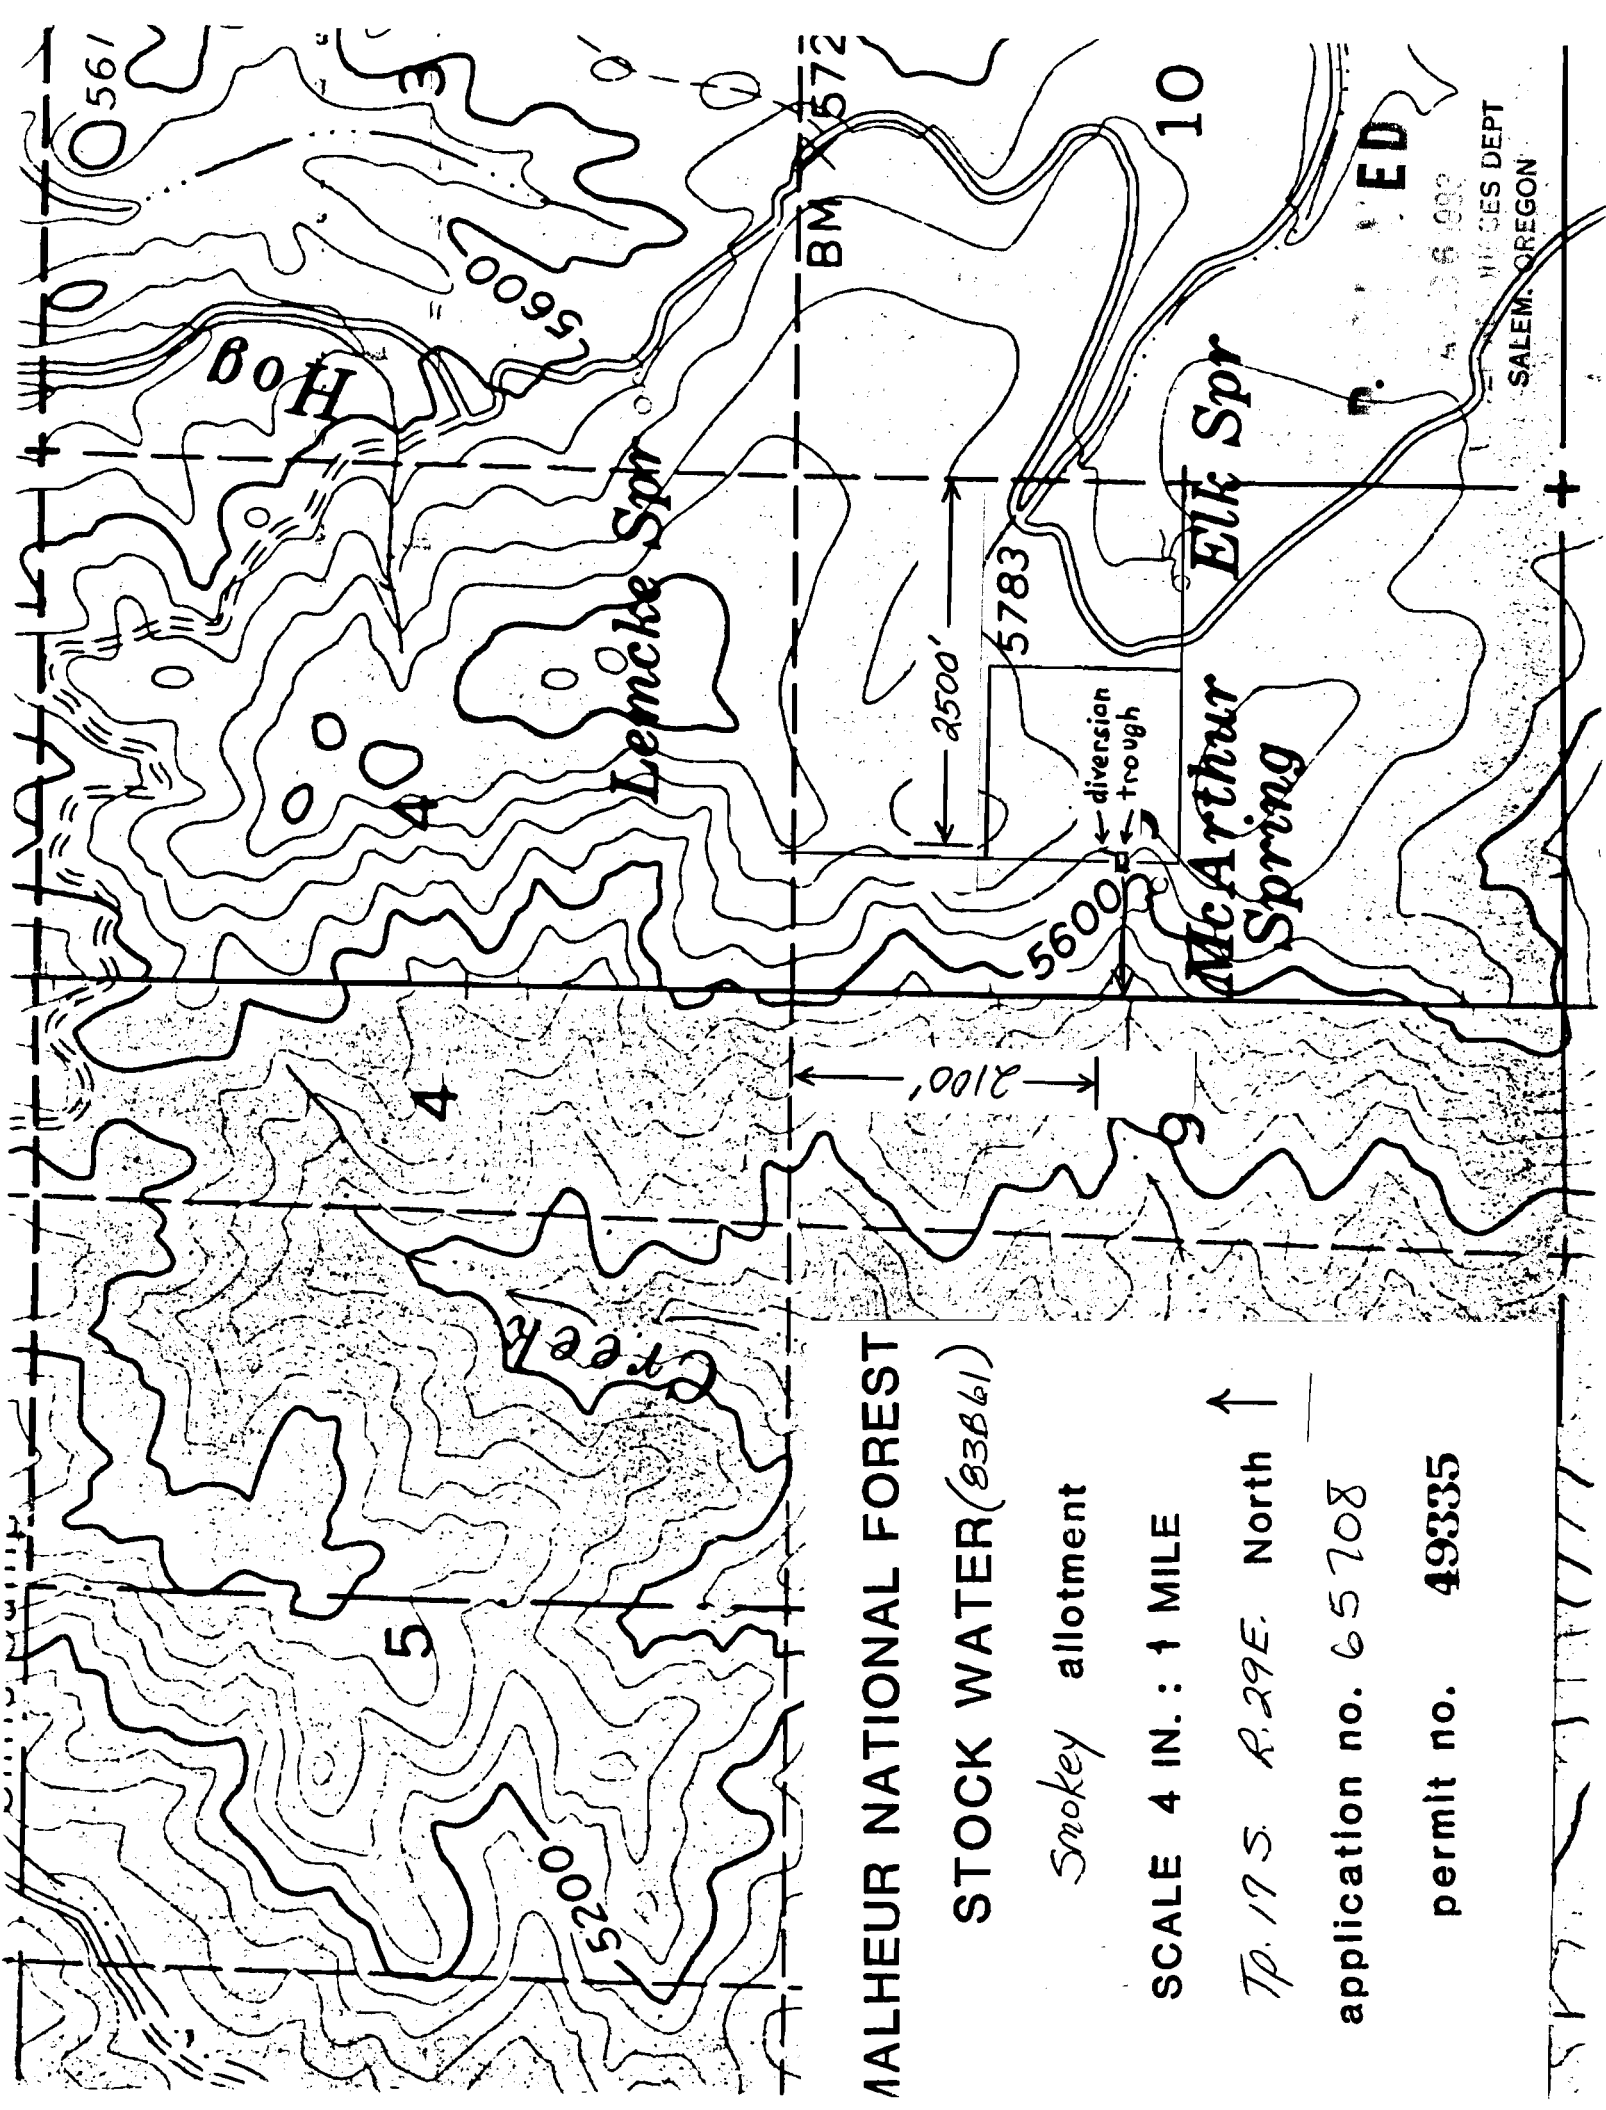

MALHEUR NATIONAL FOREST

STOCK WATER (83B61)

Snokey allotment

SCALE 4 IN. : 1 MILE

Tp. 17 S. R. 29 E. North ↑

application no. 65708

permit no. 49335

SALEM, OREGON