


*Elk Walloro
Spring*

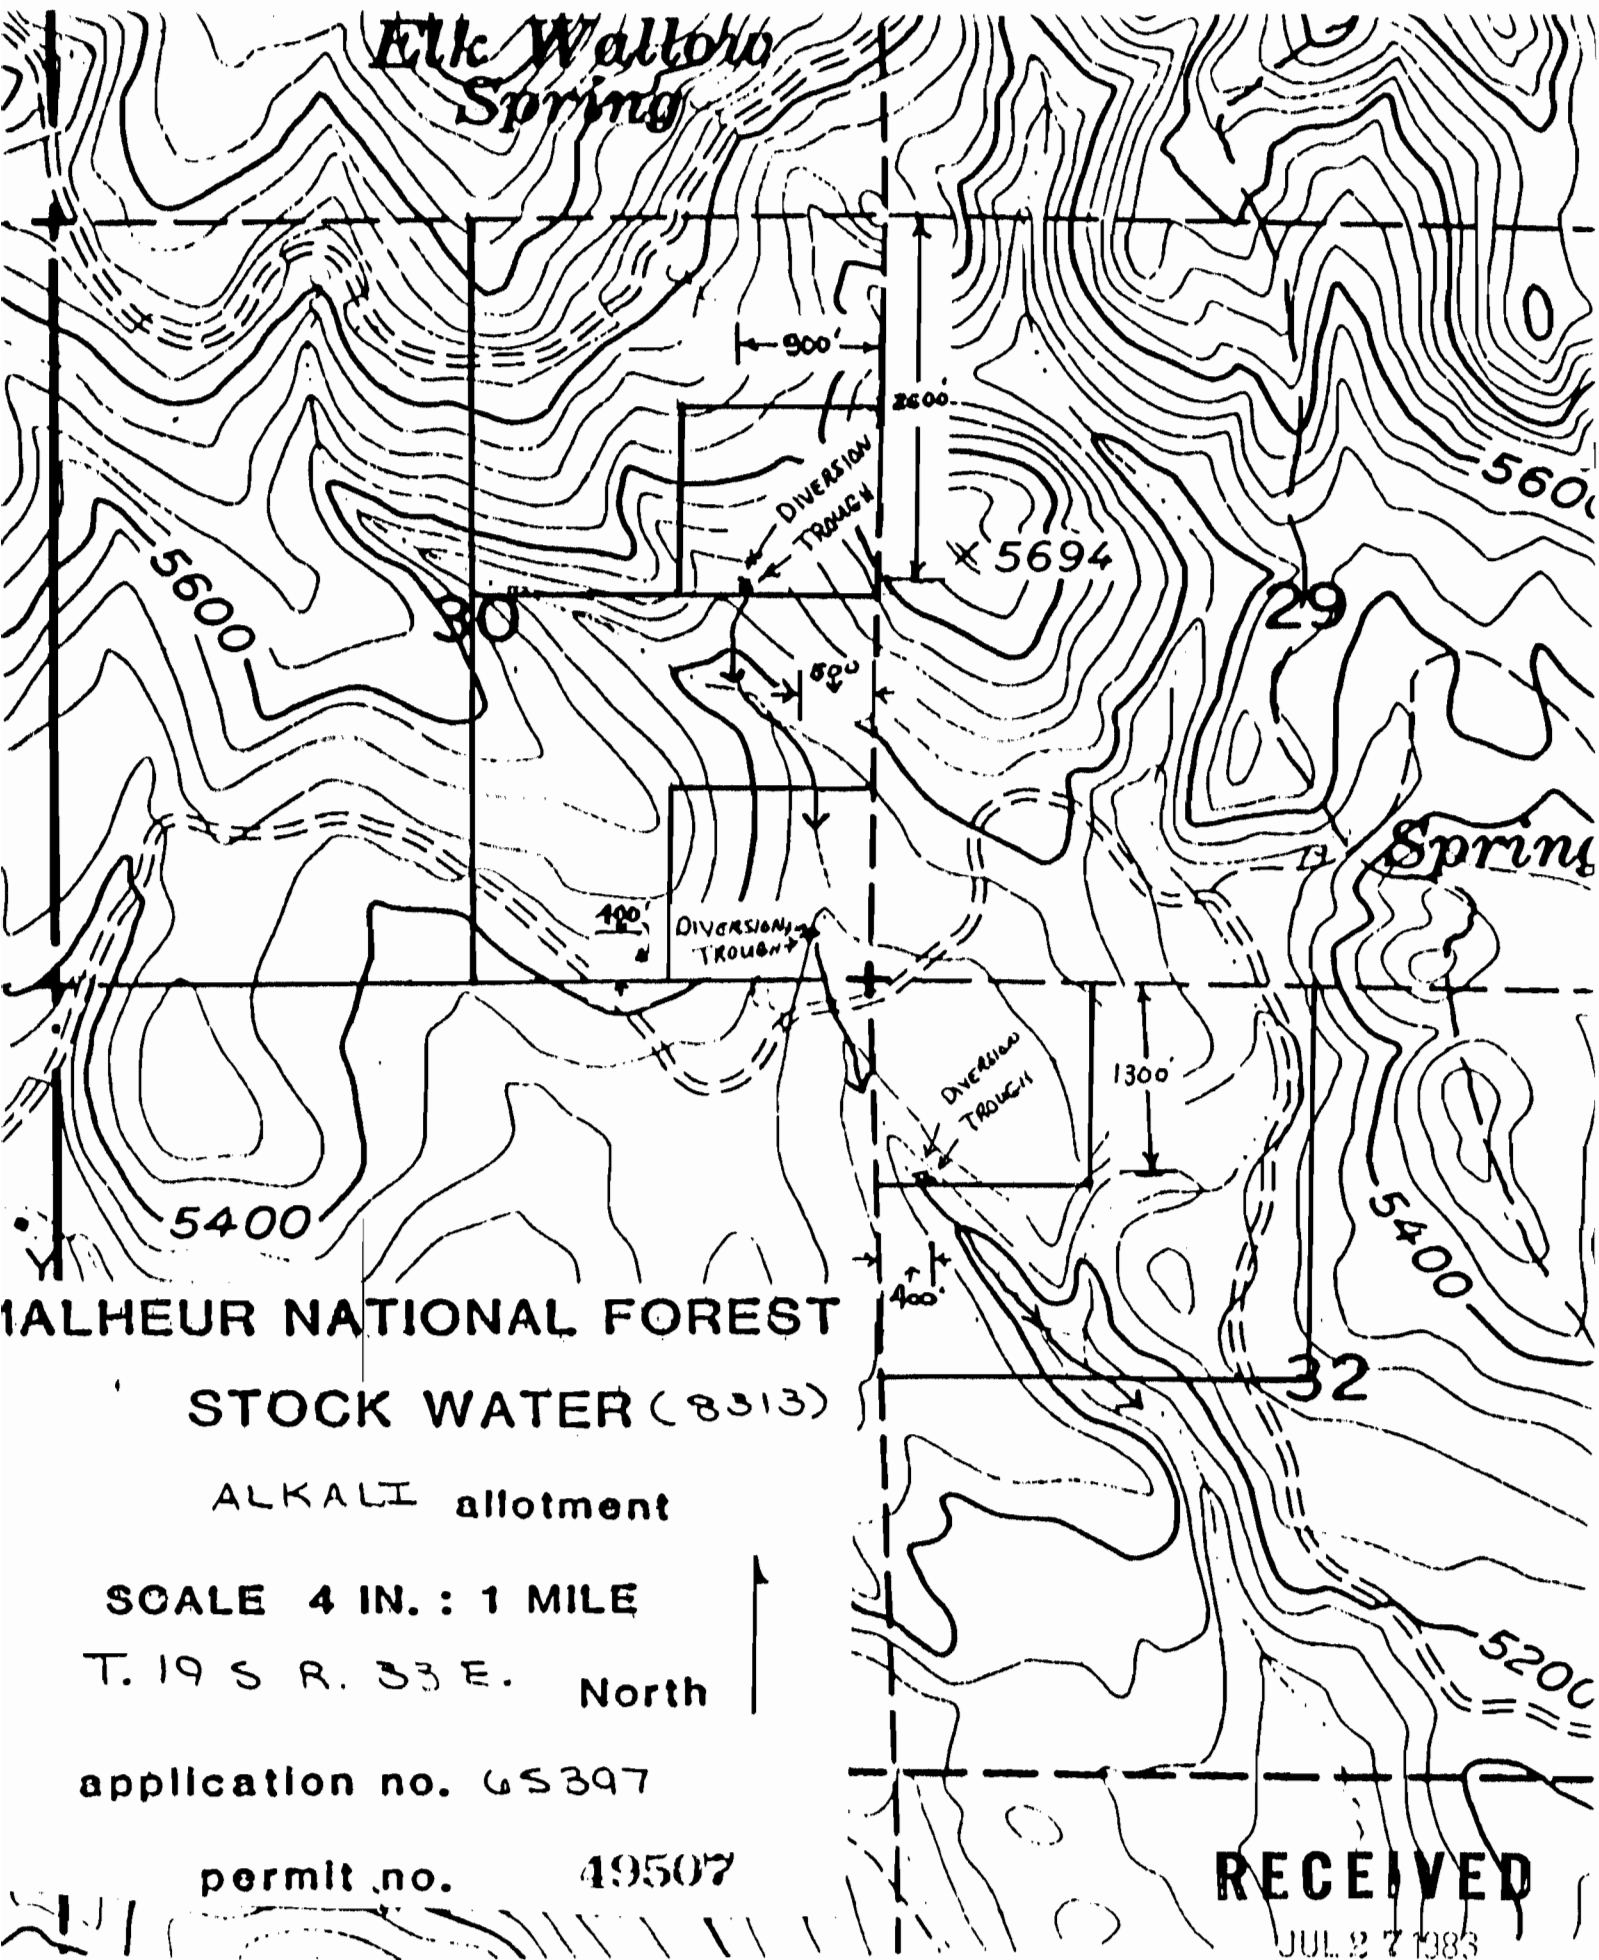

MALHEUR NATIONAL FOREST

STOCK WATER (8313)

ALKALI allotment

SCALE 4 IN. : 1 MILE

T. 19 S R. 33 E. North

application no. 65397

permit no. 49507

RECEIVED

JUL 27 1983

WATER RESOURCES DEPT.
SALEM, OREGON