


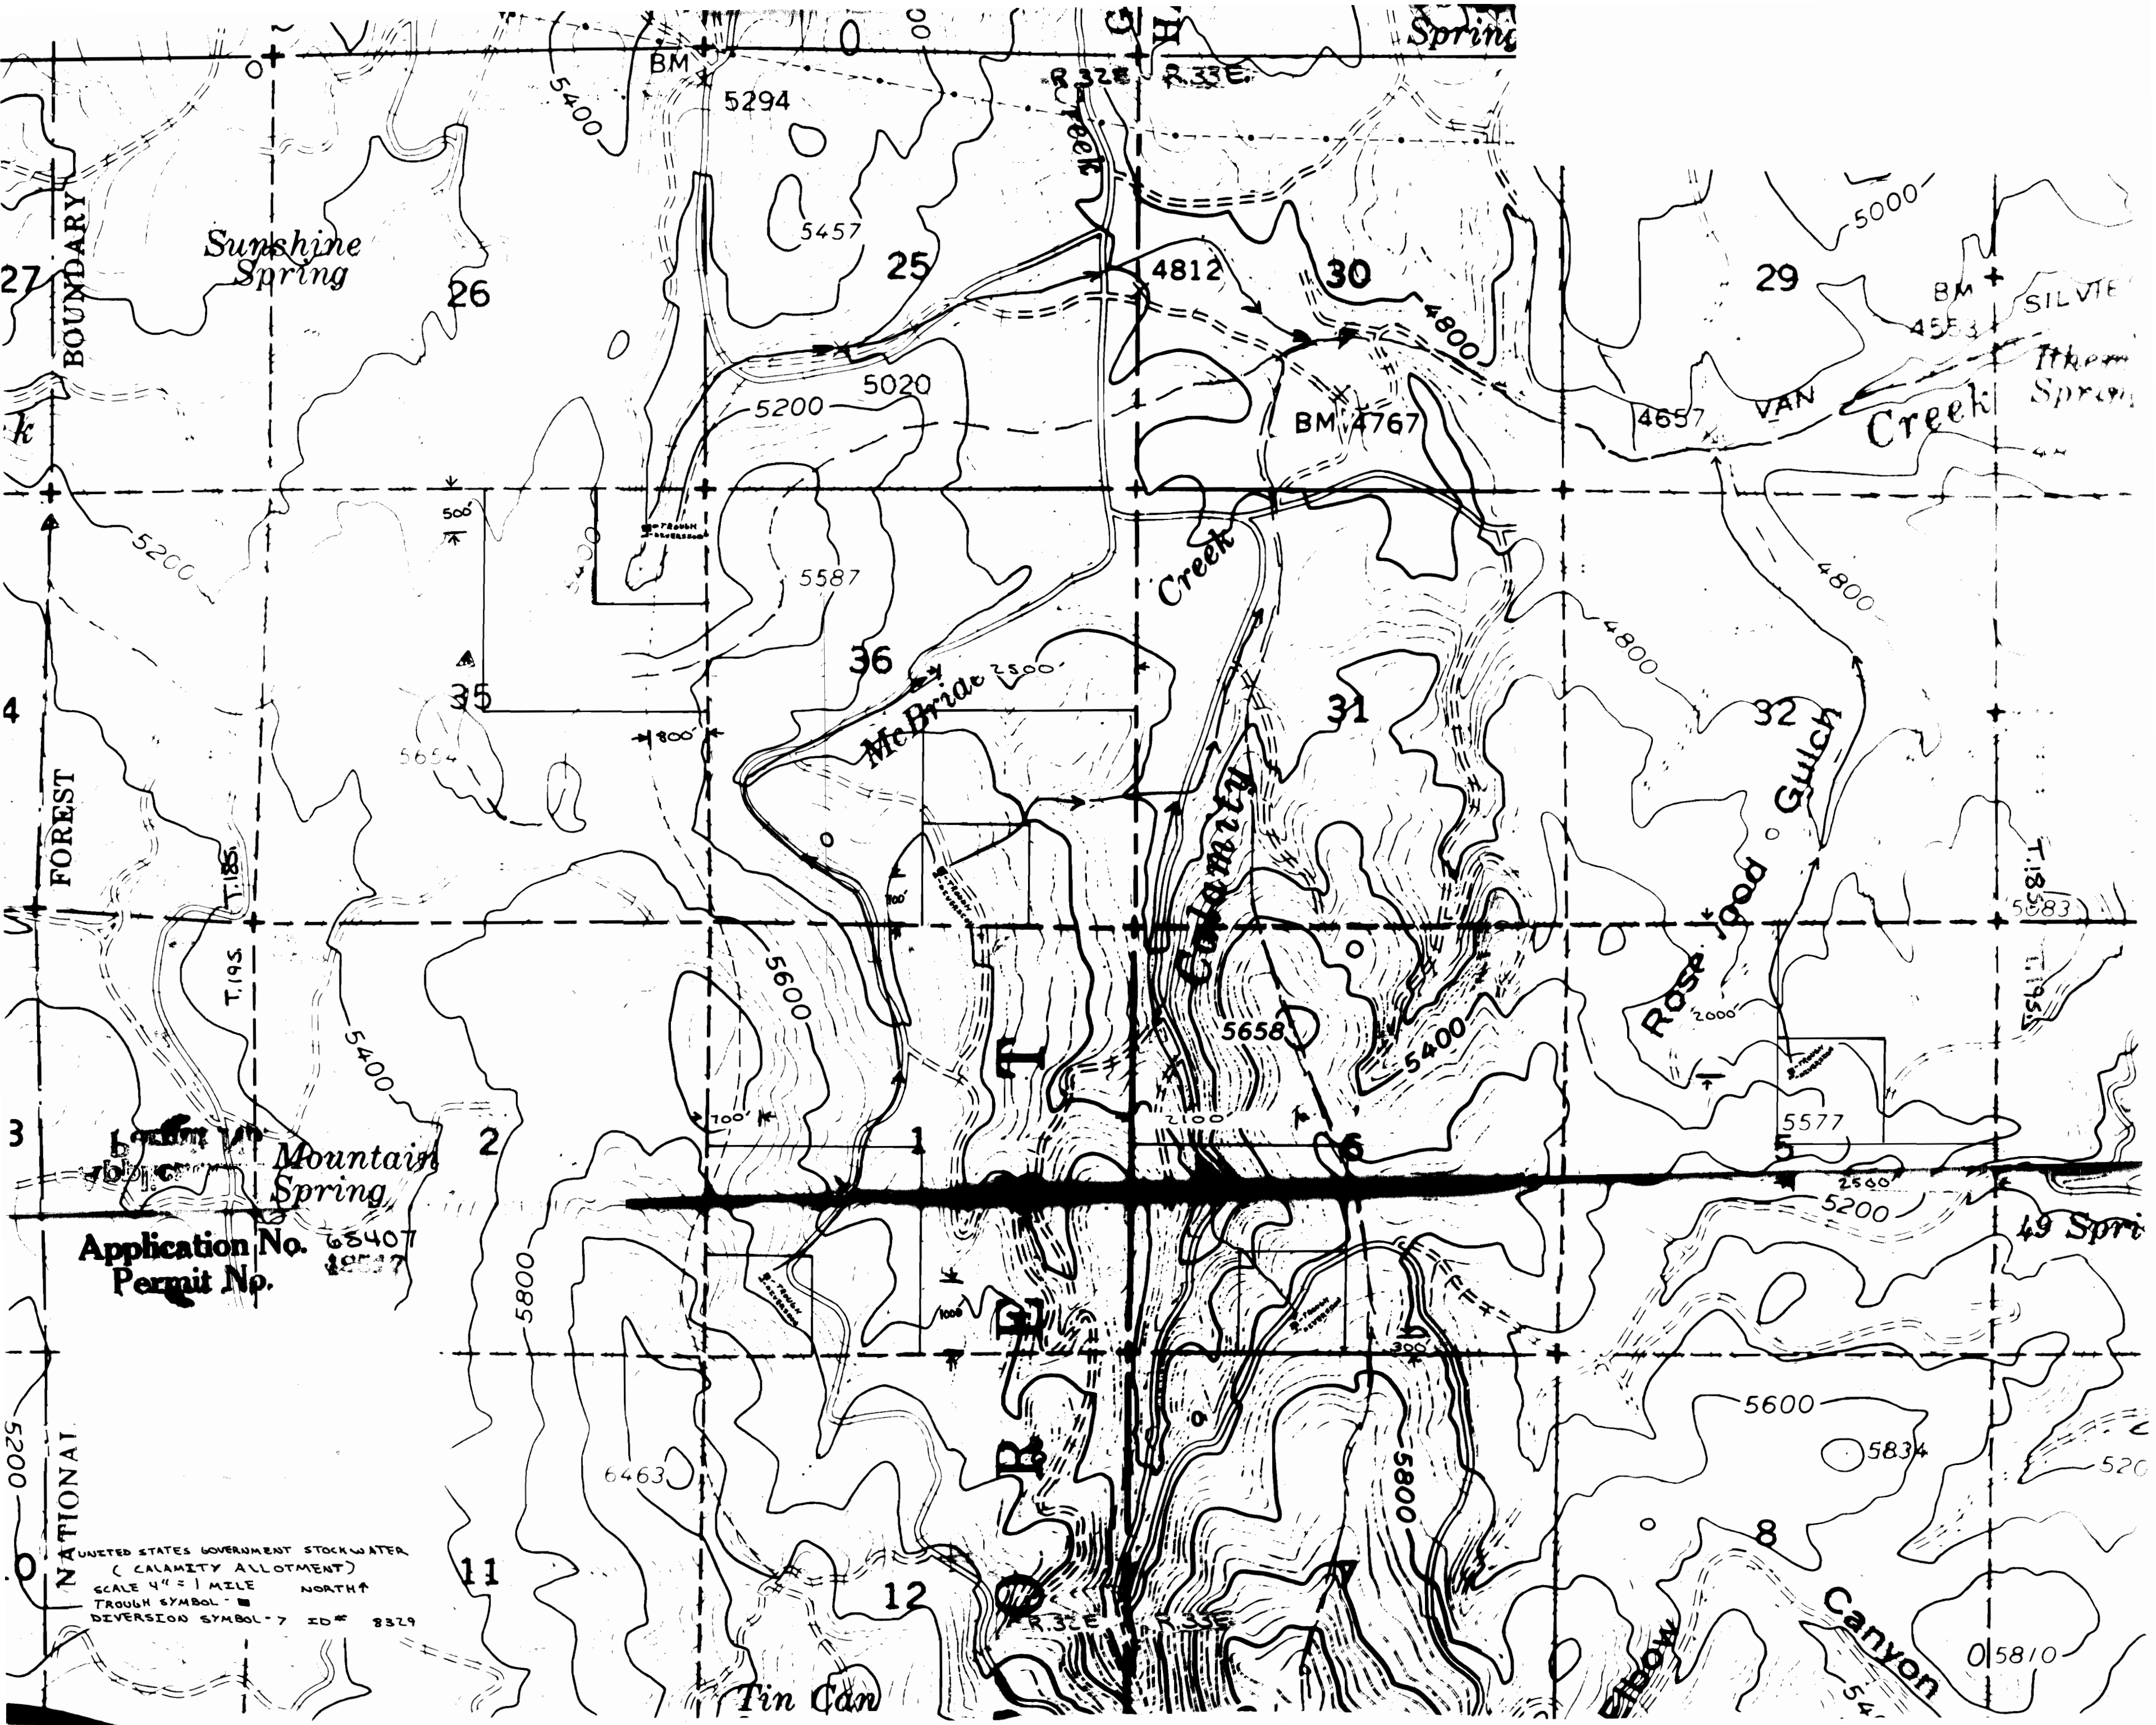

Application No. 68407
Permit No. 18537

UNITED STATES GOVERNMENT STOCKWATER
(CALAMITY ALLOTMENT)
SCALE 4" = 1 MILE NORTH ↑
TROUGH SYMBOL - ■
DIVERSION SYMBOL - 7 ID# 8329