


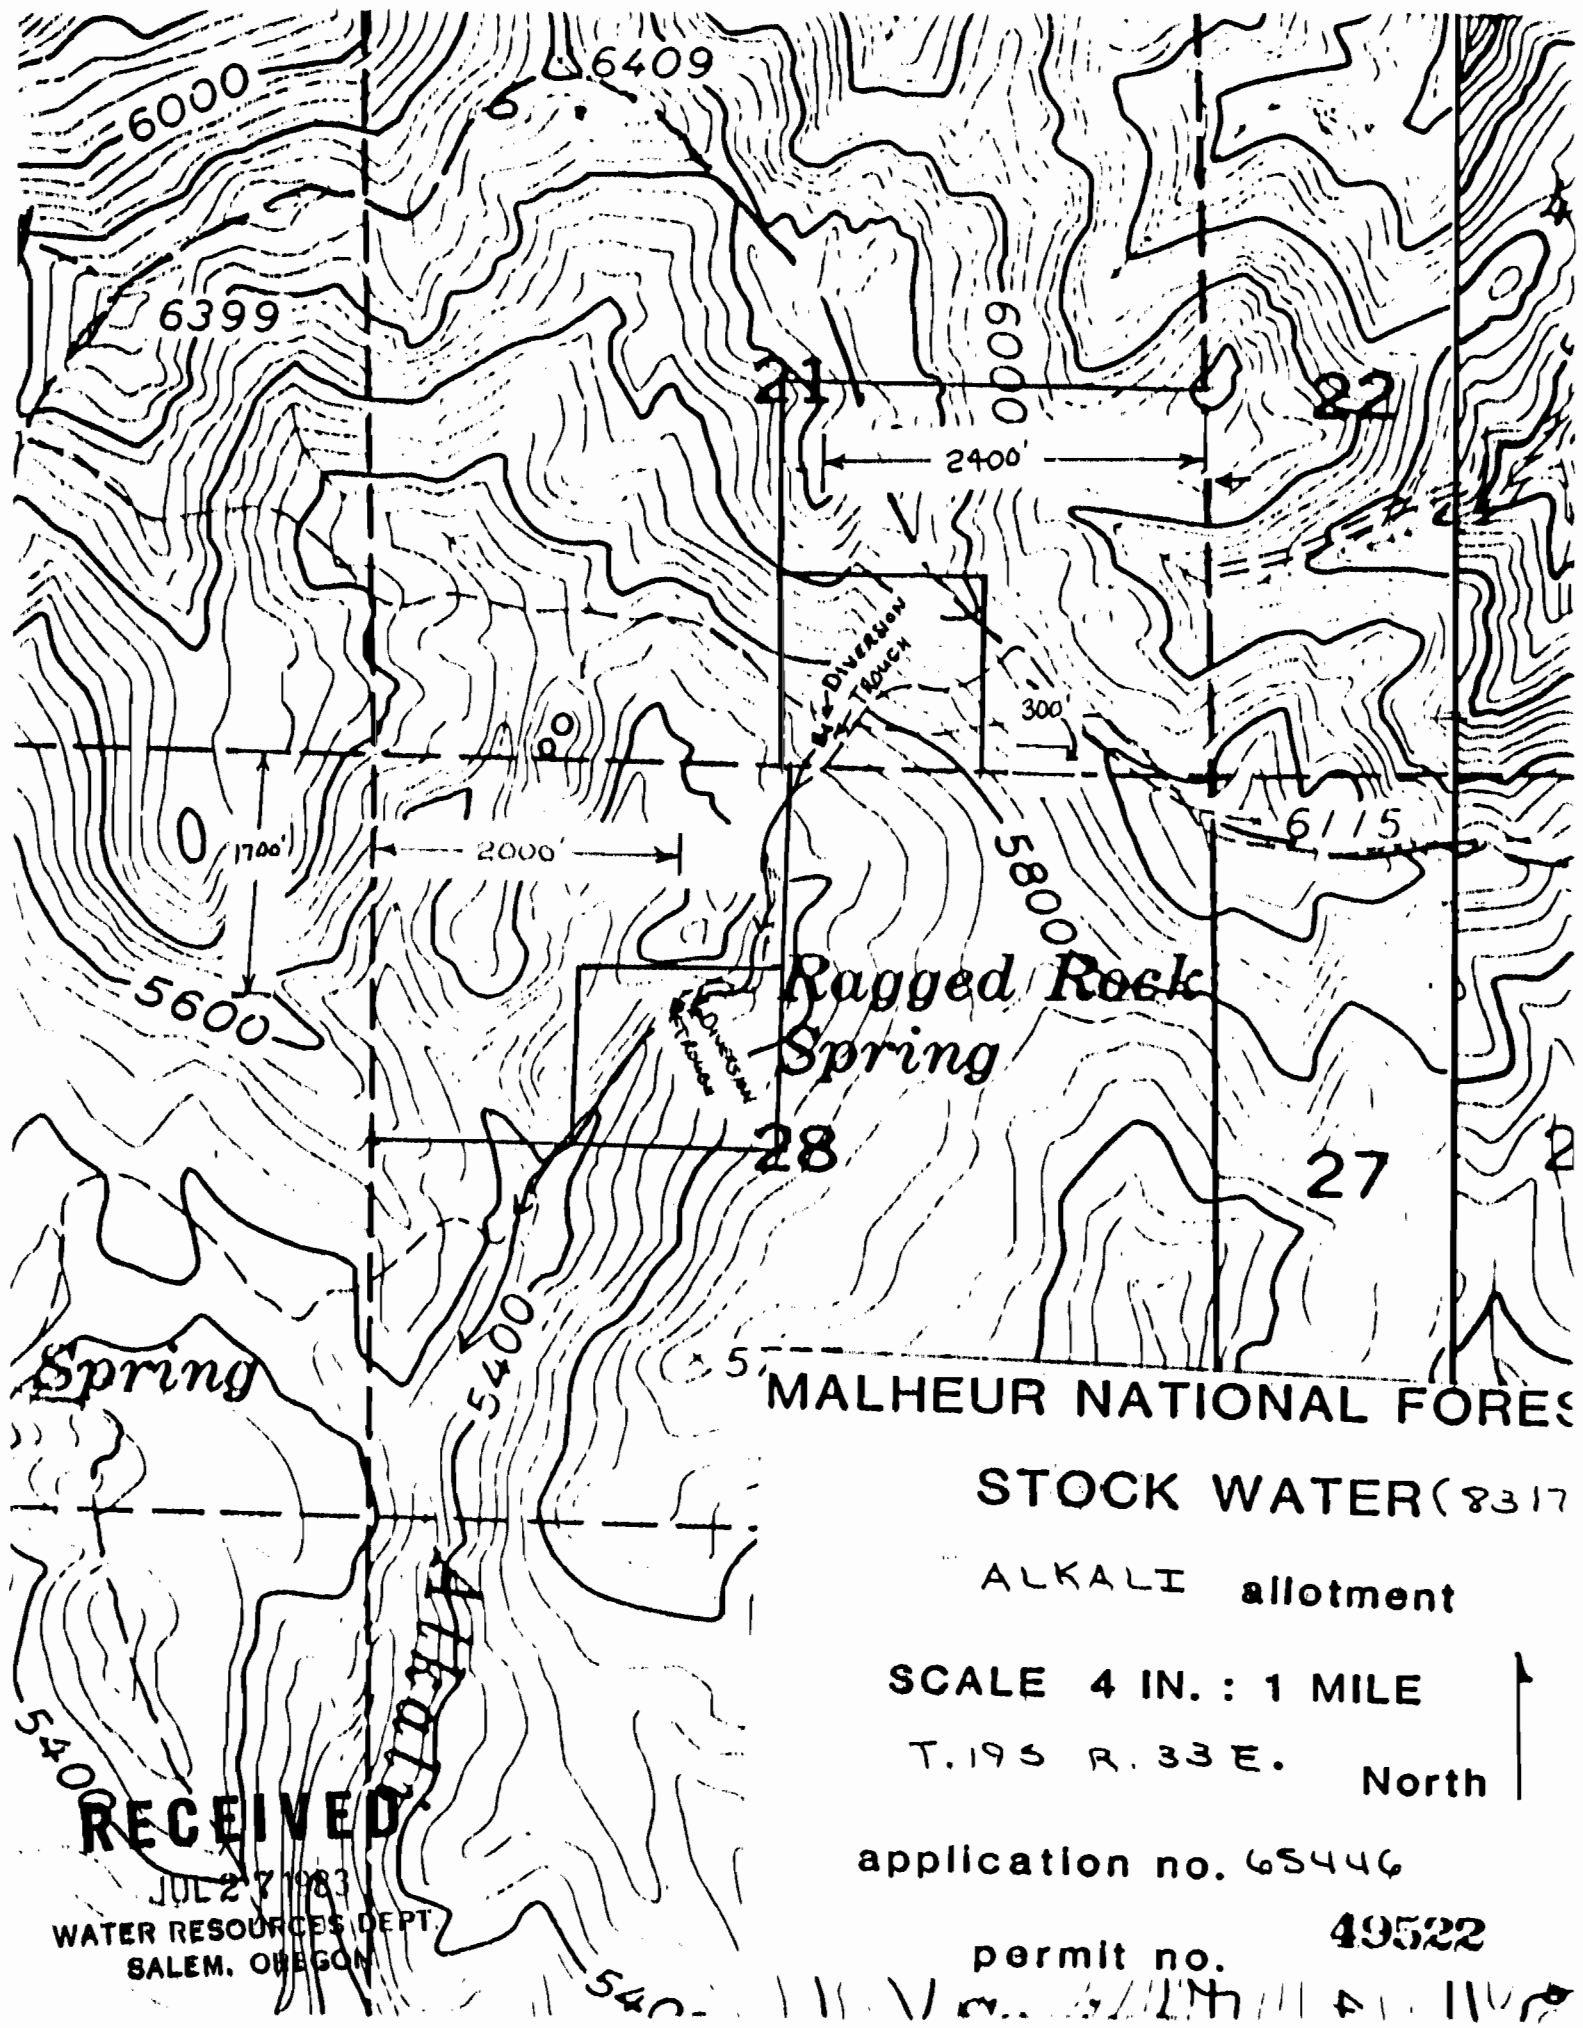

MALHEUR NATIONAL FOREST

STOCK WATER (8317)

ALKALI allotment

SCALE 4 IN. : 1 MILE

T. 19 S R. 33 E. North

application no. 65446

permit no. 49522

RECEIVED
JUL 27 1983
WATER RESOURCES DEPT.
SALEM, OREGON