


STOCK WATER (83178)

ALKALI allotment


SCALE 4 IN. : 1 MILE

T. 19 S R. 33 E.

North

application no. 65447

permit no. 49523

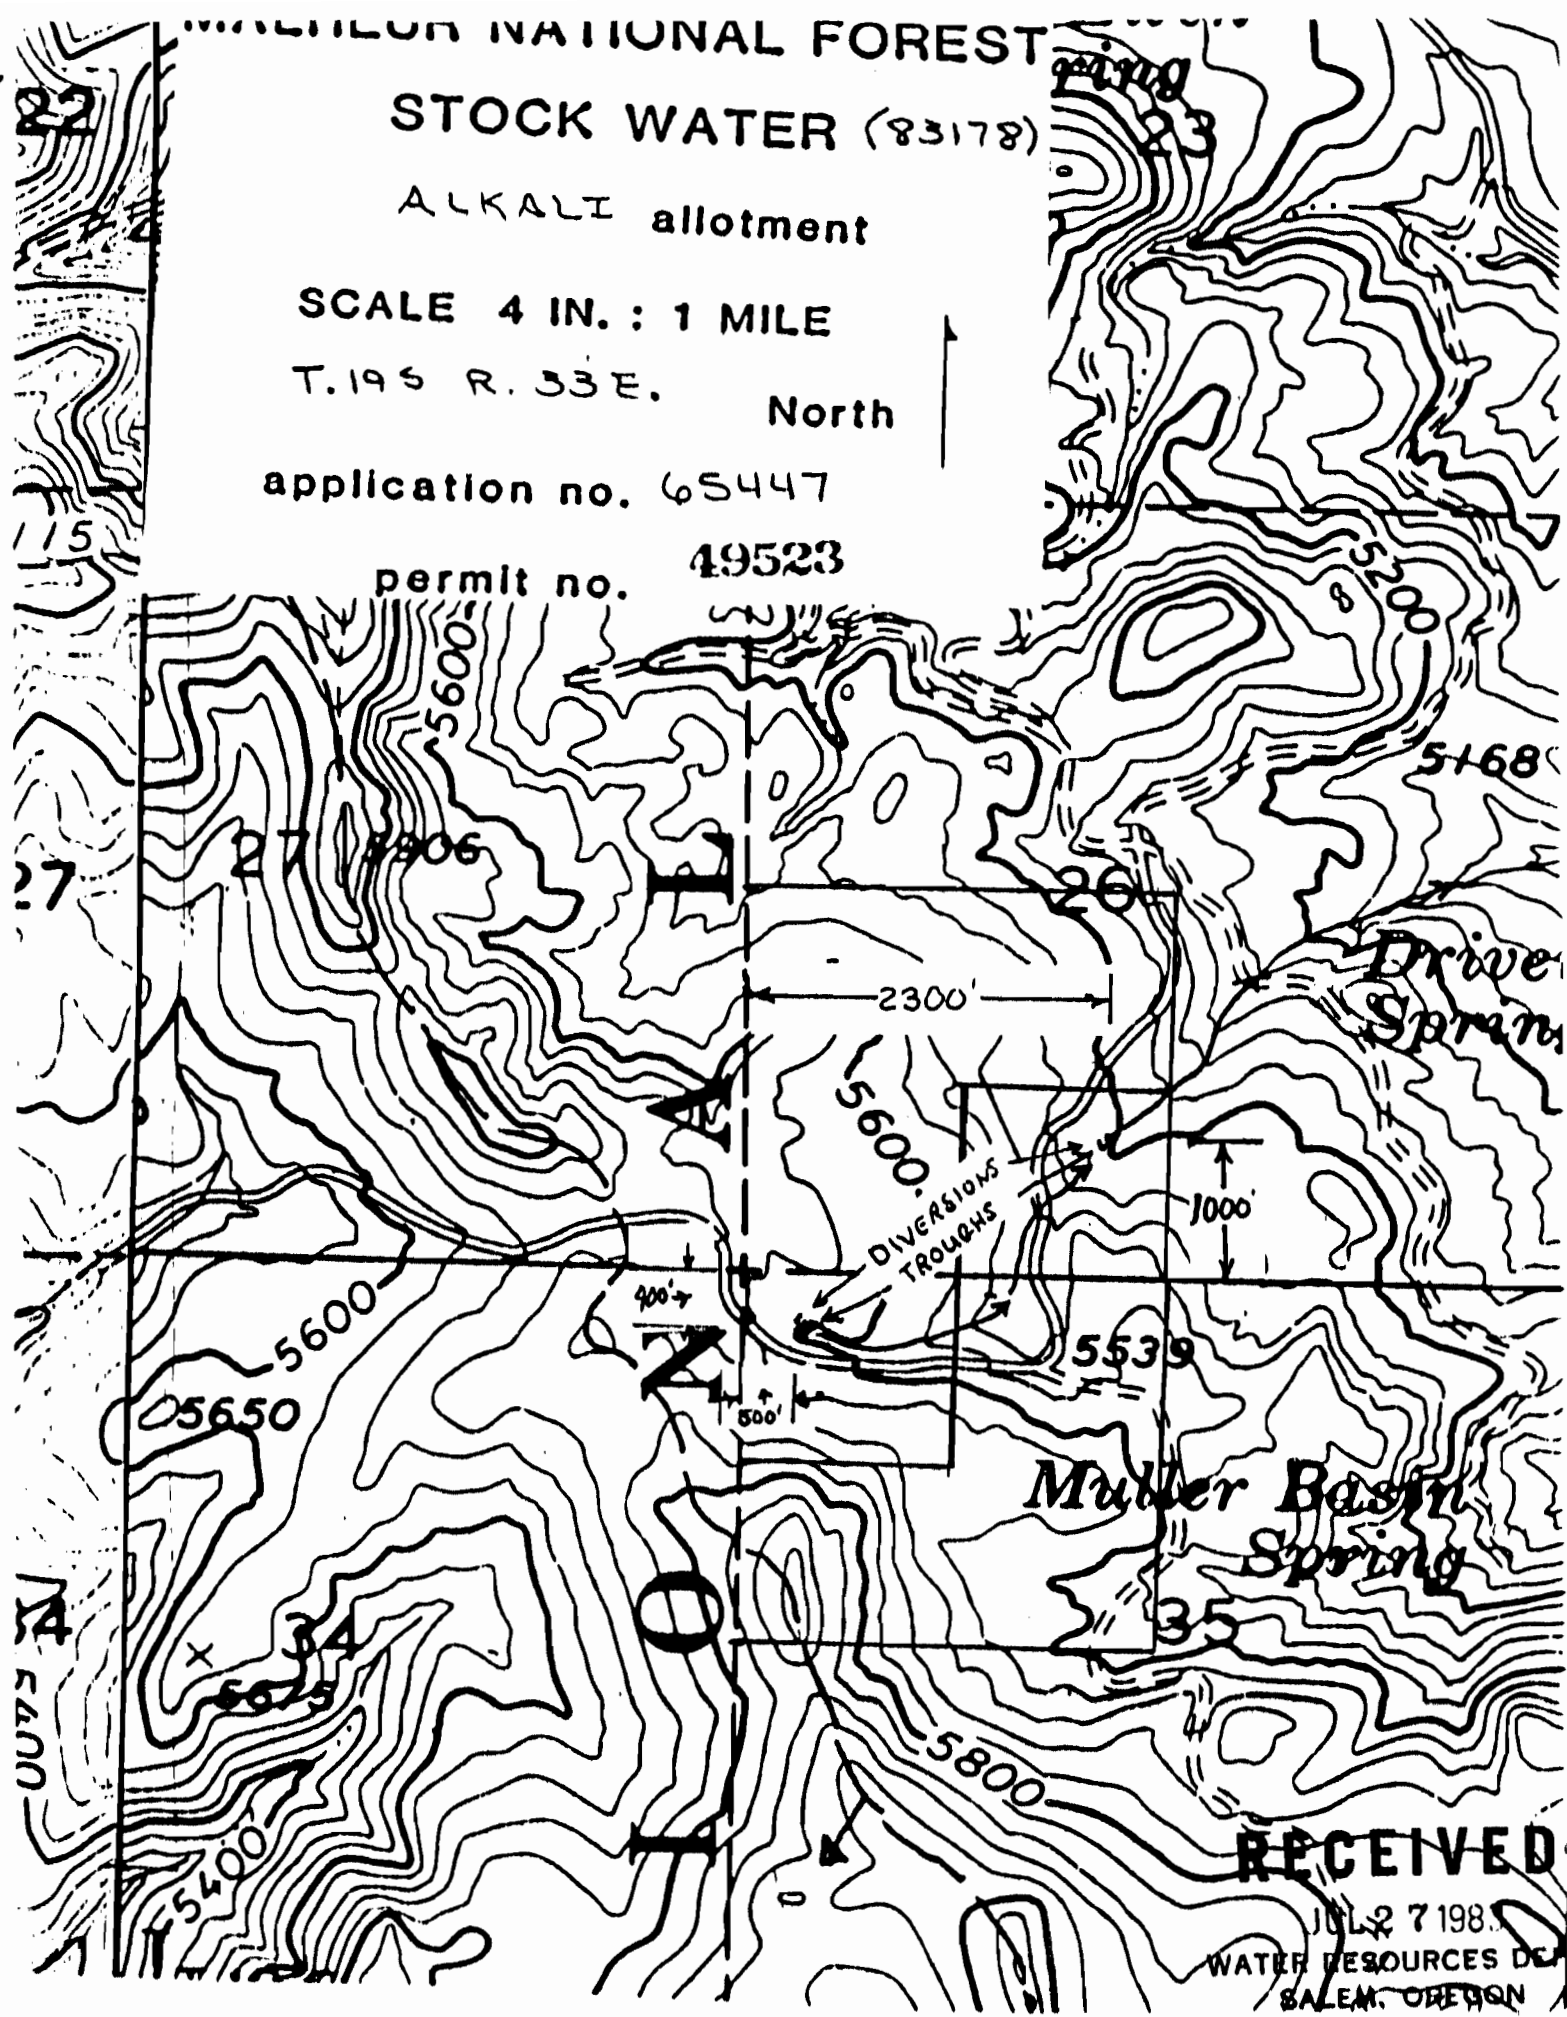

RECEIVED

JUL 27 1985

WATER RESOURCES DEPT
SALEM, OREGON