


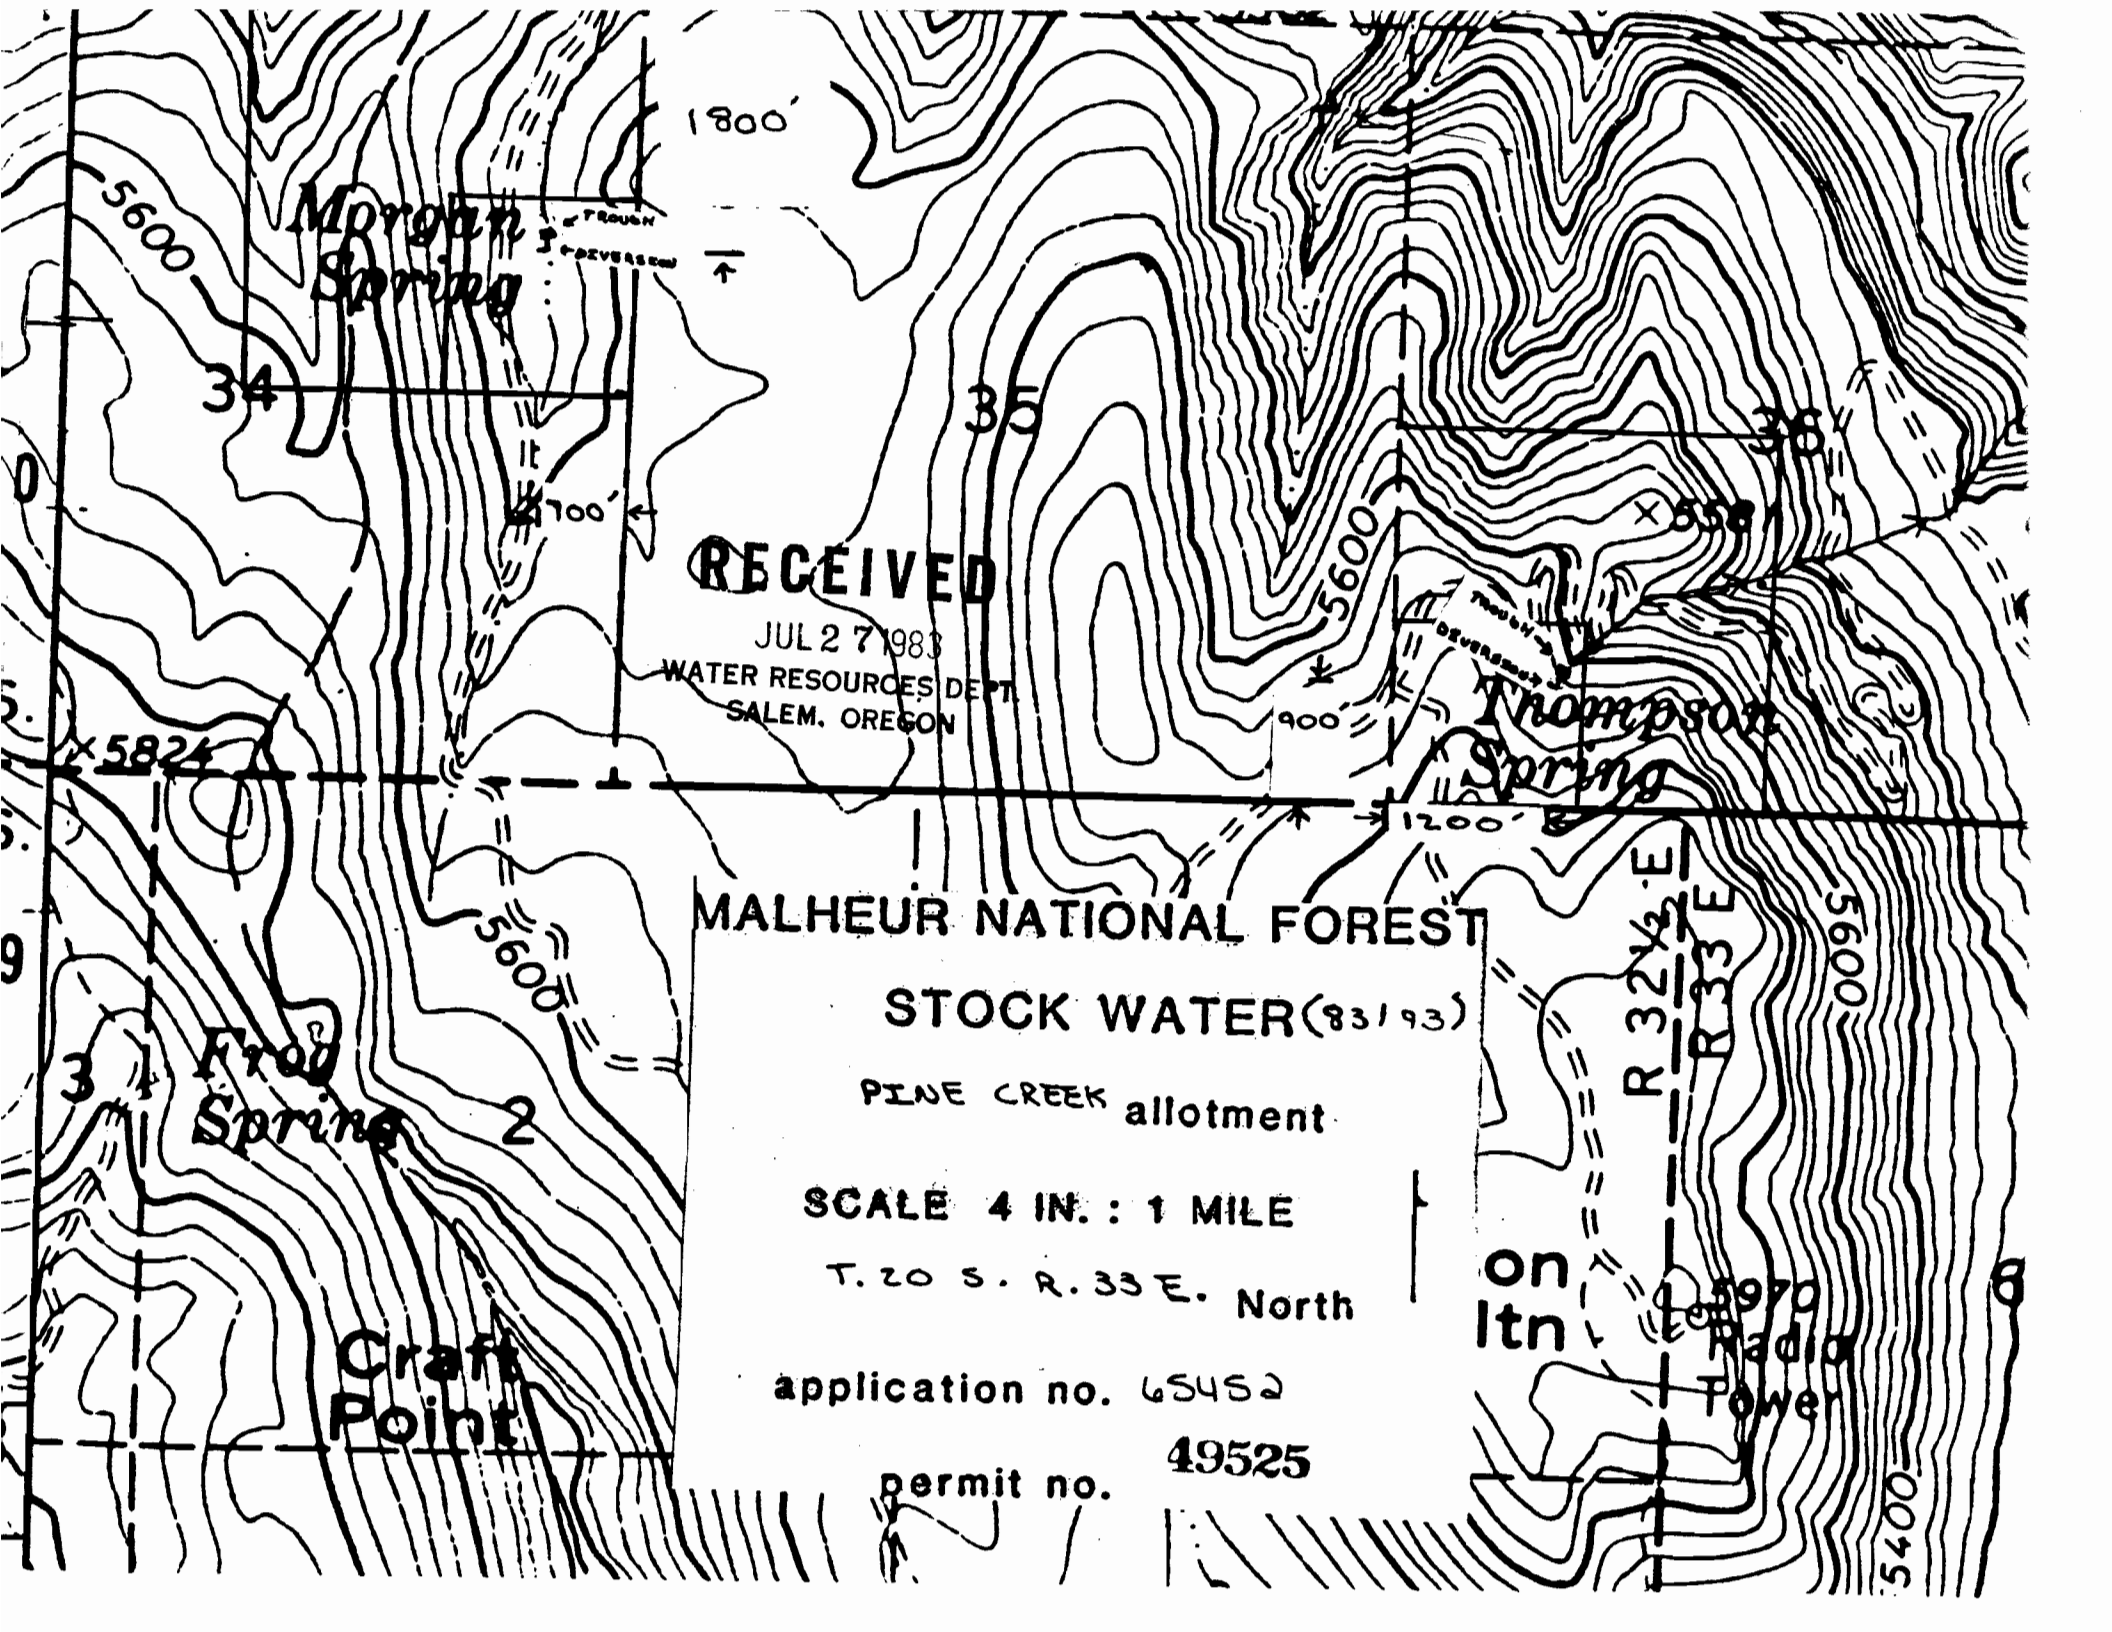

RECEIVED

JUL 27 1983

WATER RESOURCES DEPT.
SALEM, OREGON

MALHEUR NATIONAL FOREST

STOCK WATER (83193)

PINE CREEK allotment

SCALE 4 IN. : 1 MILE

T. 20 S. R. 33 E. North

application no. 65452

permit no. 49525

Morgan Spring

Thompson Spring

Frog Spring

Craft Point

on ltn

Radio Tower