


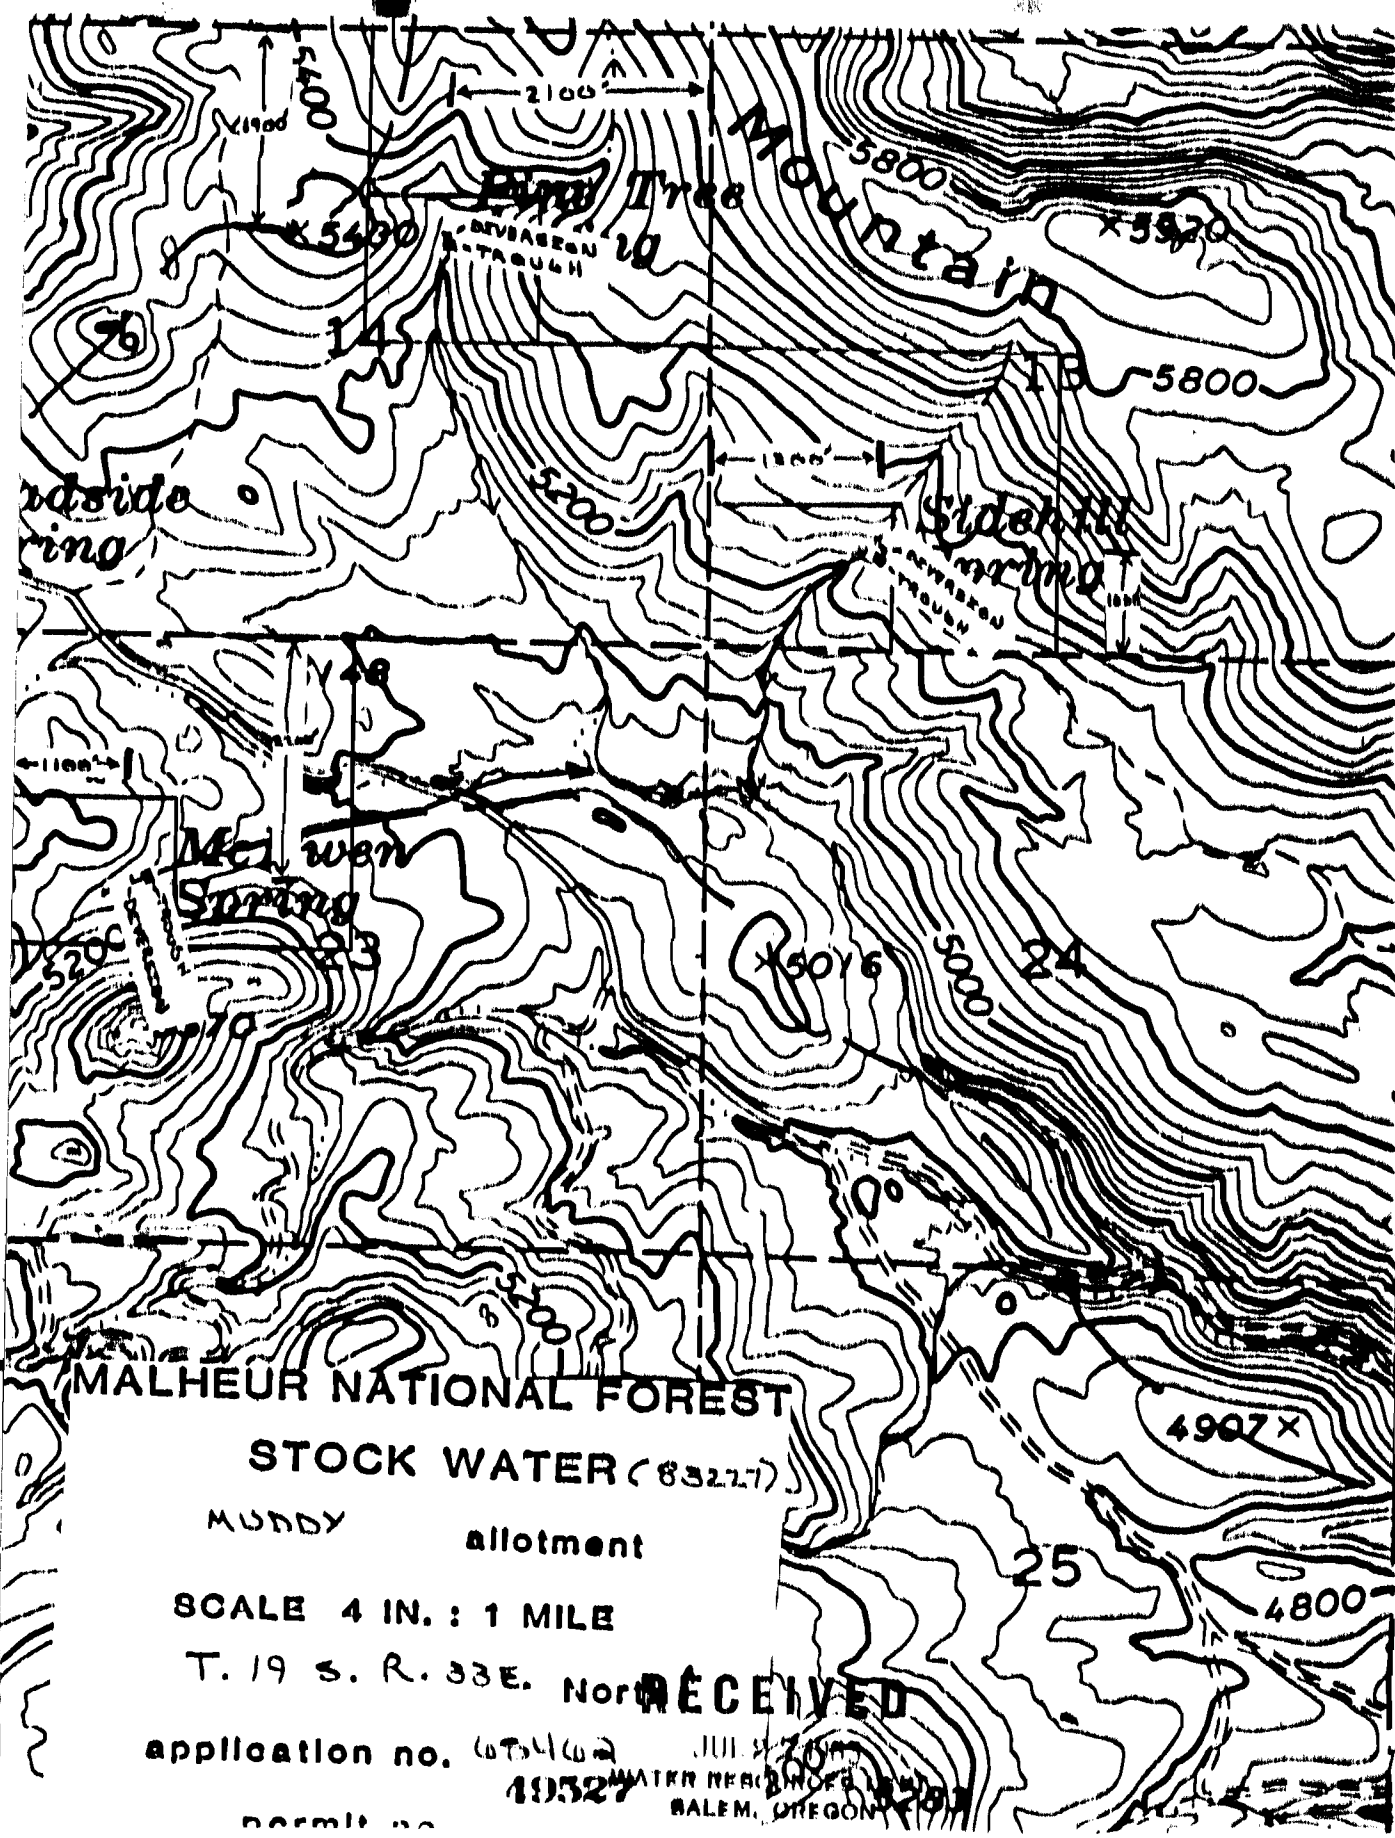

MALHEUR NATIONAL FOREST

STOCK WATER (83227)

MUDDY allotment

SCALE 4 IN. : 1 MILE

T. 19 S. R. 33 E. North

application no. 675462

19527

RECEIVED

JUL 27 1952
WATER RESOURCES DIVISION
SALEM, OREGON