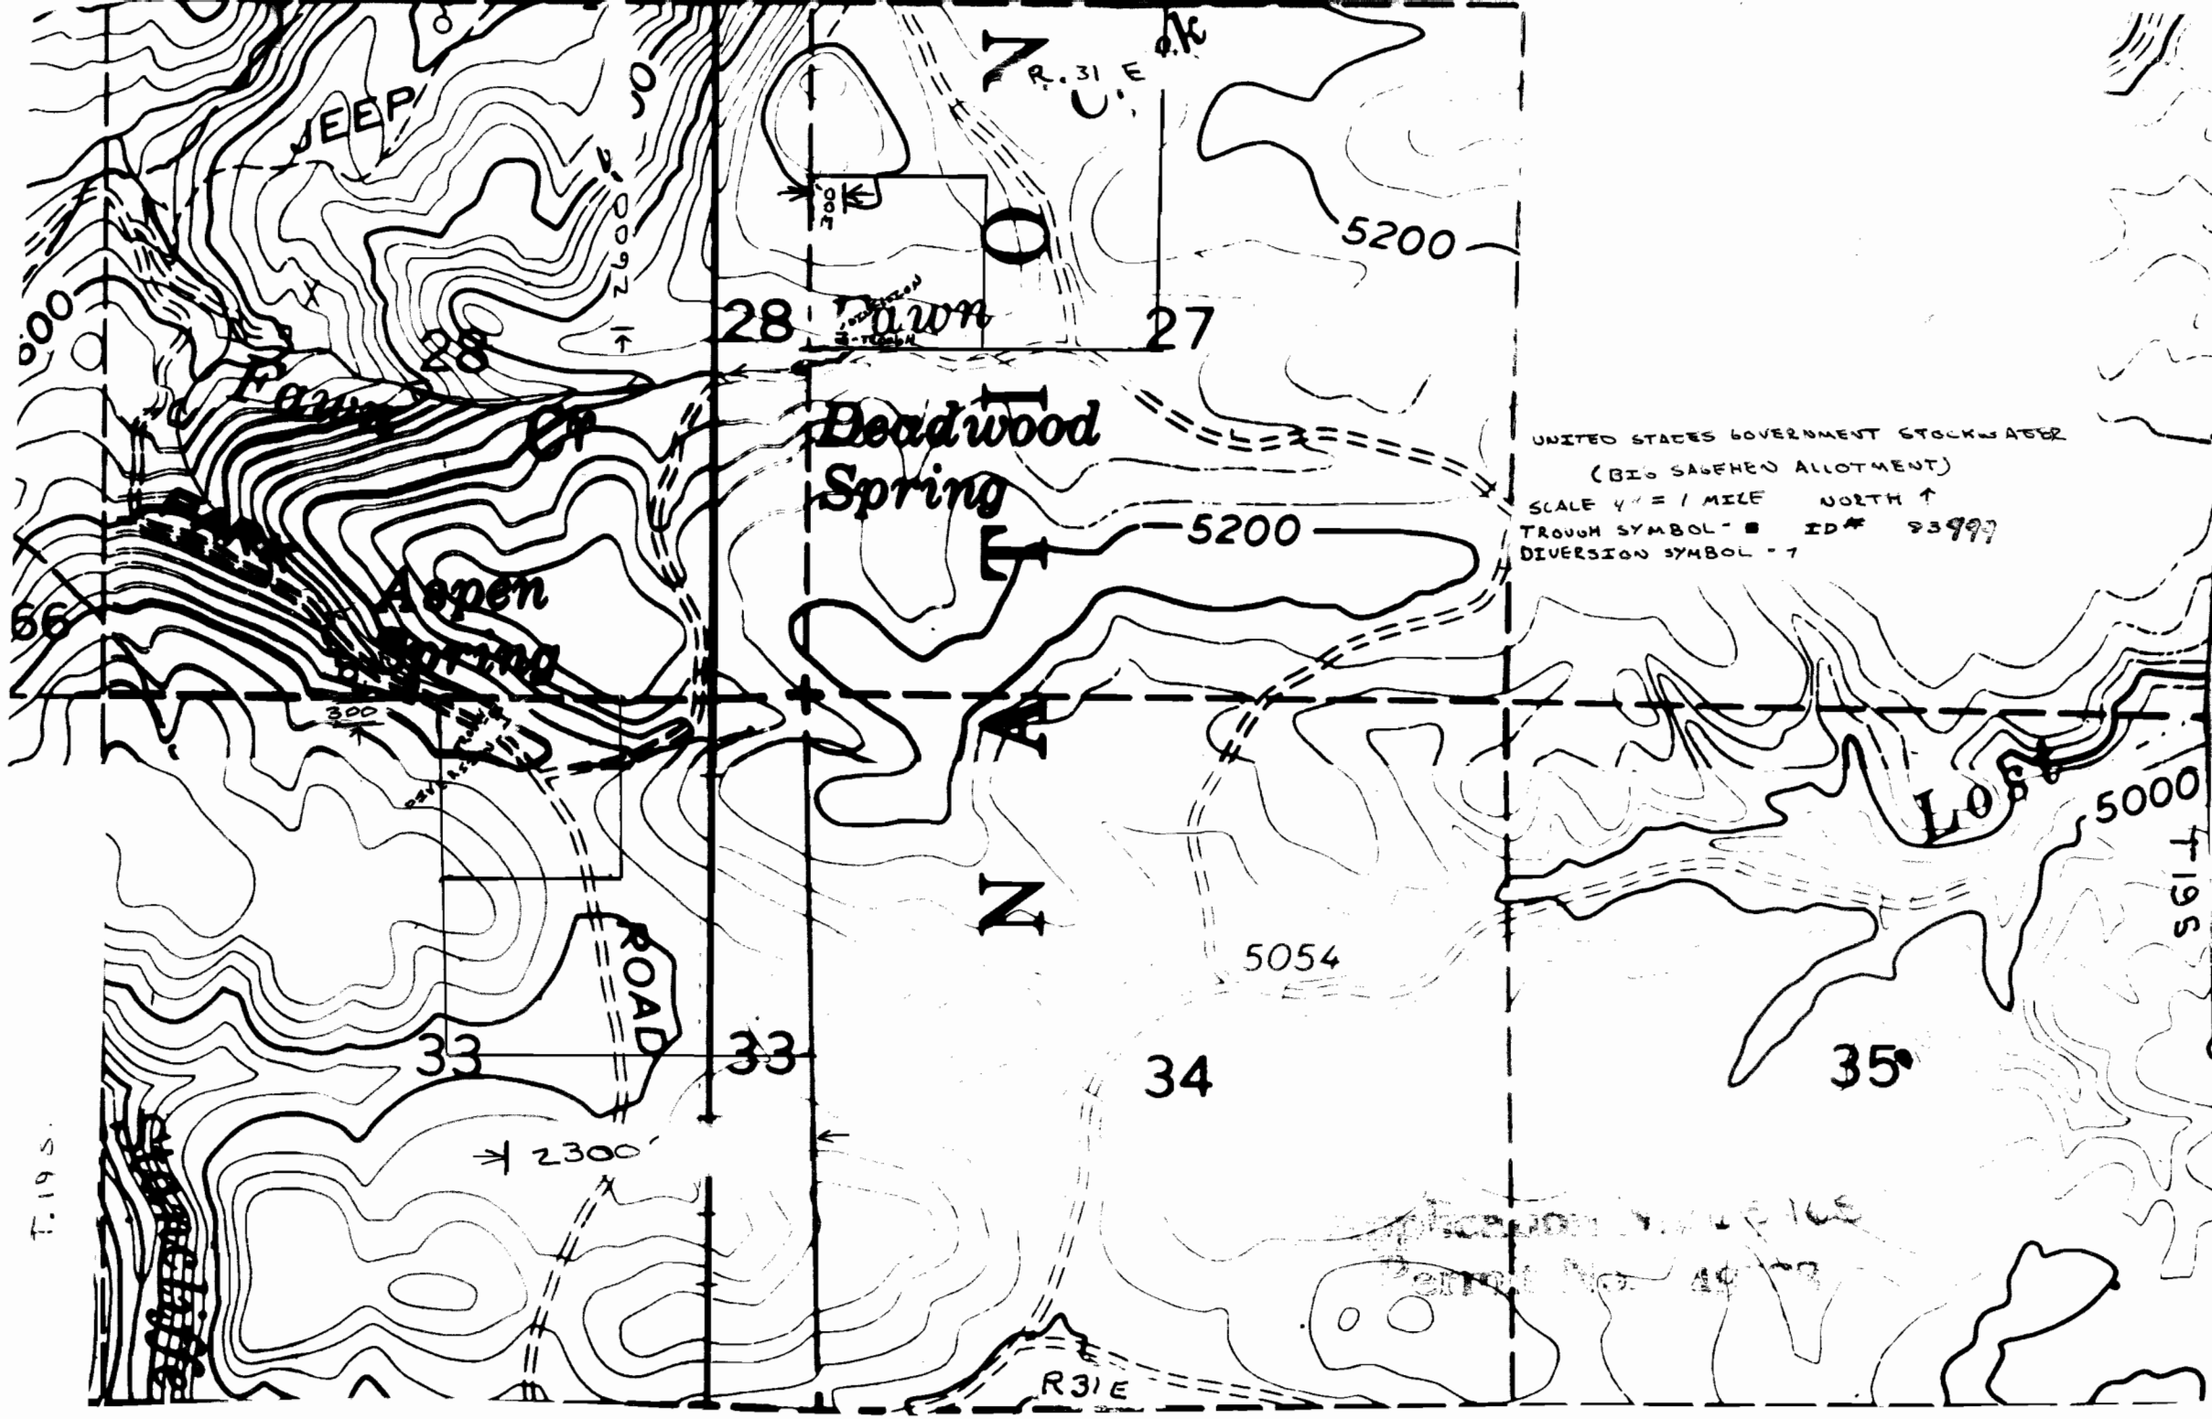
JEEP
Dawn
28
Deadwood Spring
Aspen Spring
300
5200
5200
5000
5054
ROAD
33
33
34
35
2300'
T. 19 S.
R. 31 E.
R31E
UNITED STATES GOVERNMENT STOCKWATER
(BIG SAGEHEN ALLOTMENT)
SCALE 4" = 1 MILE NORTH ↑
TROUGH SYMBOL - ■ ID# 83999
DIVERSION SYMBOL - ↑