


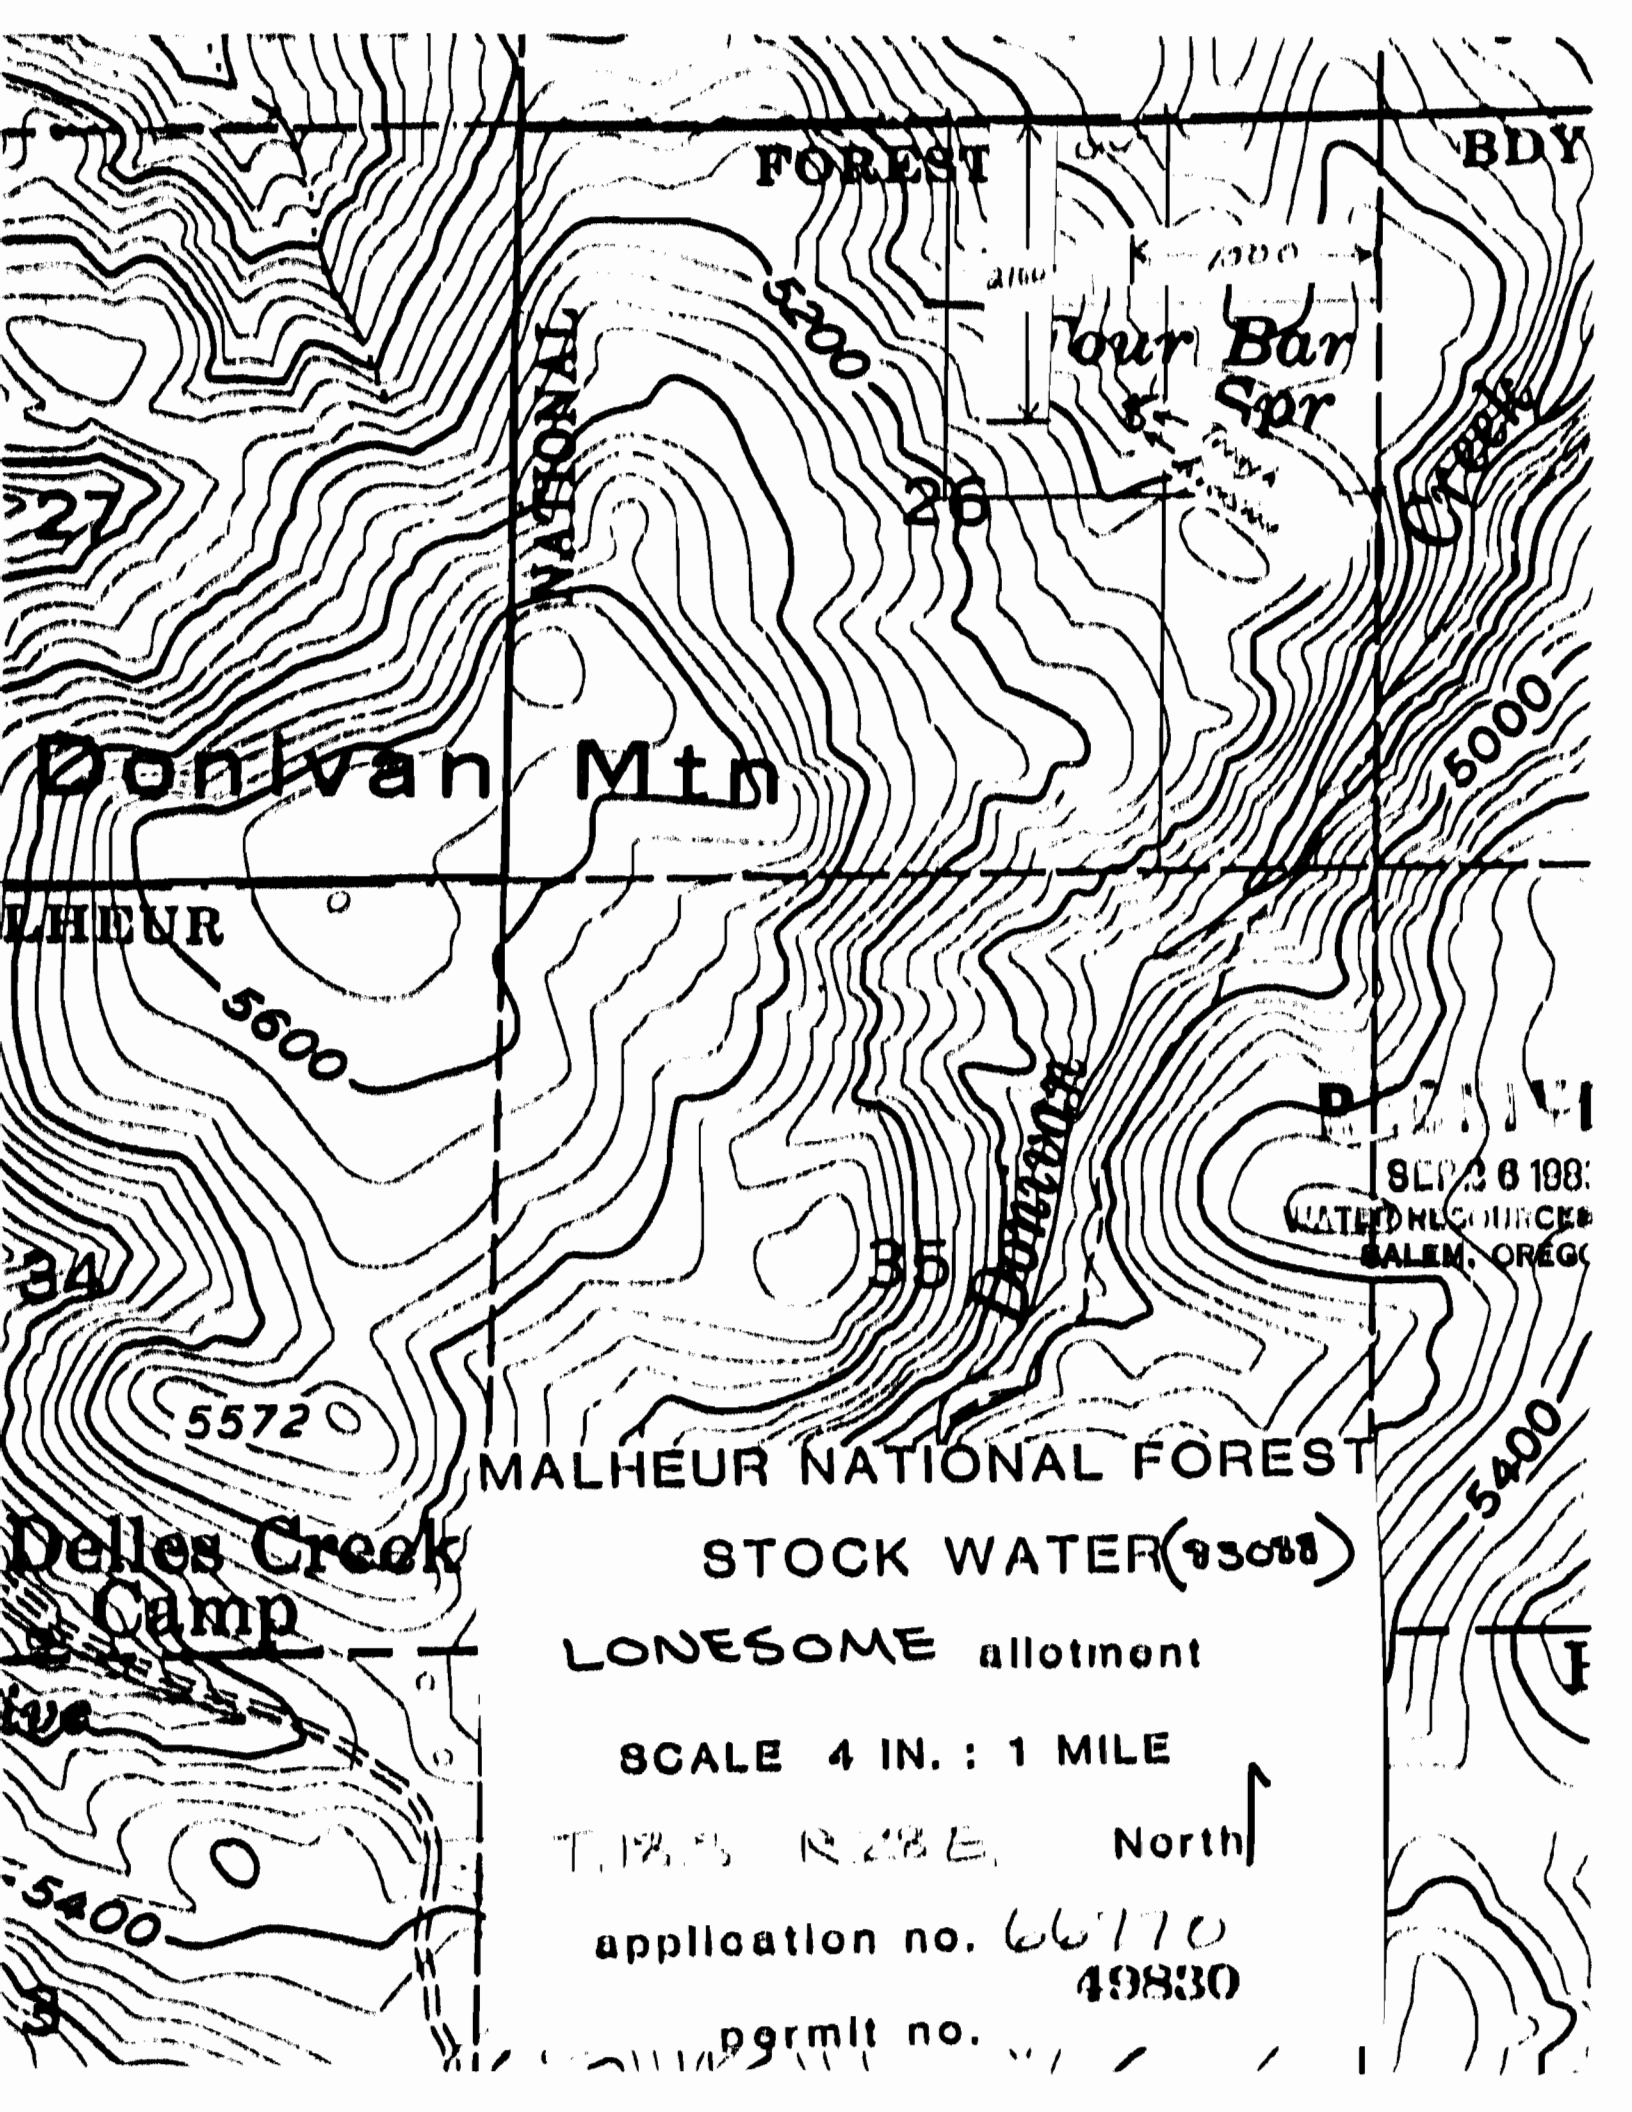

FOREST

BDY

Four Bar Spr

Donivan Mtn

MALHEUR

SEP 26 1981

WATER RESOURCES
SALEM, OREG

MALHEUR NATIONAL FOREST

STOCK WATER (93088)

LONESOME allotment

SCALE 4 IN. : 1 MILE

T. 12 S. R. 28 E. North

application no. 66770
49830

permitt no.