


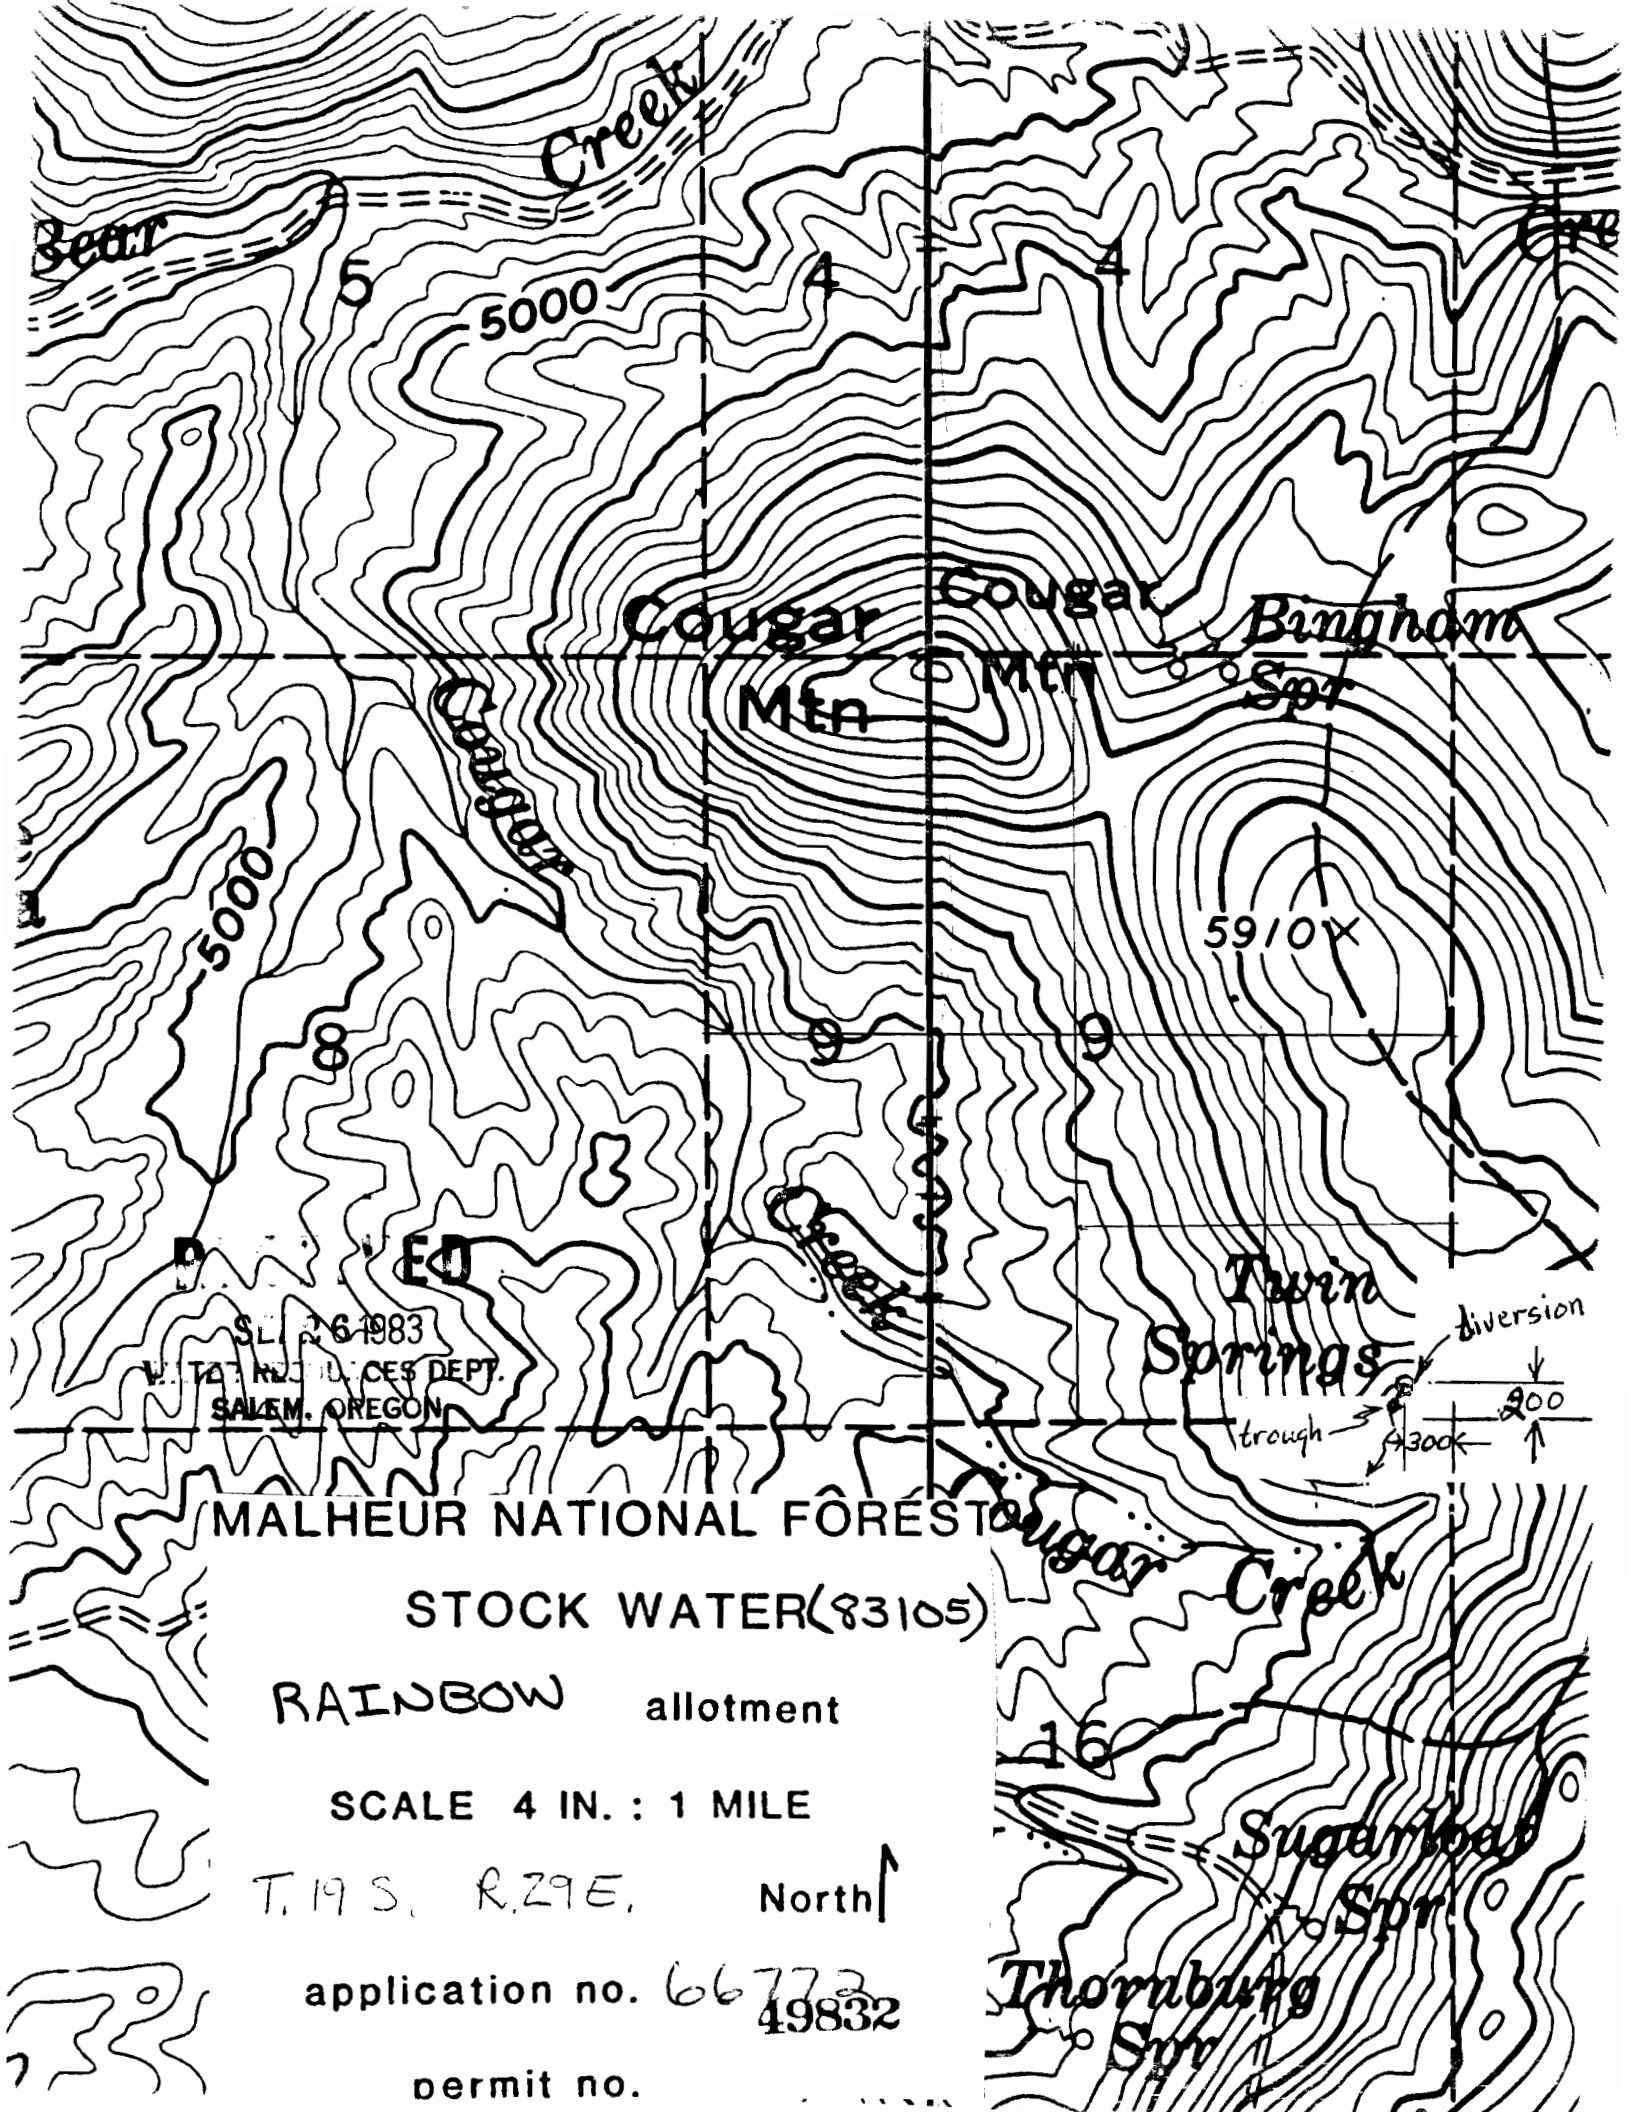

SL 26 1983
W. T. H. J. L. C. S. DEPT.
SALEM, OREGON

MALHEUR NATIONAL FOREST

STOCK WATER(83105)

RAINBOW allotment

SCALE 4 IN. : 1 MILE

T. 19 S. R. 29 E. North ↑

application no. 66 772 49832

permit no.

Twin Springs
diversion
↓
200
↑
300
trough

16
Sugarloaf
Spr
Thornburg
Spr