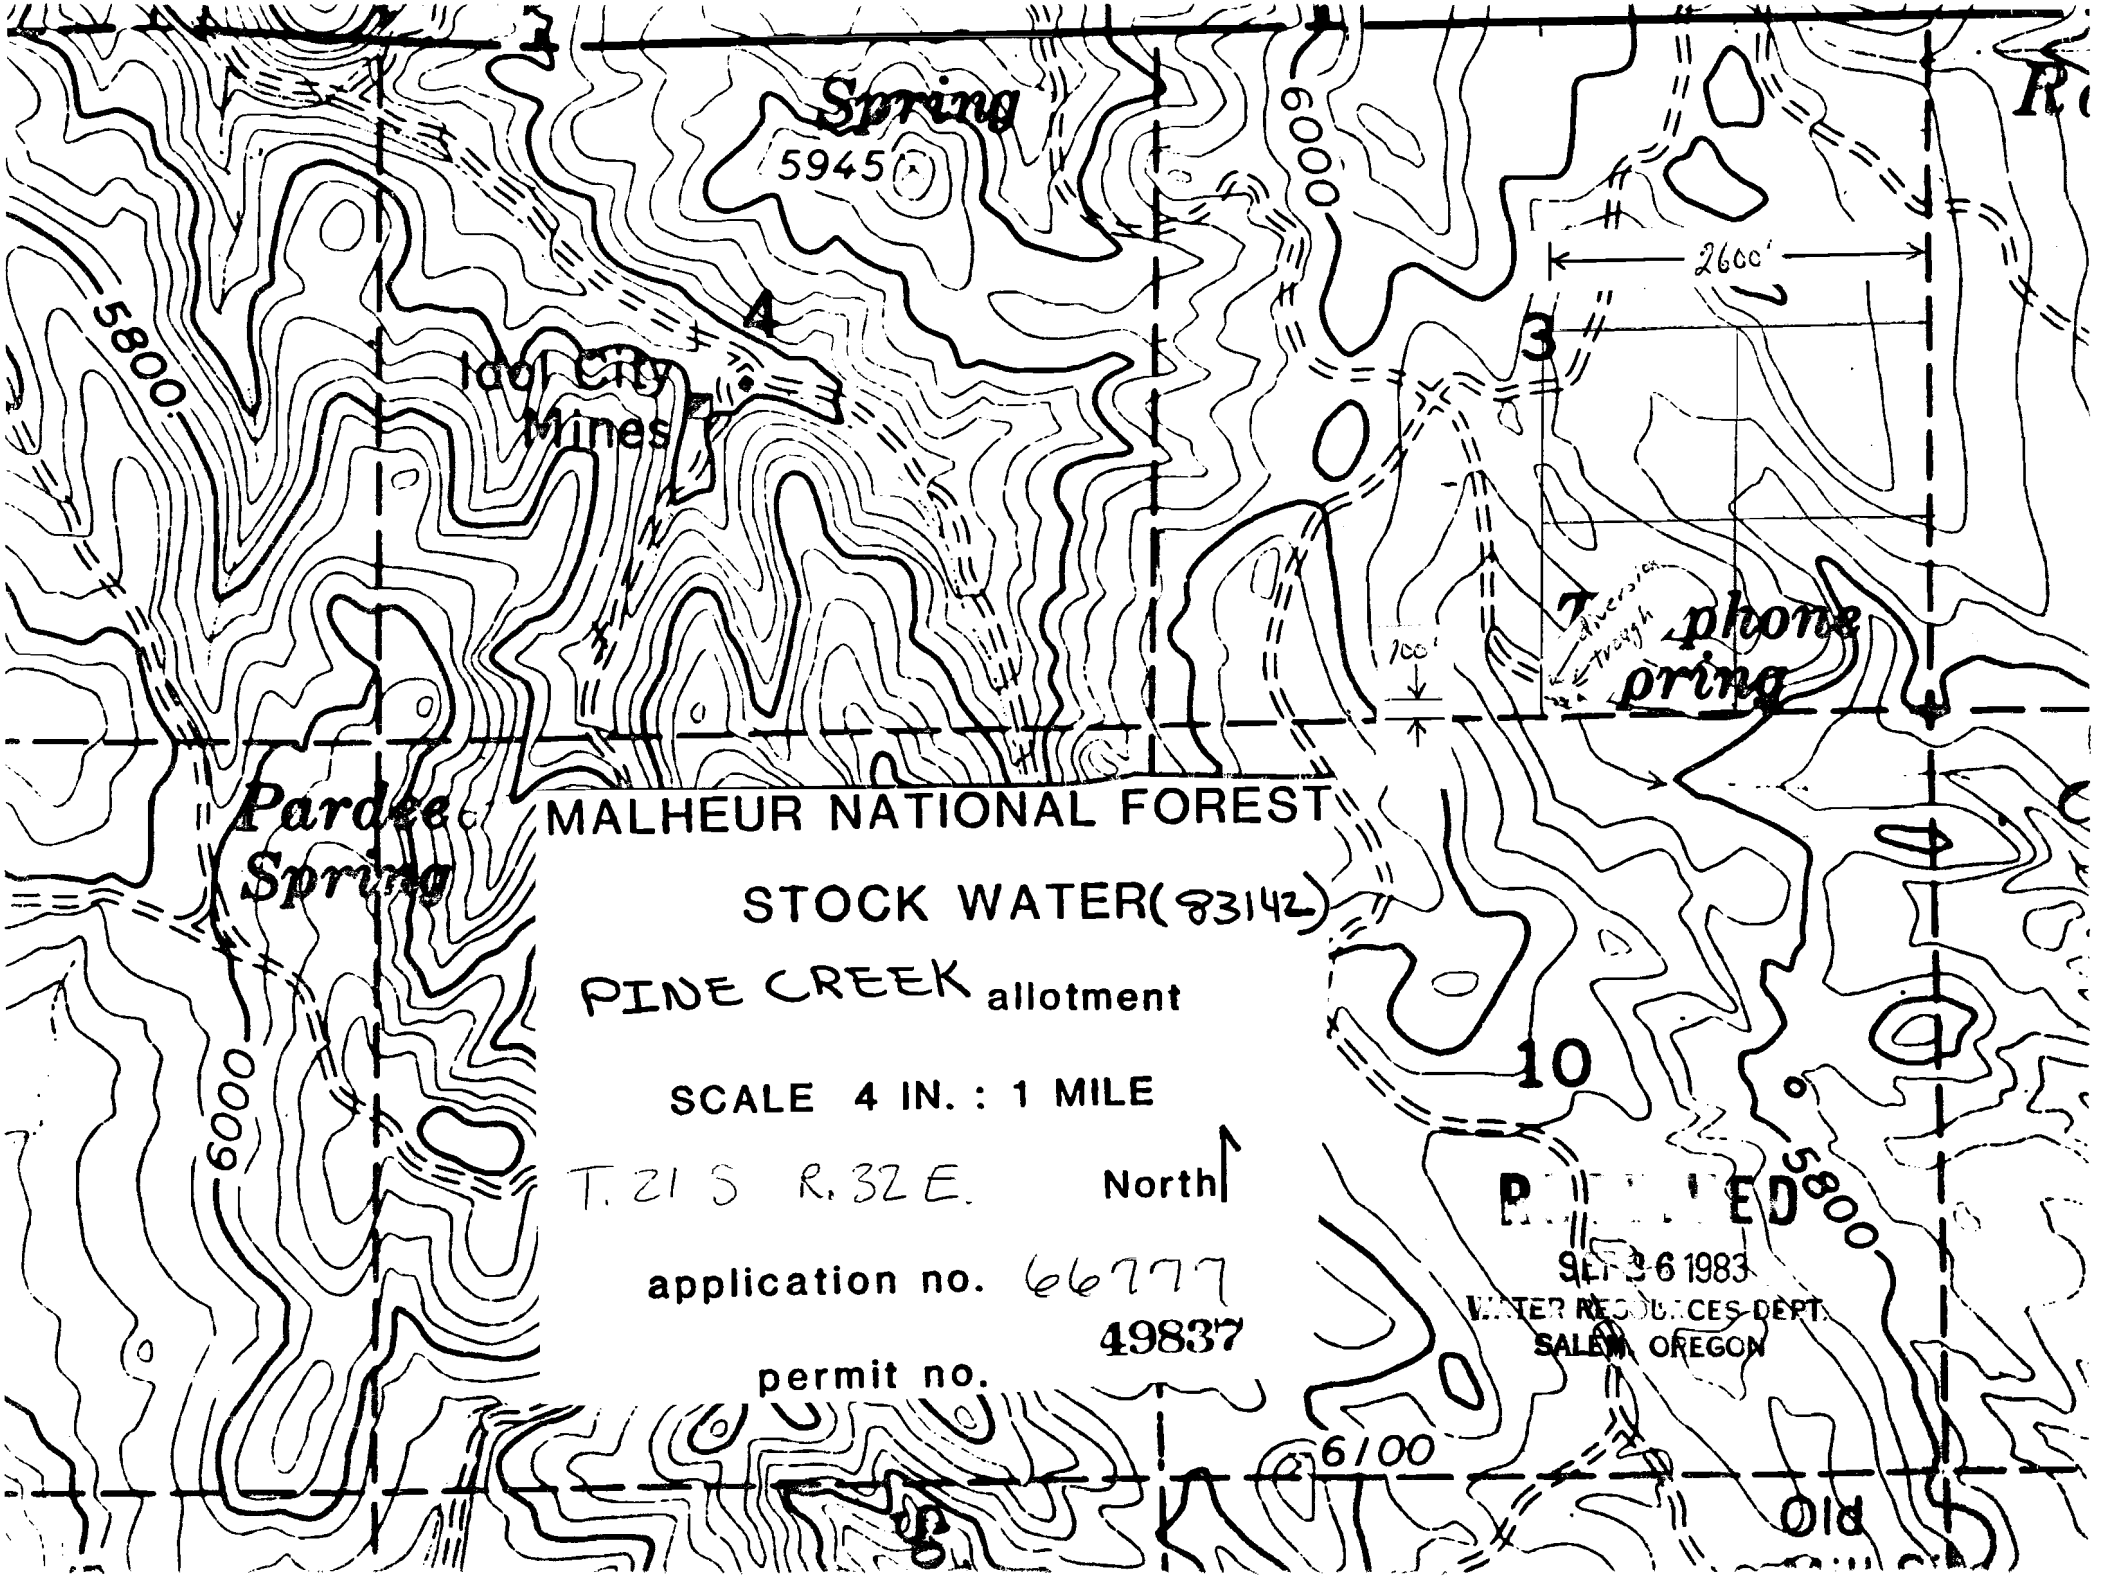

Spring
5945
6000
5800
2600'
3
Idol City Mines
A
Pardee Spring
MALHEUR NATIONAL FOREST
STOCK WATER(83142)
PINE CREEK allotment
SCALE 4 IN. : 1 MILE
T. 21 S R. 32 E.
North
application no. 66777
49837
permit no.
10
6100
5800
6000
RECEIVED
SEP 26 1983
WATER RESOURCES DEPT.
SALEM, OREGON