

MALHEUR NATIONAL FOREST

STOCK WATER(R93136)

PINE CREEK allotment


SCALE 4 IN. : 1 MILE

T. 20 S. R. 33 E.

North

application no. 66778

permit no. 49838

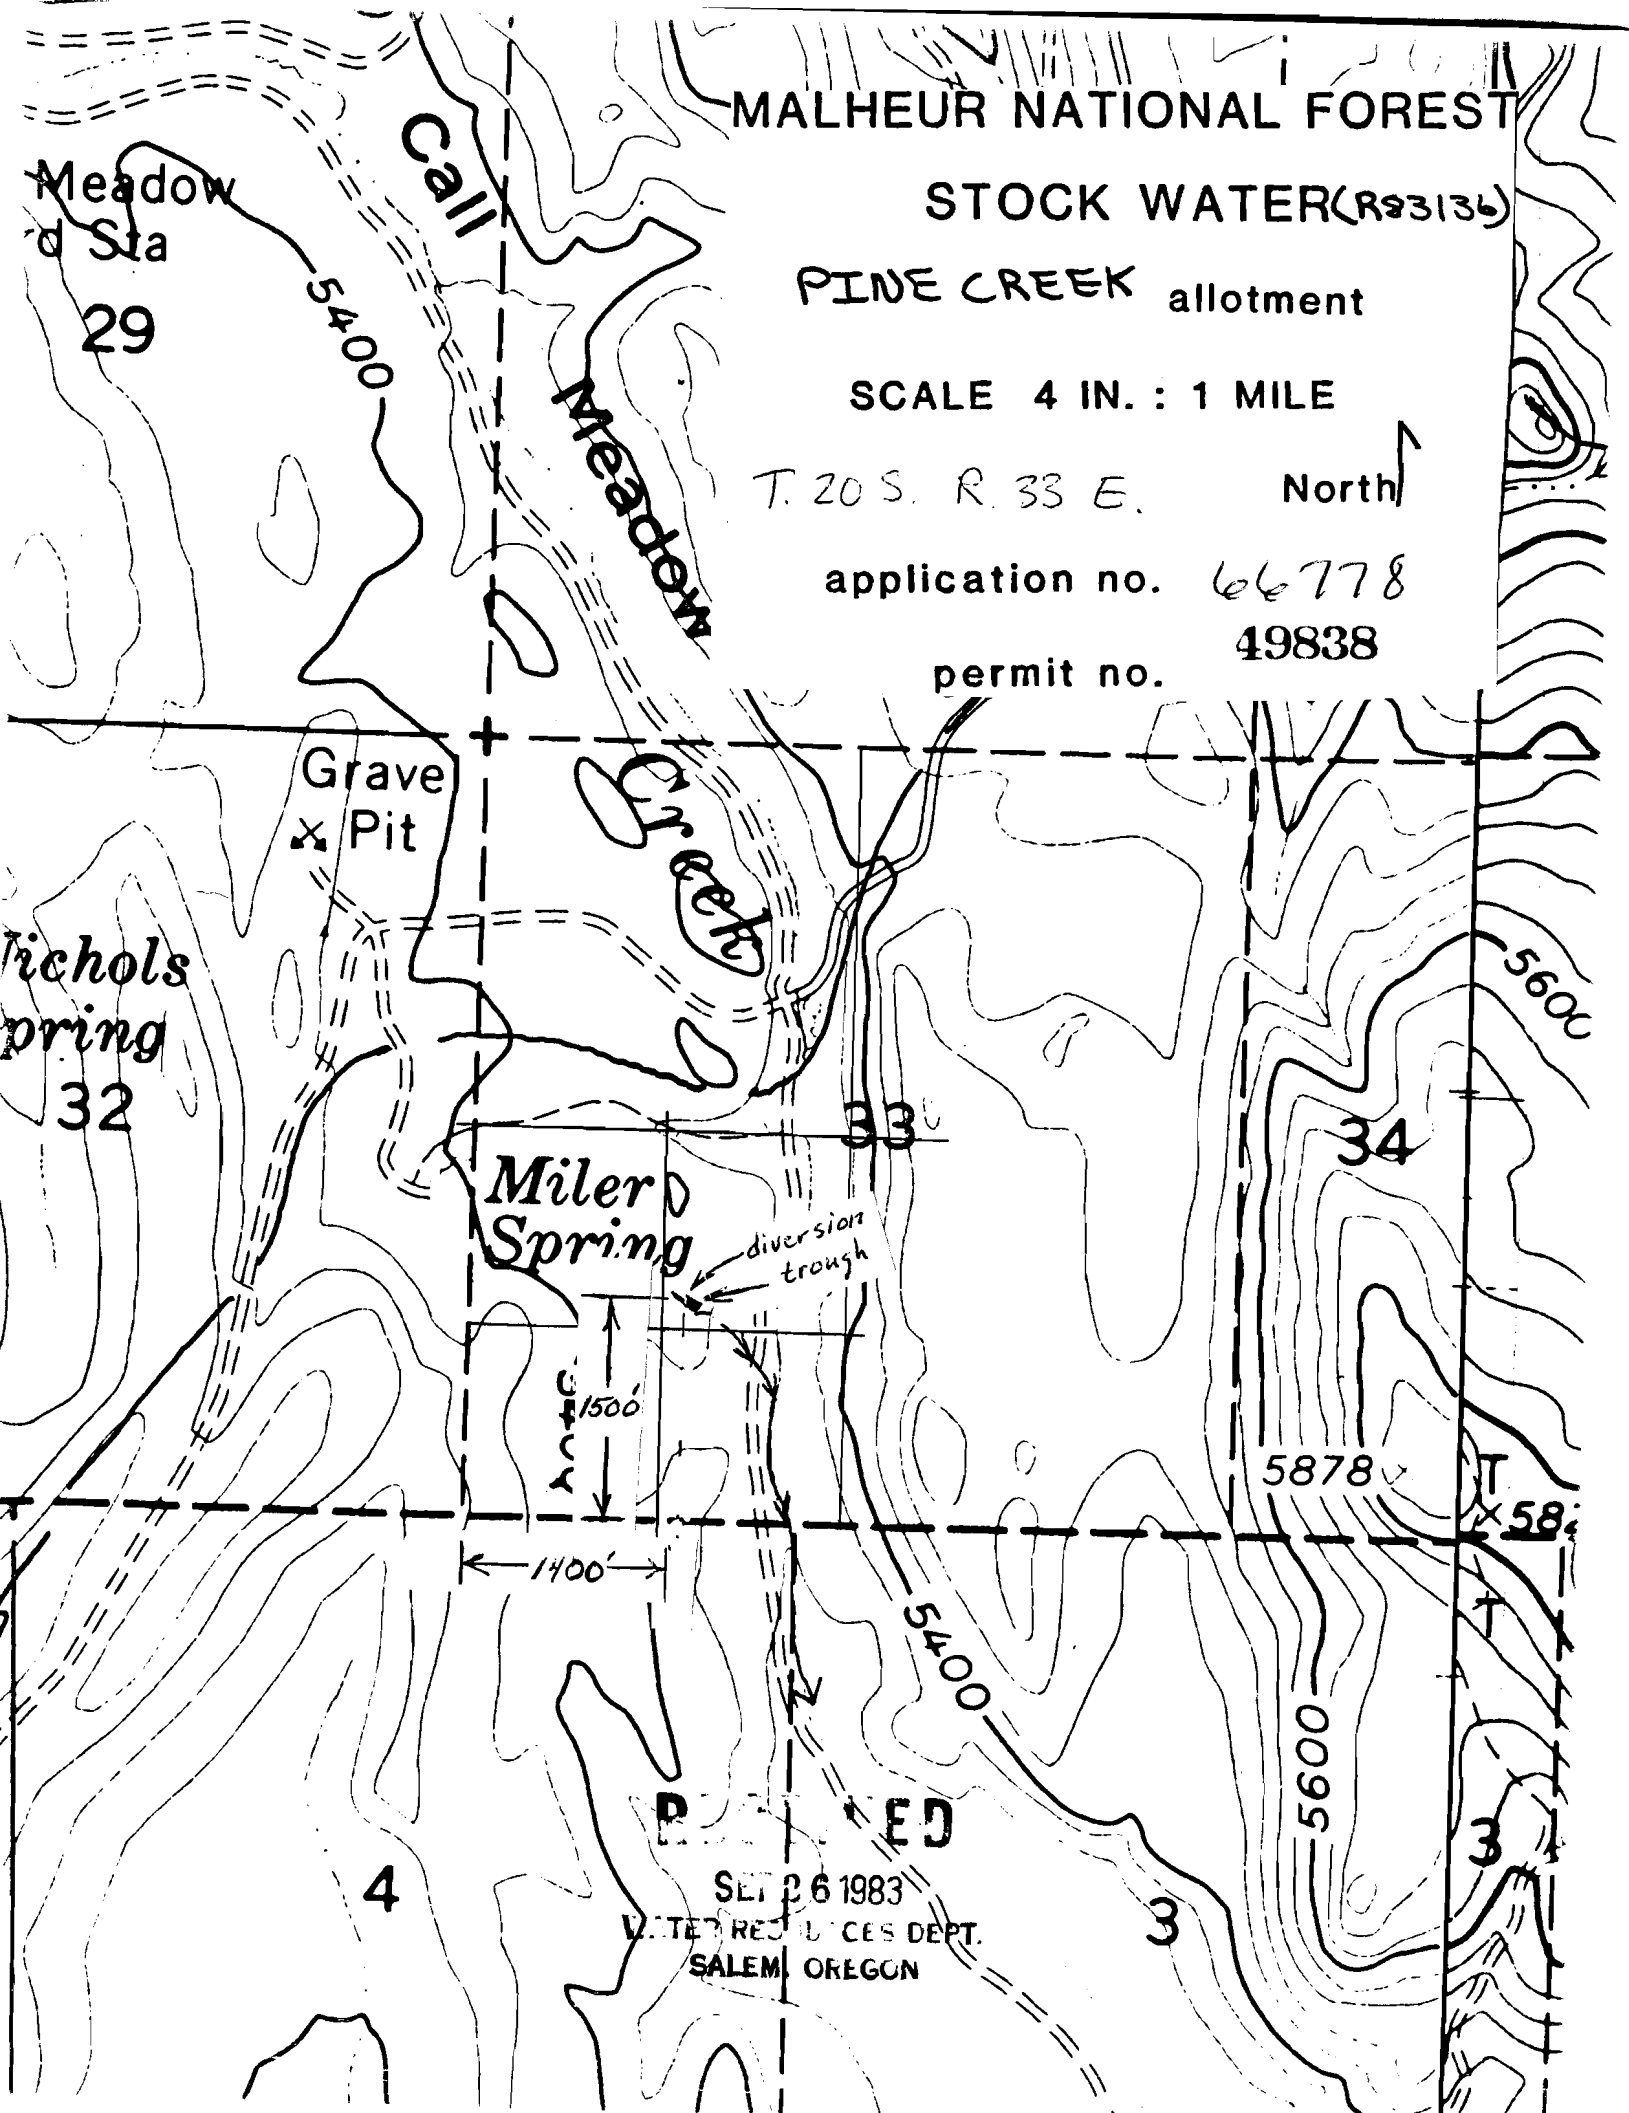

SET 26 1983
SALEM, OREGON