


SKETCH

SHOWING
THE LOCATION OF THE
BAALAM PHILLIPS DITCHES
& IRRIGATED LANDS IN SEC.
14, T8S, R38E, W.M., BAKER
CO. ORE.

SCALE, ONE INCH = 200 FT.
SURVEYED, AUG. 9, 1923.

Ira L. Hoffman,
County Surveyor.

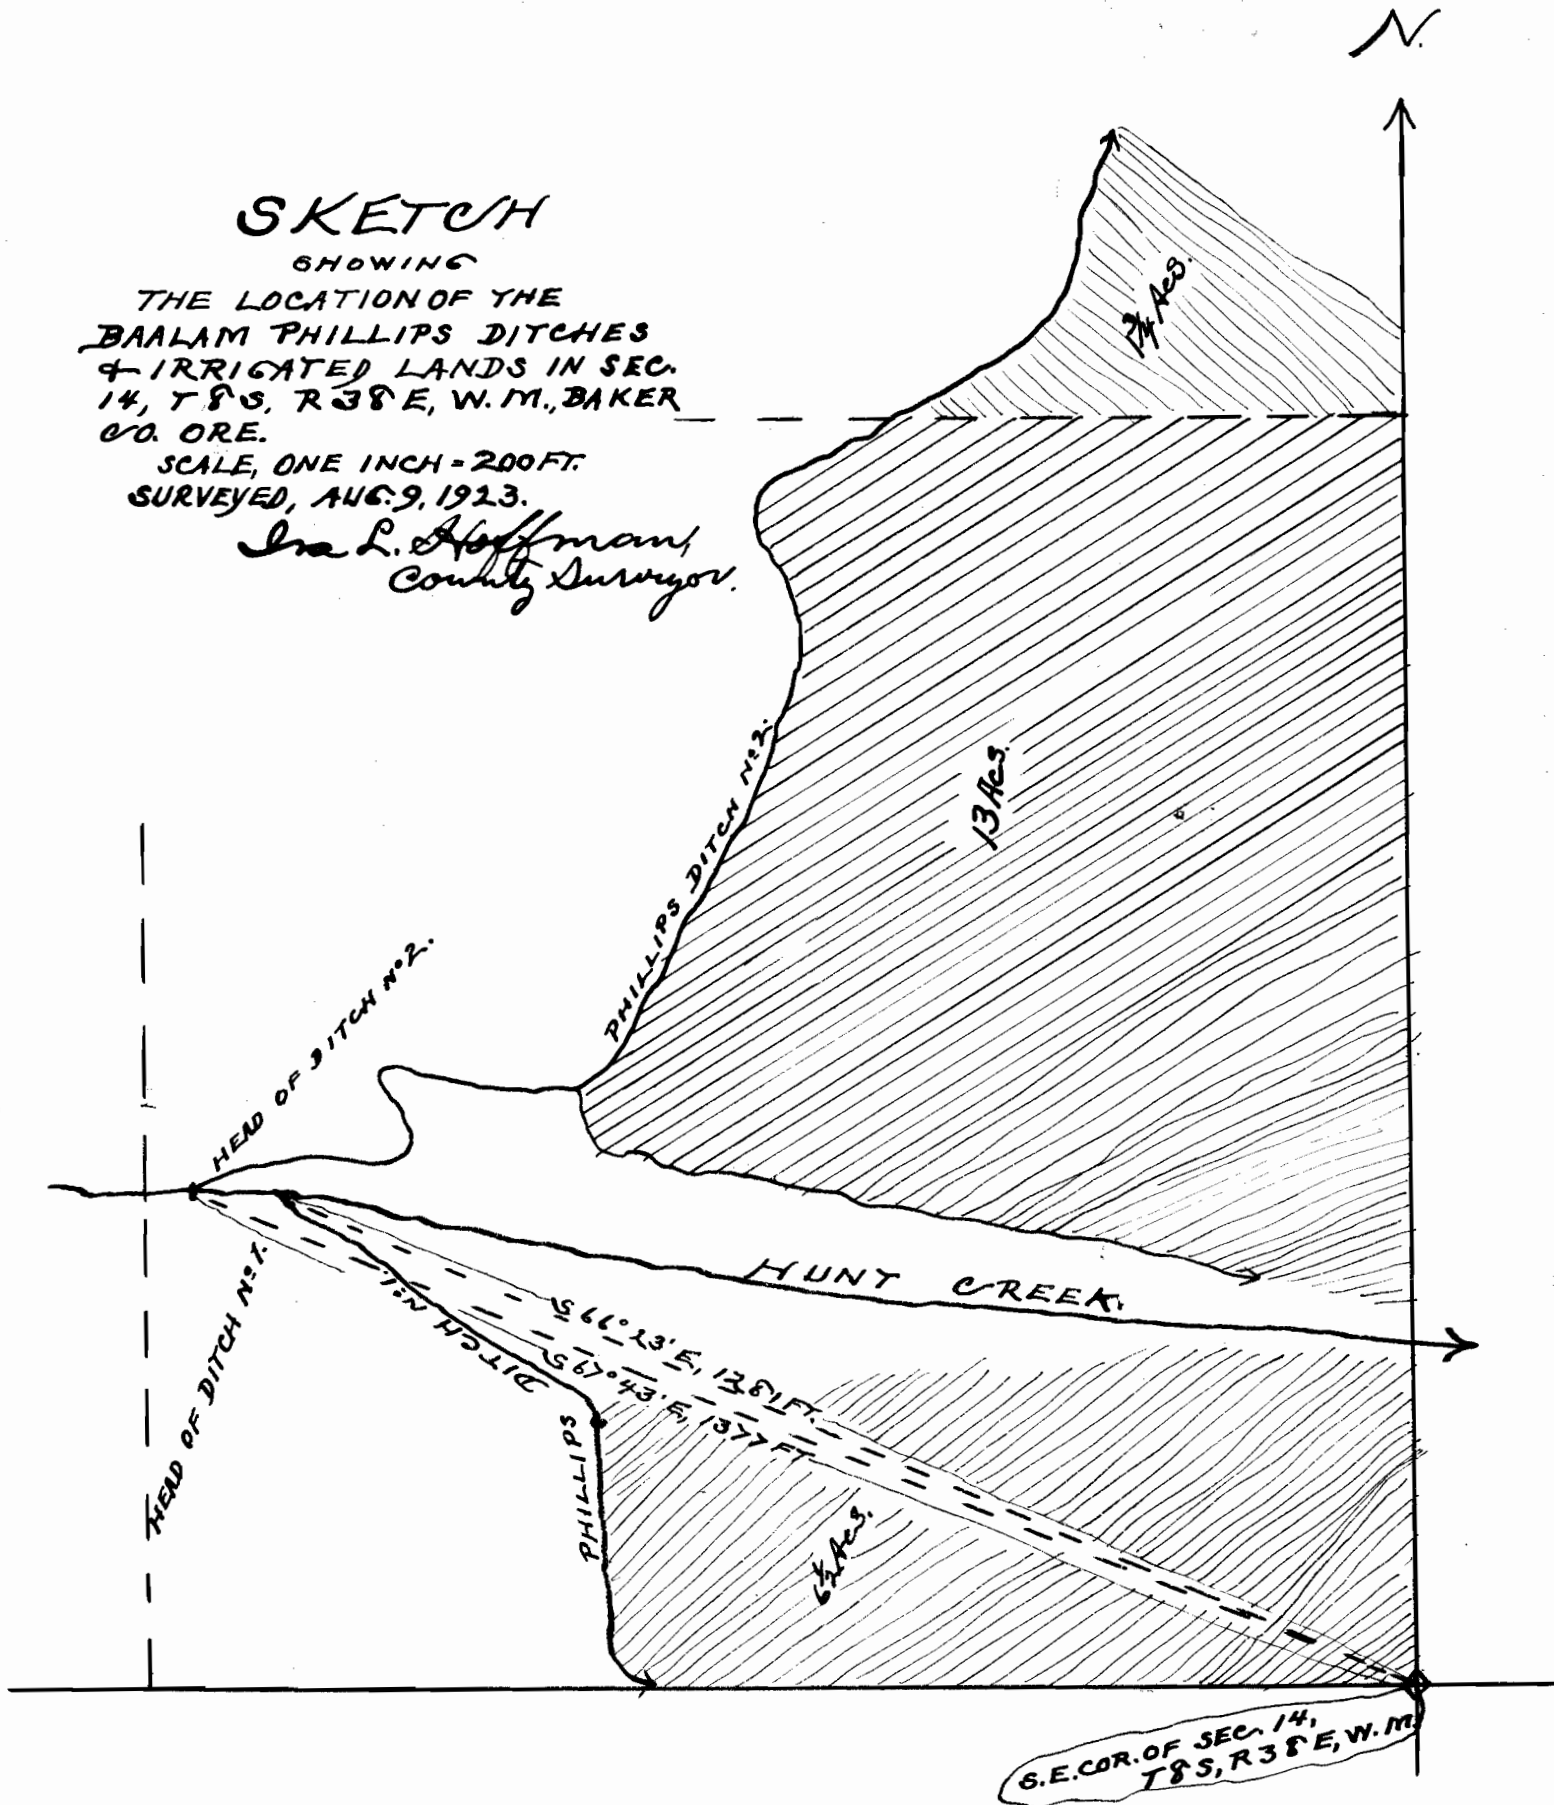

CERTIFICATE OF SURVEYOR.

I, IRA L. HOFFMAN OF BAKER, ORE., DO HEREBY CERTIFY
THAT THIS MAP WAS MADE FROM NOTES TAKEN DURING AN
ACTUAL SURVEY MADE BY ME ON AUG. 9, 1923 AND THAT
IT CORRECTLY REPRESENTS THE DATA SHOWN THEREON.

Ira L. Hoffman,
County Surveyor.



STATE ENGINEER
RECEIVED

OCT 3 1923

Application No 8977
Permit No 61334

SALEM OREGON