


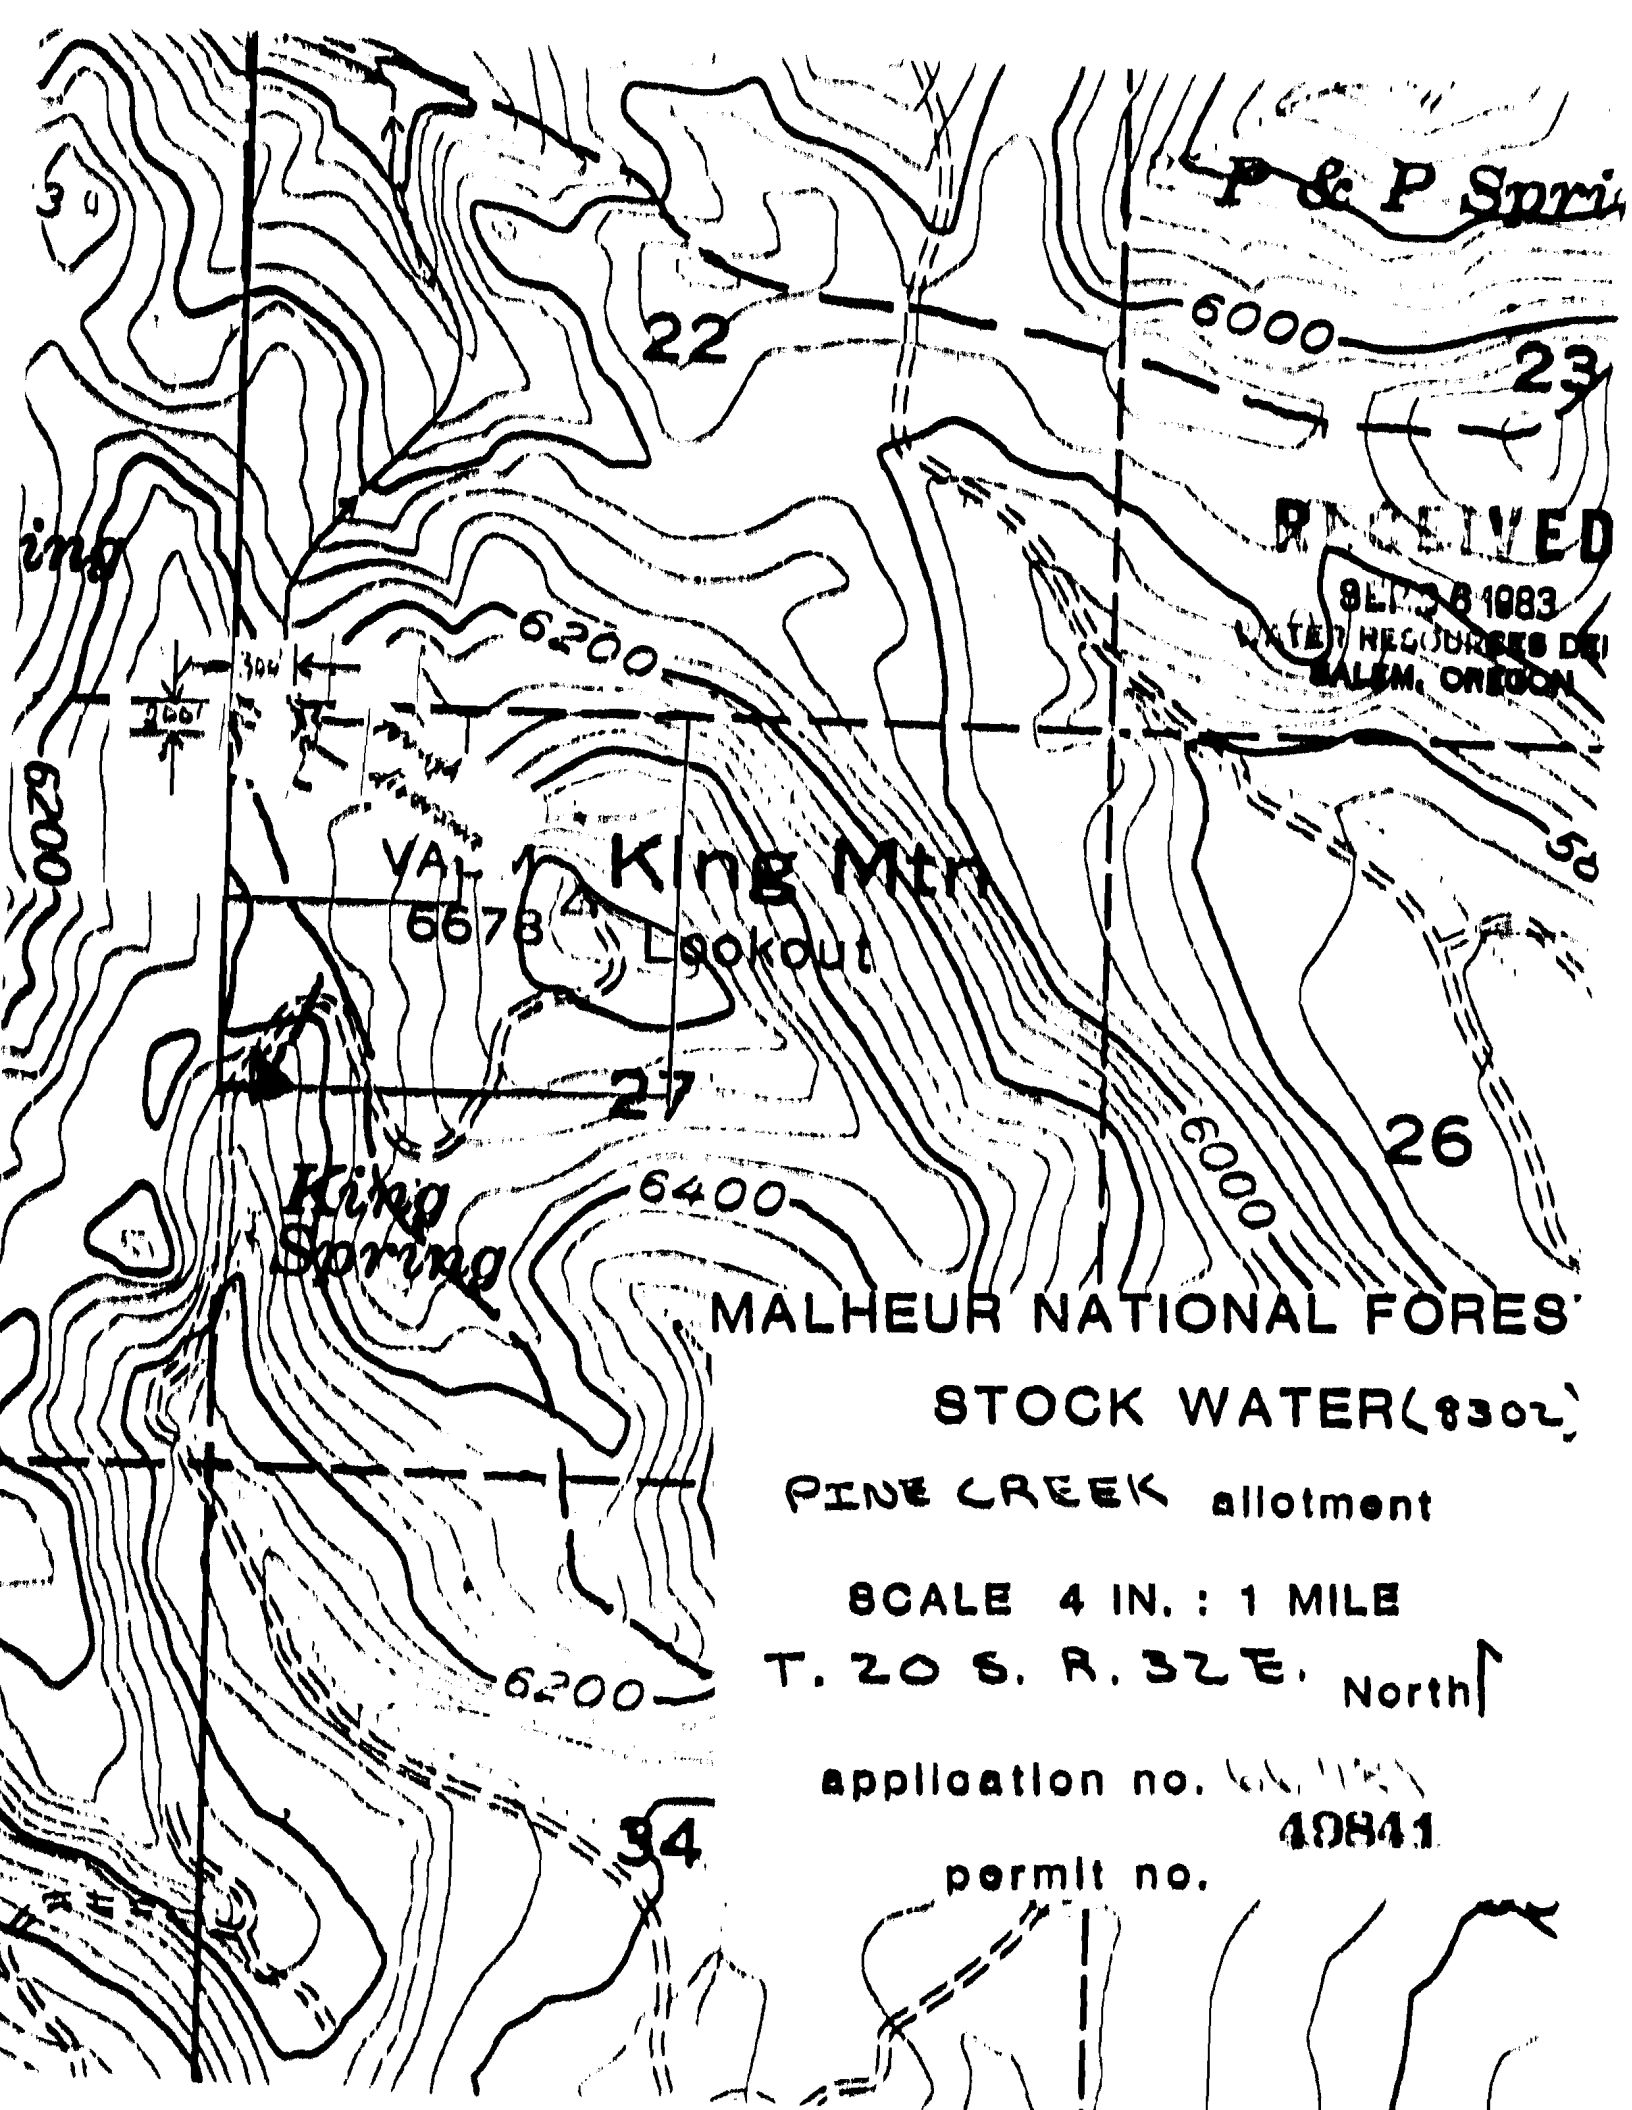

P & P Spring

22

6000

23

RECEIVED

SEP 28 1983

WATER RESOURCES DIV
SALEM, OREGON

6200

VAL

King Mtn

6678

Lookout

27

King Spring

6400

6000

26

MALHEUR NATIONAL FOREST

STOCK WATER (8302)

PINE CREEK allotment

SCALE 4 IN. : 1 MILE

T. 20 S. R. 32 E. North

application no. 661125

40841

permit no.

34