


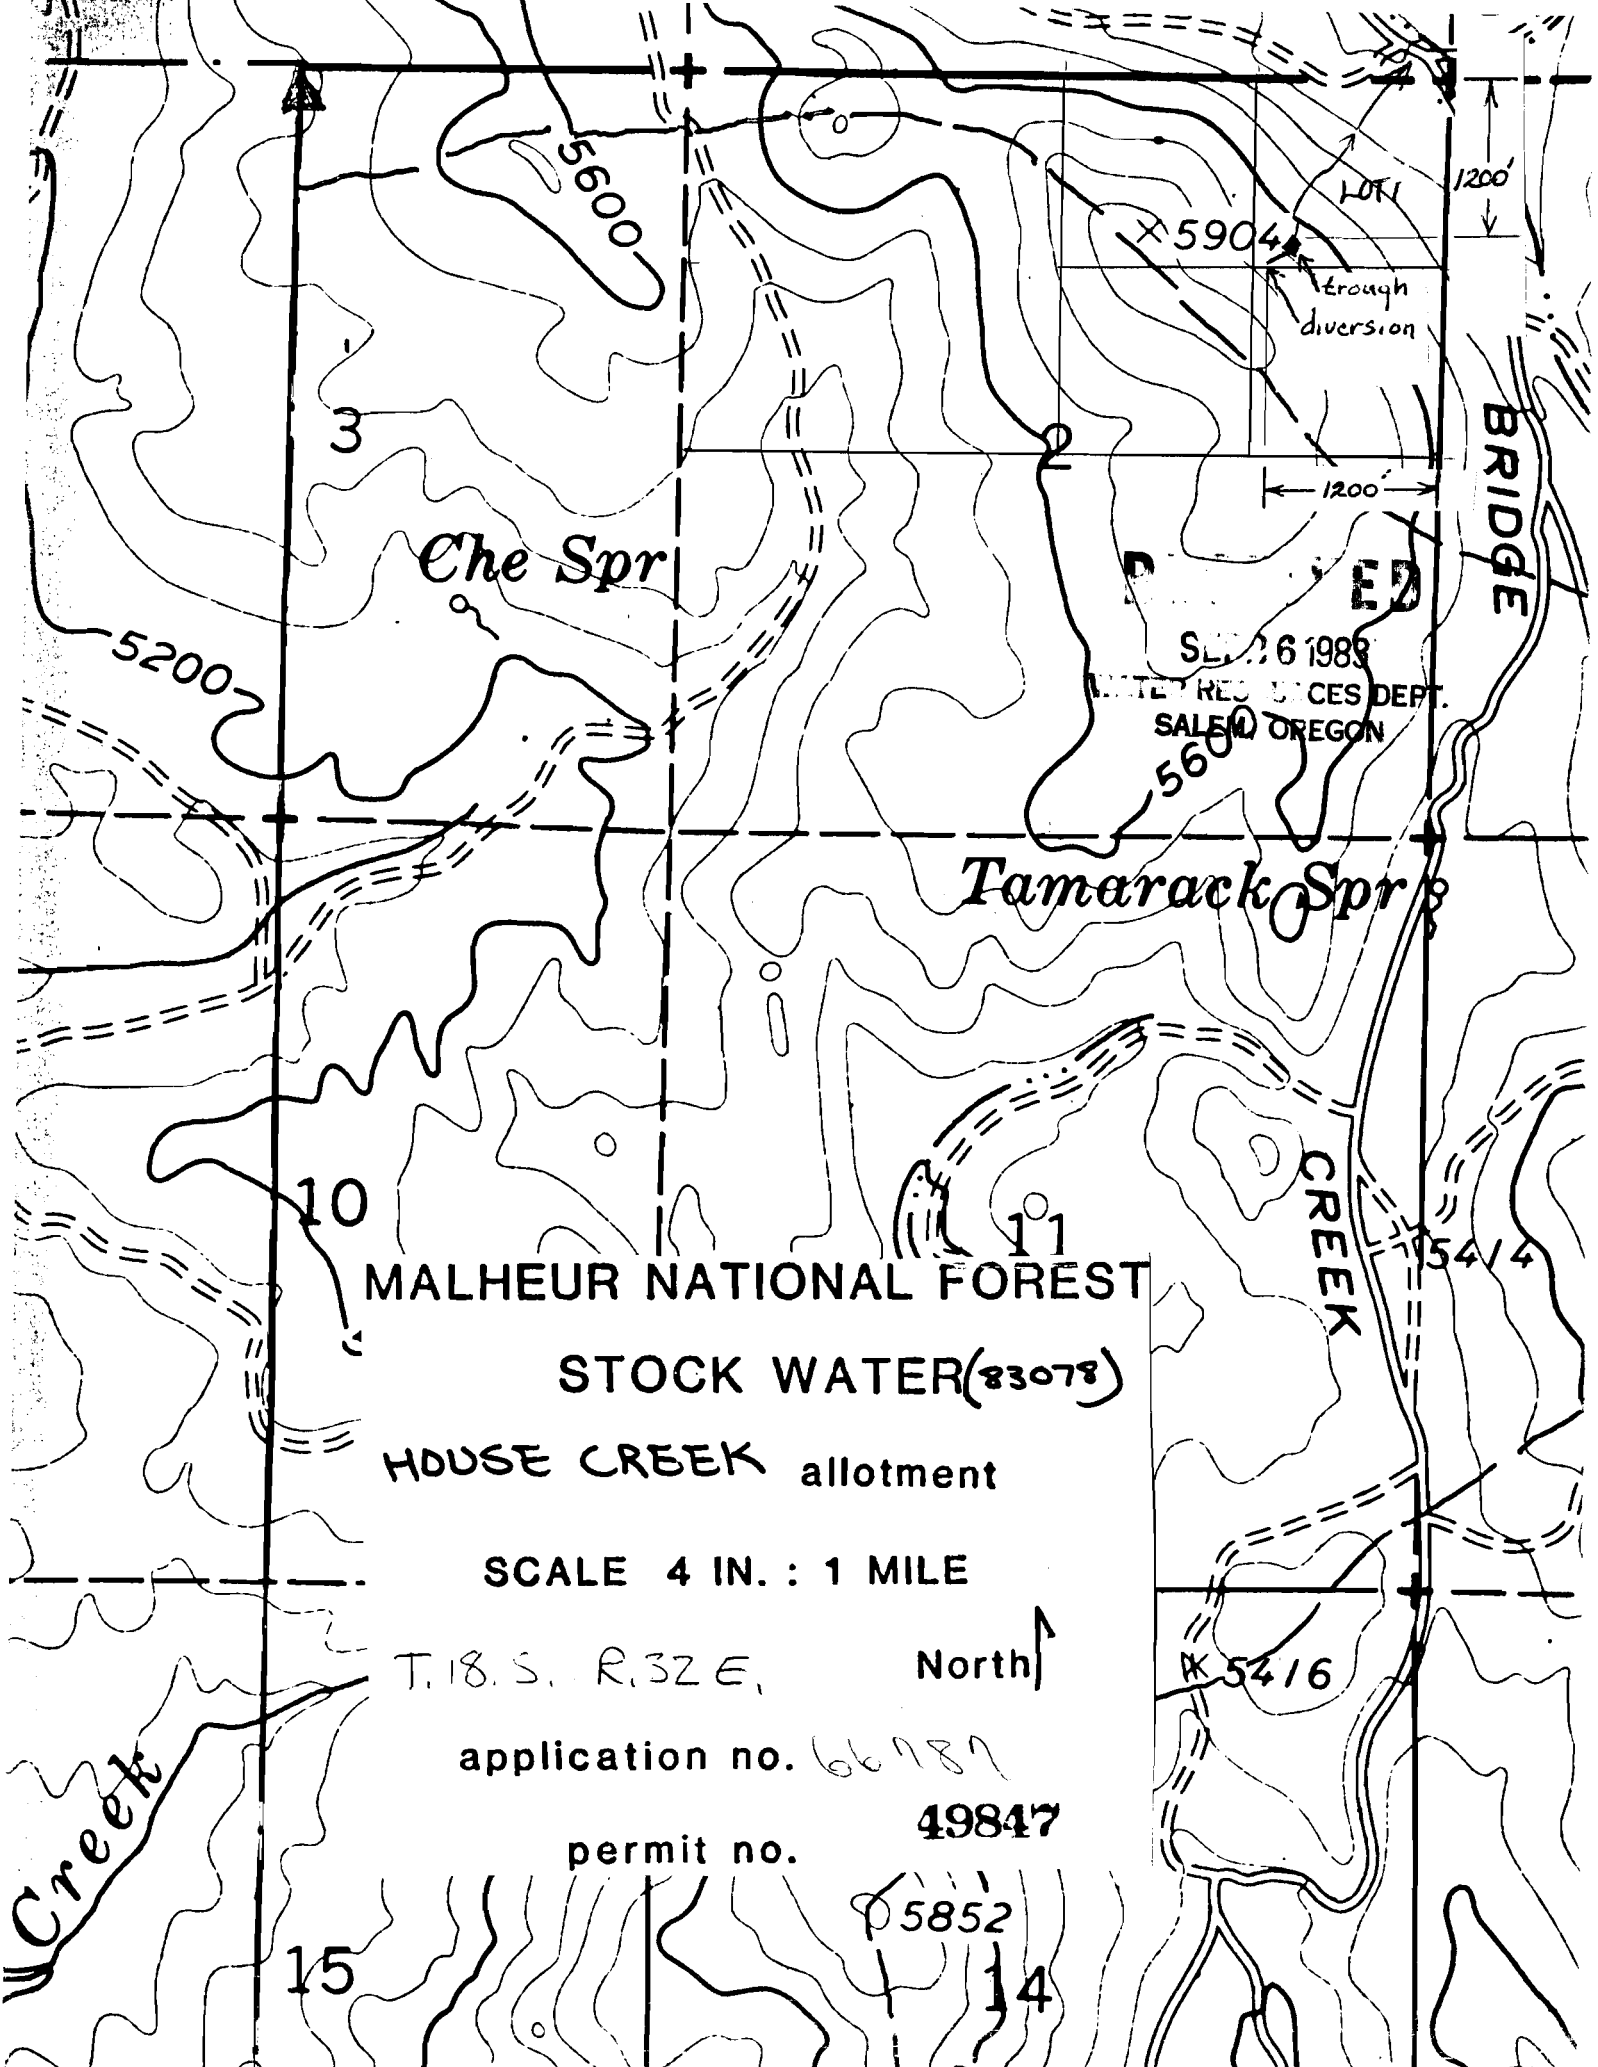

MALHEUR NATIONAL FOREST

STOCK WATER(83078)

HOUSE CREEK allotment

SCALE 4 IN. : 1 MILE

T. 18. S. R. 32 E.

North ↗

application no. 66787

permit no. 49847

5852

5416

CREEK

BRIDGE

through diversion

Che Spr

Tamarack Spr

SEP 26 1988
WATER RESOURCES DEPT.
SALEM OREGON

X 5904

LOT 1

1200'

1200'

5600

5600

5200

3

2

10

11

15

14

Creek