


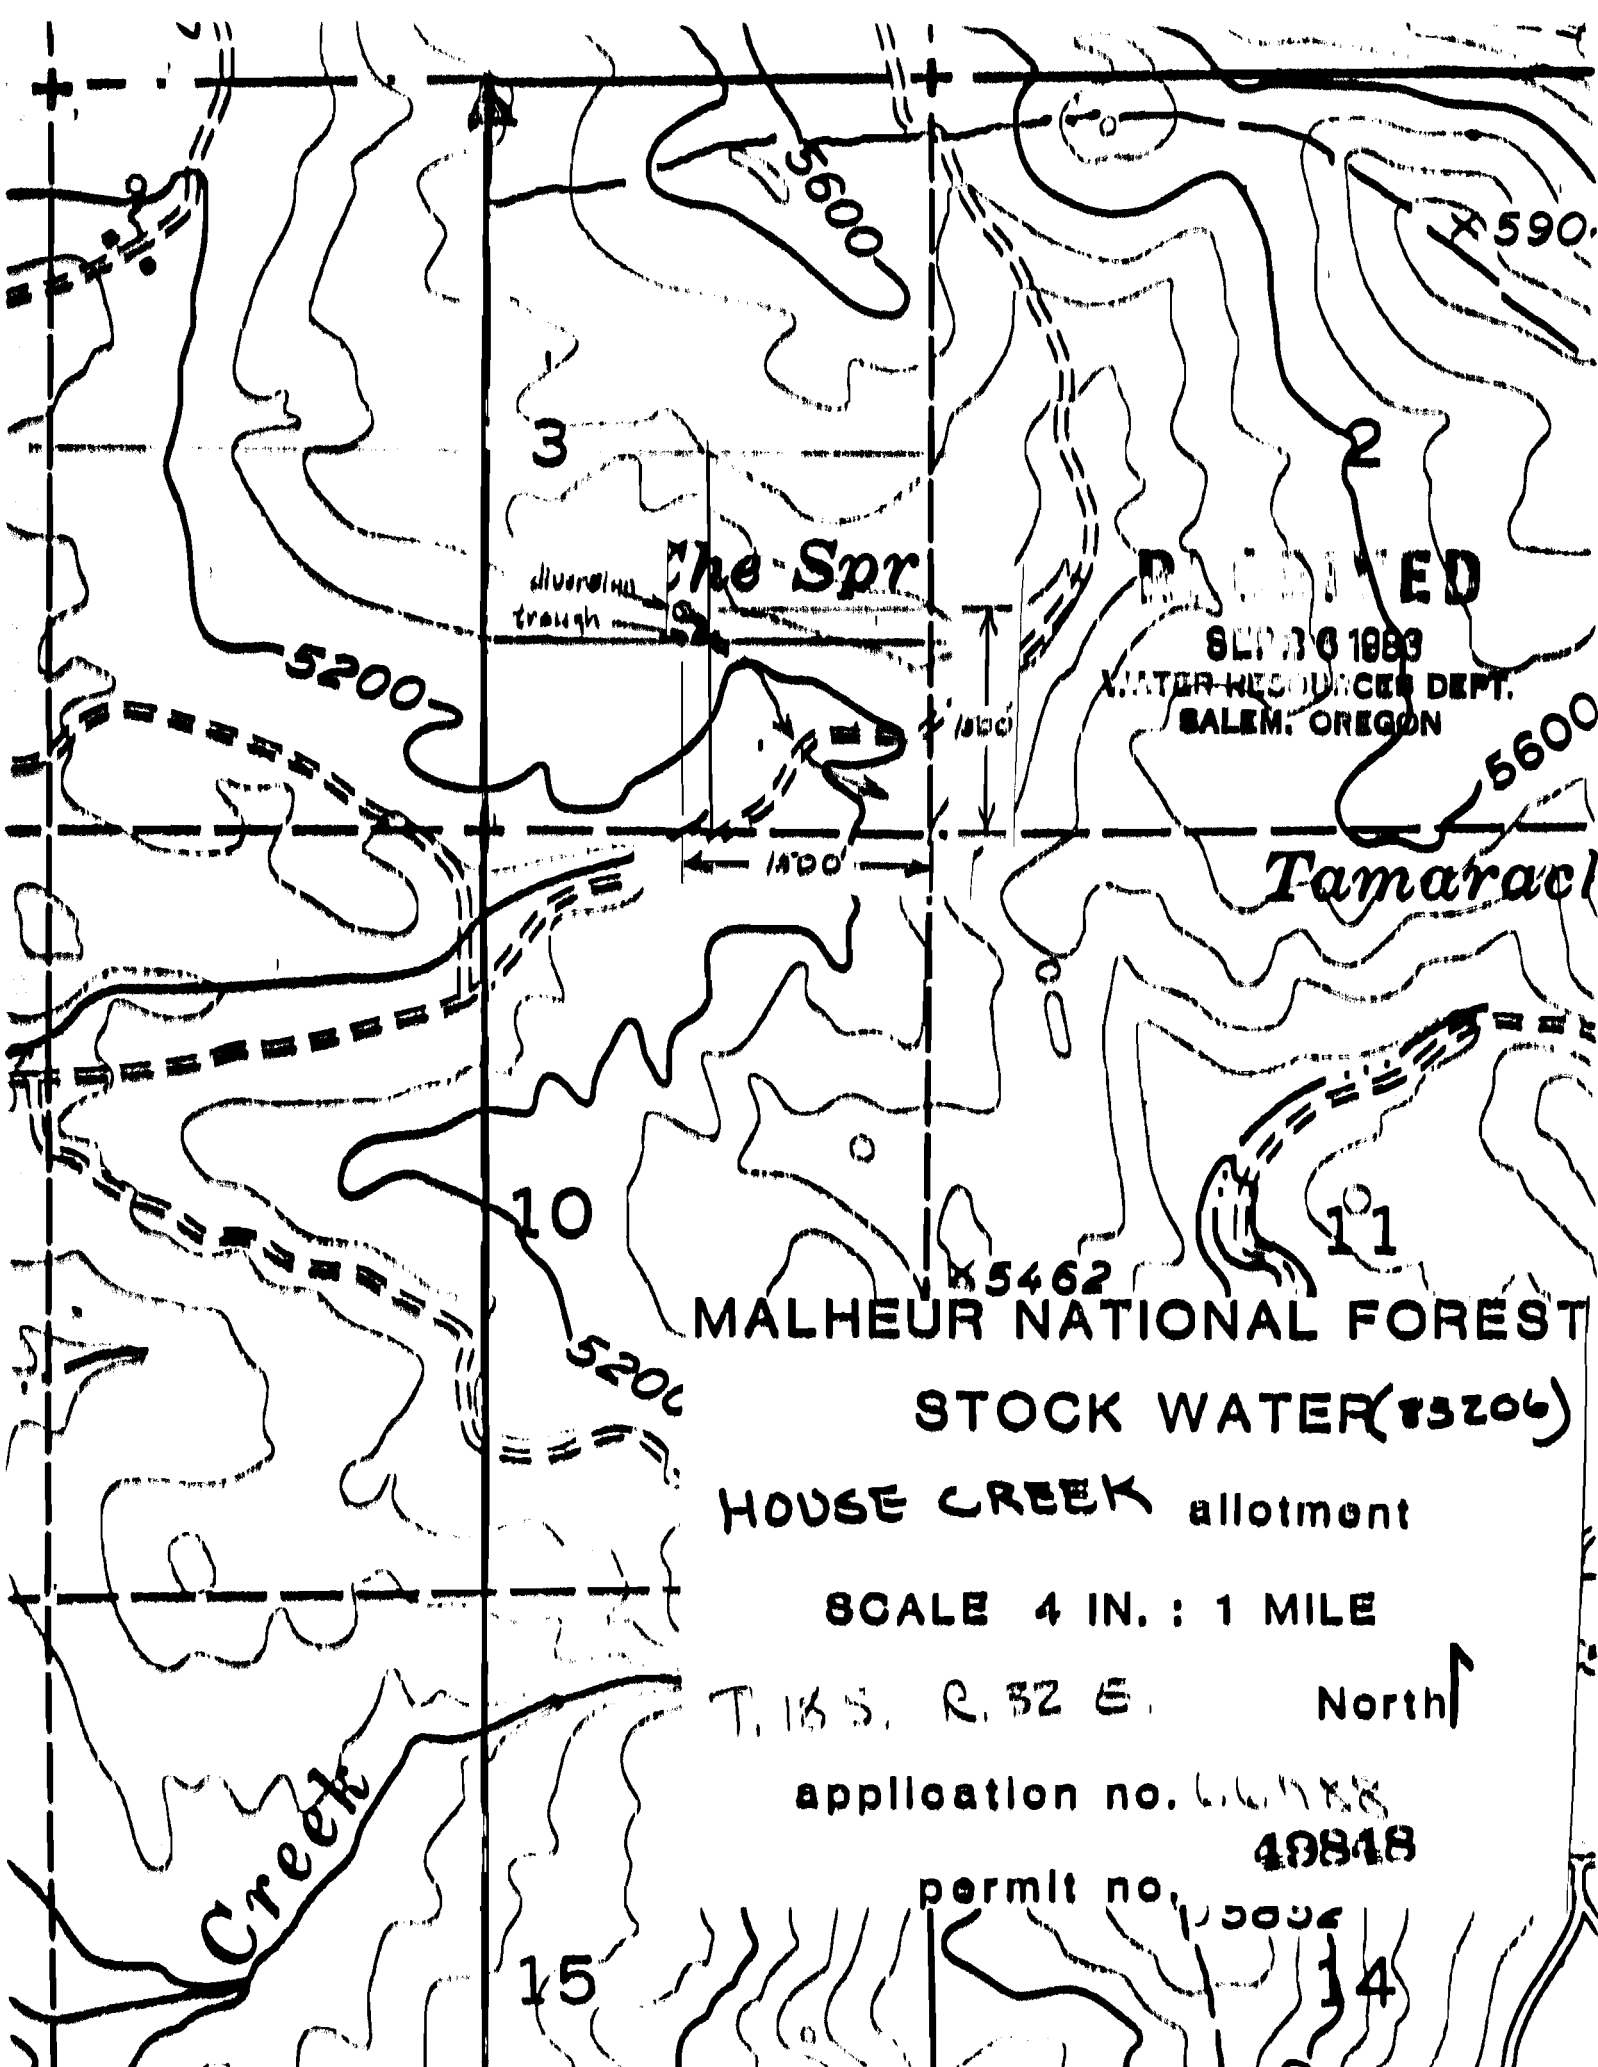

RECEIVED
SEP 30 1983
WATER RESOURCES DEPT.
SALEM, OREGON

MALHEUR NATIONAL FOREST

STOCK WATER (83206)

HOUSE CREEK allotment

SCALE 4 IN. : 1 MILE

T. 18 S. R. 32 E.

North ↑

application no. 66788

49848

permit no. 5002

Creek