


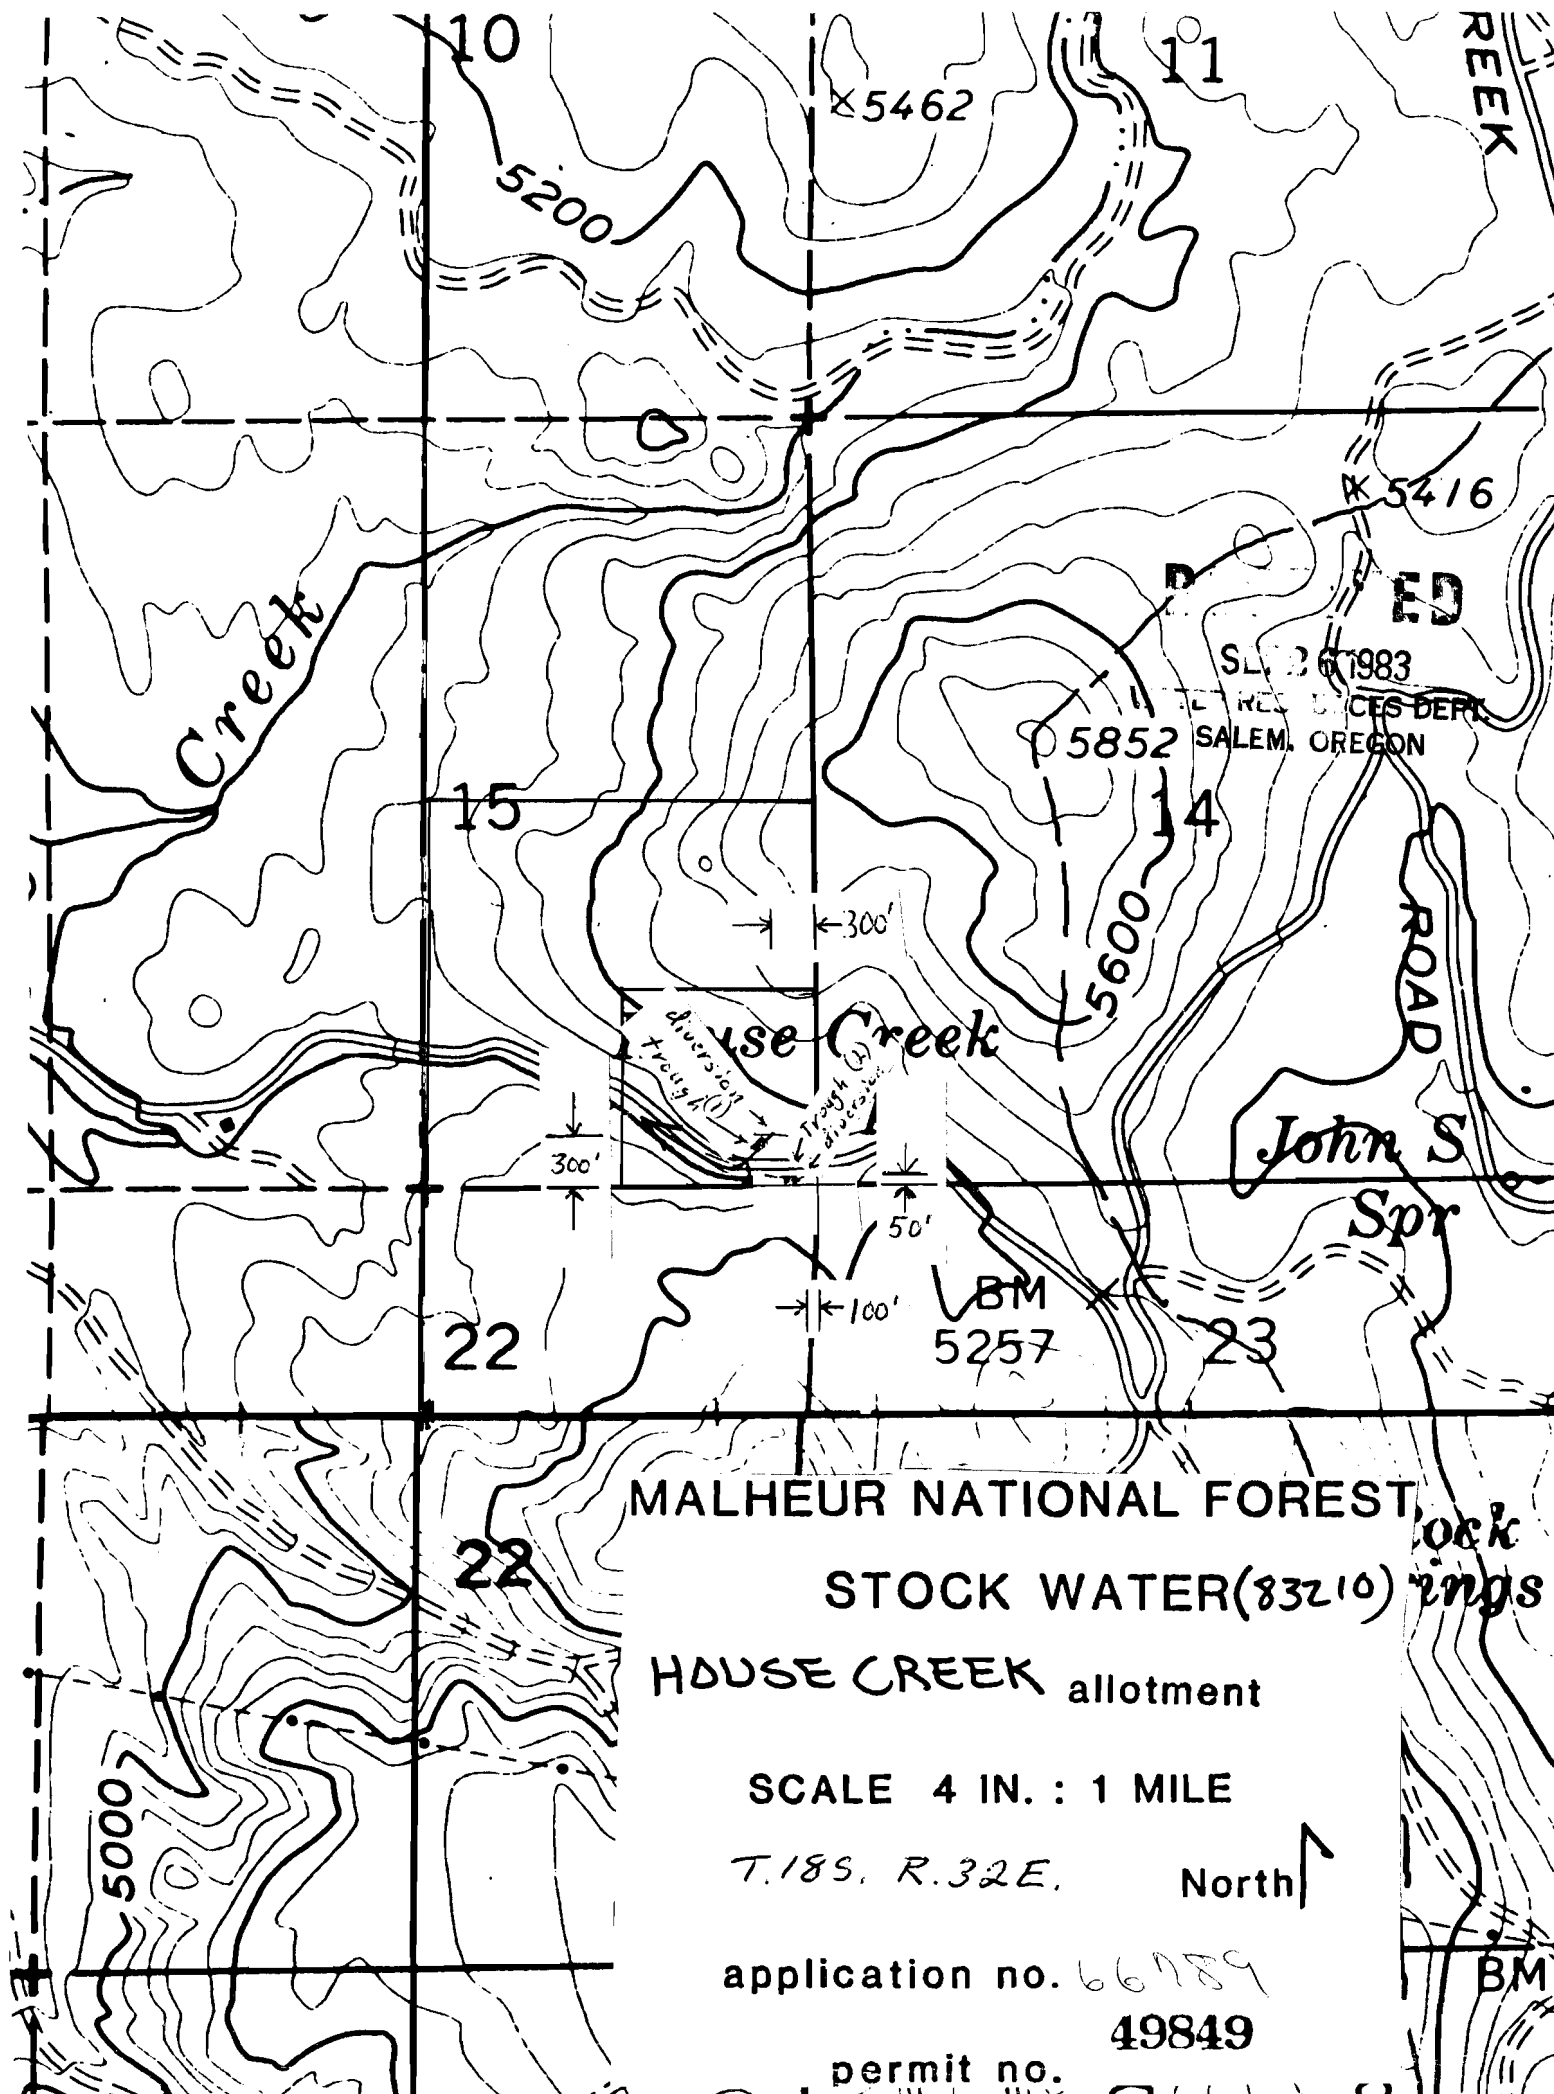

MALHEUR NATIONAL FOREST
STOCK WATER (83210)
HOUSE CREEK allotment

SCALE 4 IN. : 1 MILE

T. 18 S. R. 32 E.

North

application no. 66789

49849

permit no.