


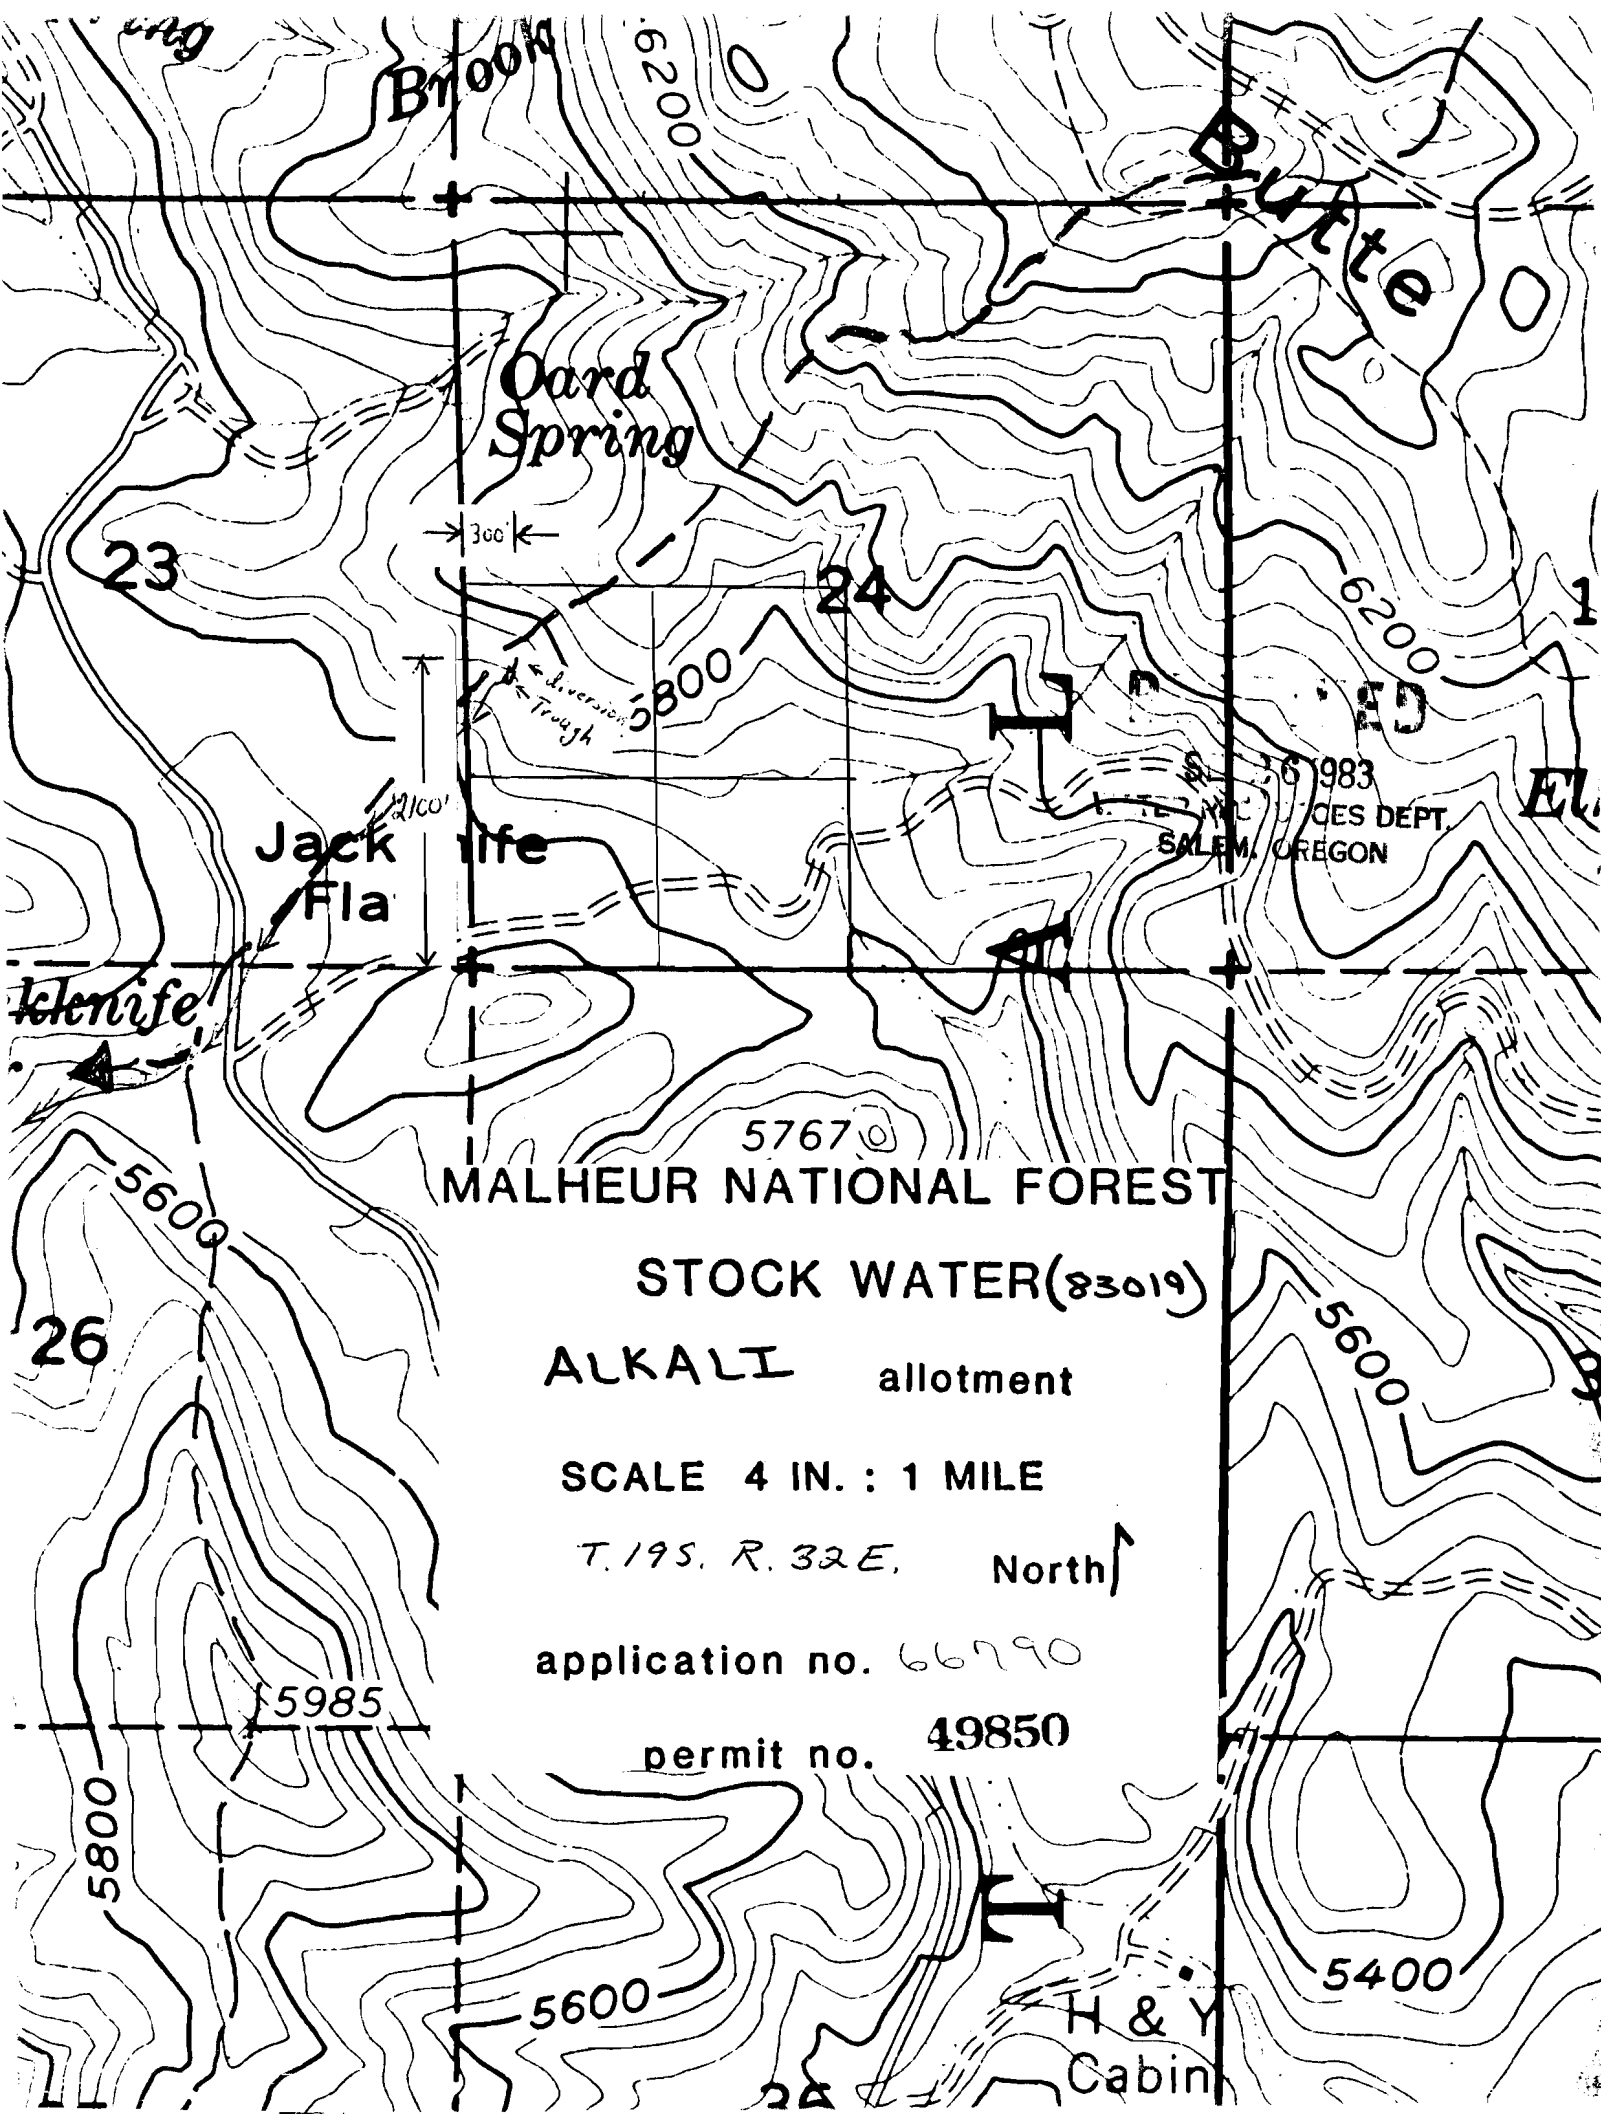

Brook

Butte

Card Spring

300'

diversion  
Trough

Jack Fl


61983  
CES DEPT.  
SALEM, OREGON

5767  
MALHEUR NATIONAL FOREST

STOCK WATER(83019)

ALKALI allotment

SCALE 4 IN. : 1 MILE

T. 19 S. R. 32 E. North

application no. 66790

permit no. 49850

H & Y  
Cabin