


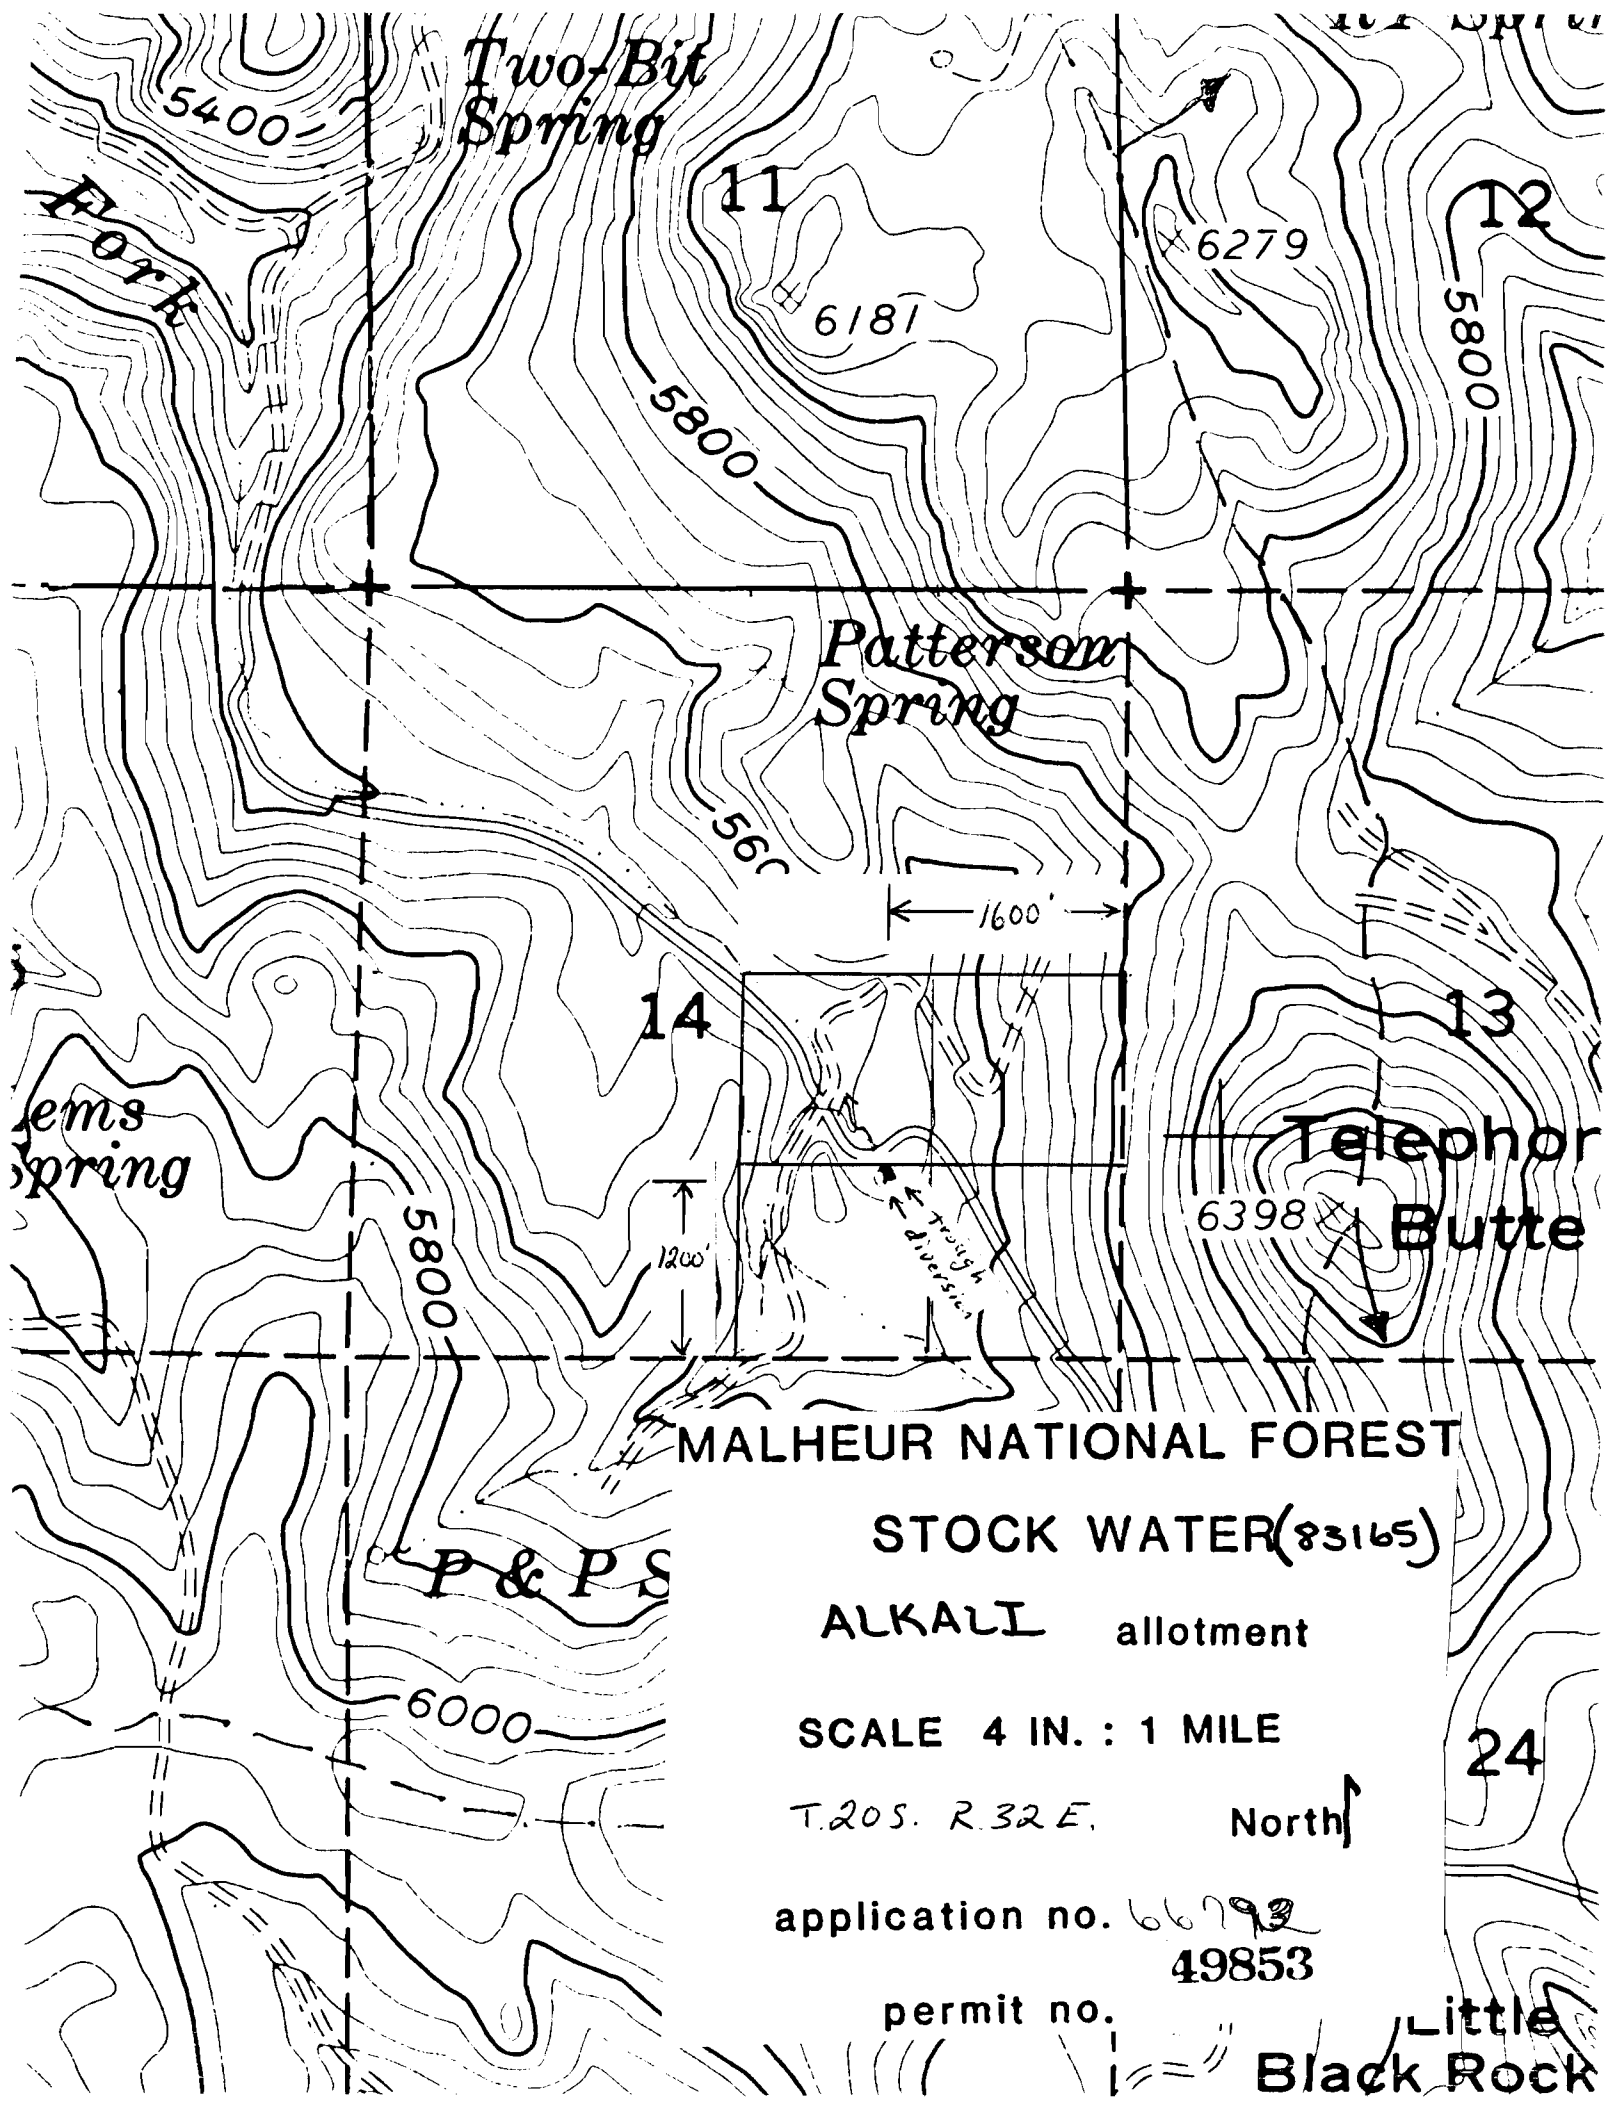

Two-Bit
Spring

11

6181

6279

12

Patterson
Spring

560

1600'

14

13

Telephor
Butte

6398

MALHEUR NATIONAL FOREST

STOCK WATER(83165)

ALKALI allotment

SCALE 4 IN. : 1 MILE

T.20S. R.32E.

North

application no. 66793
49853

permit no.

Little
Black Rock

24

P & P S

6000