


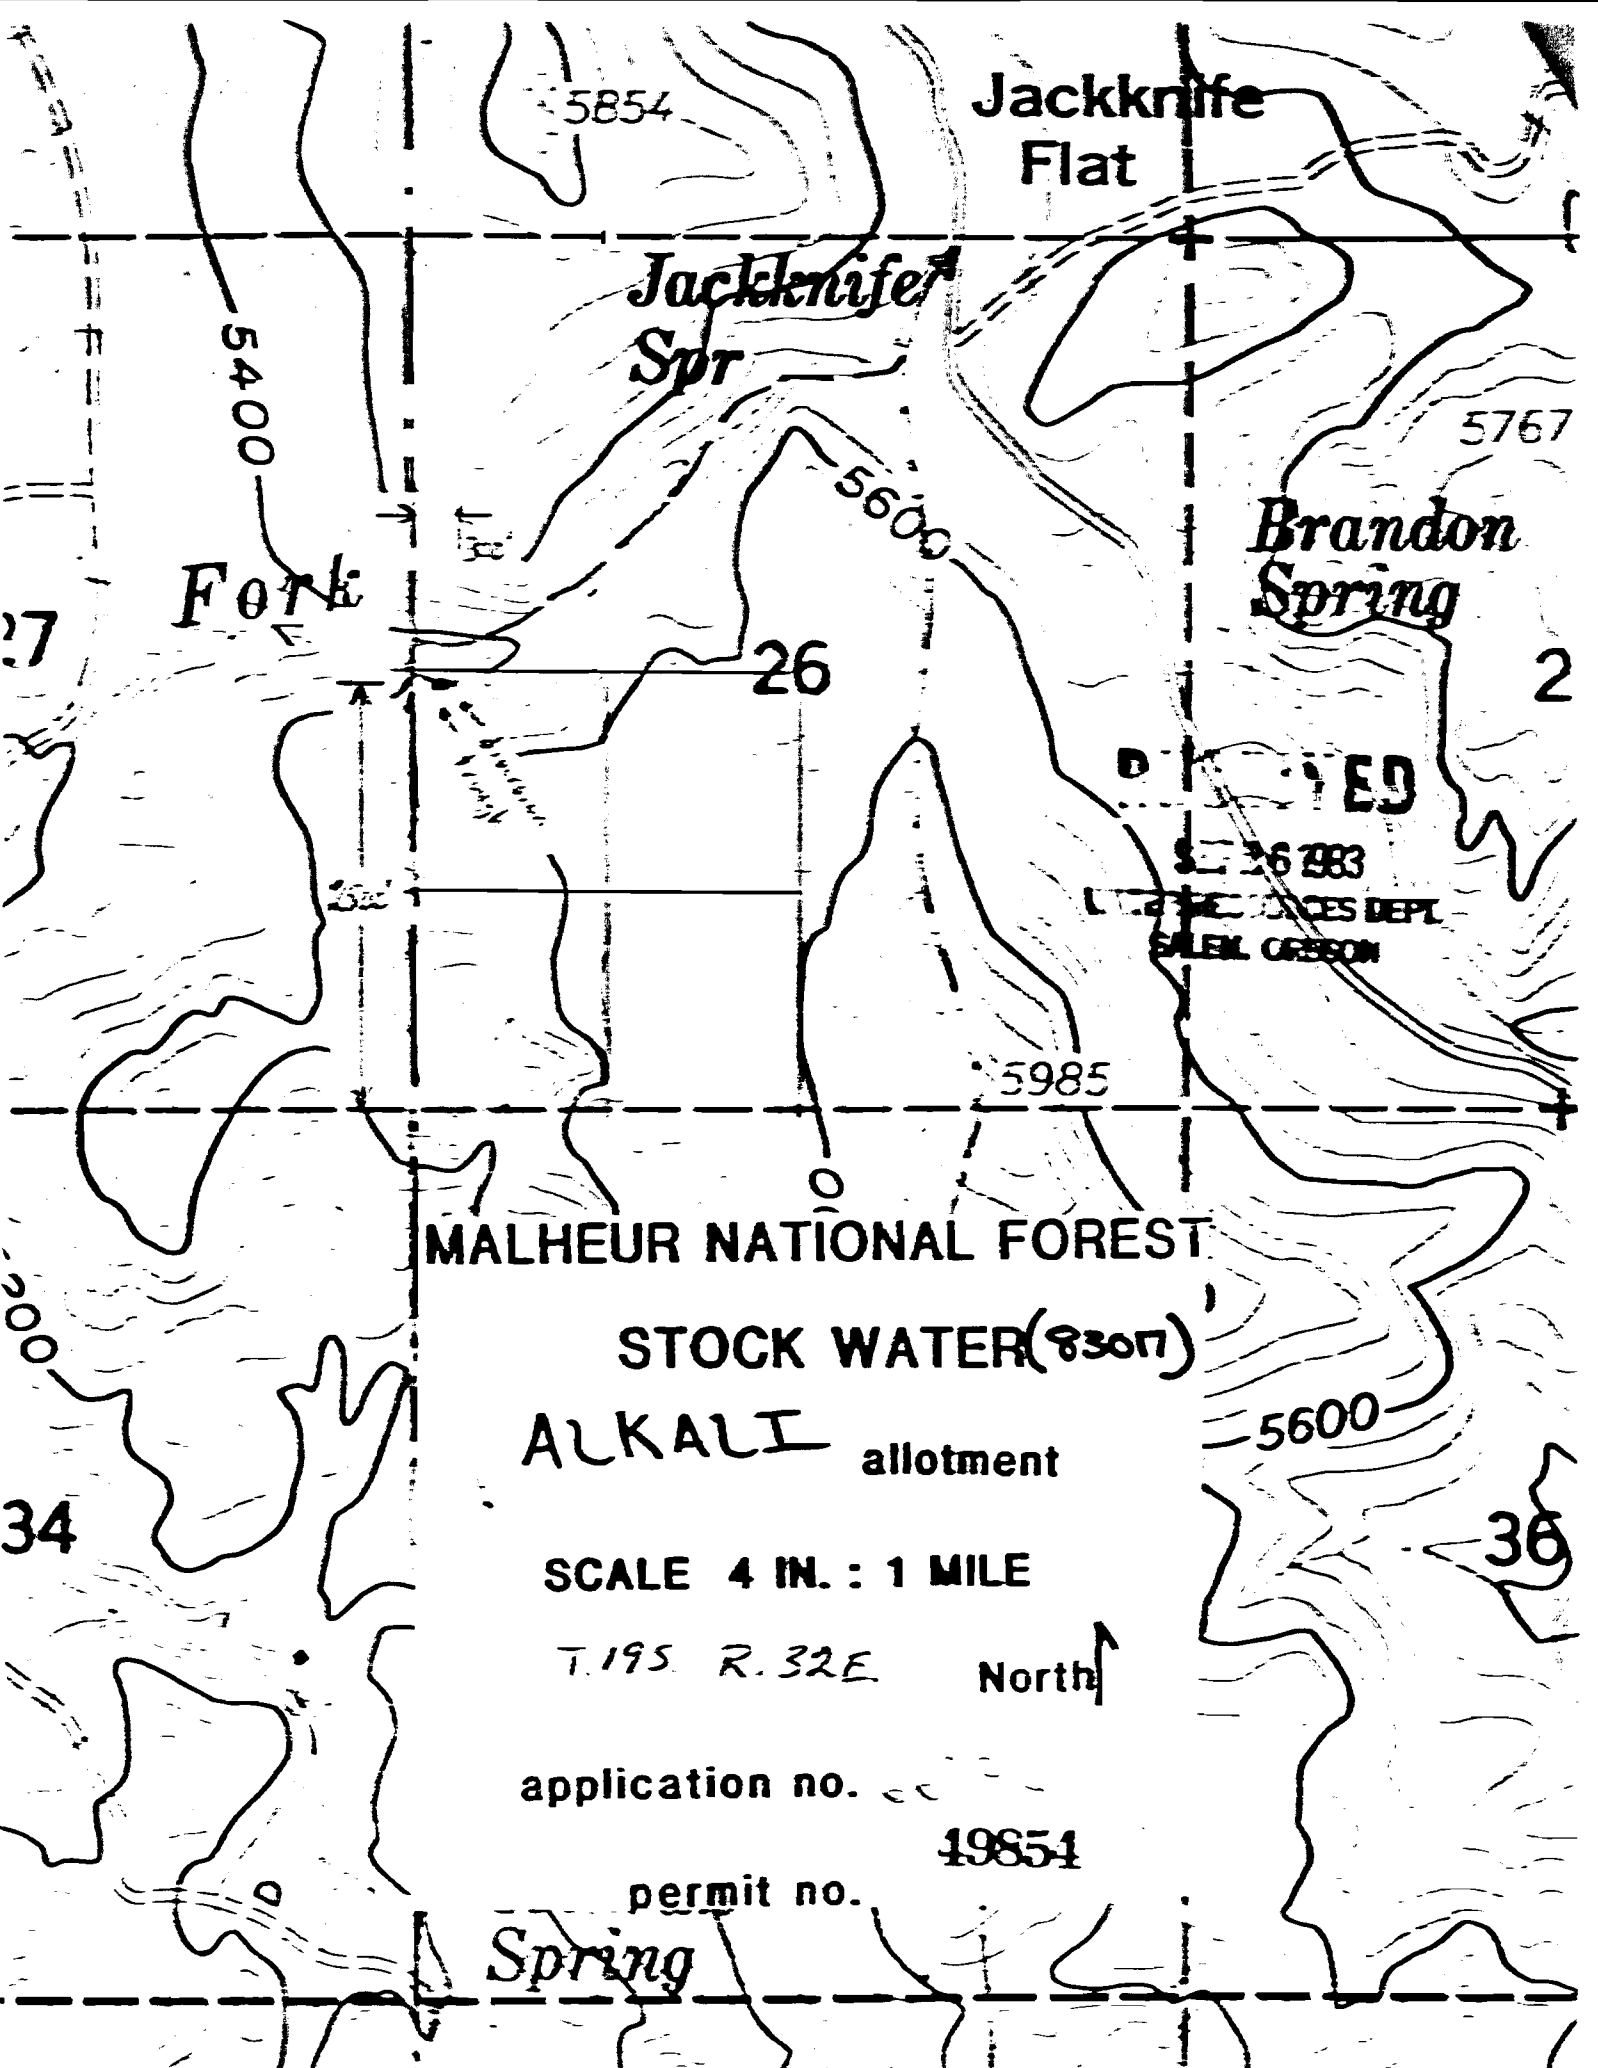

5854

Jackknife
Flat

Jackknife
Spr

5400

Fork

26

5600

Brandon
Spring

5767

2

SALEM, OREGON

5985

MALHEUR NATIONAL FOREST

STOCK WATER (8307)

ALKALI allotment

SCALE 4 IN. : 1 MILE

T. 19S R. 32E

North

application no.

19854

permit no.

Spring

5600

36

34