


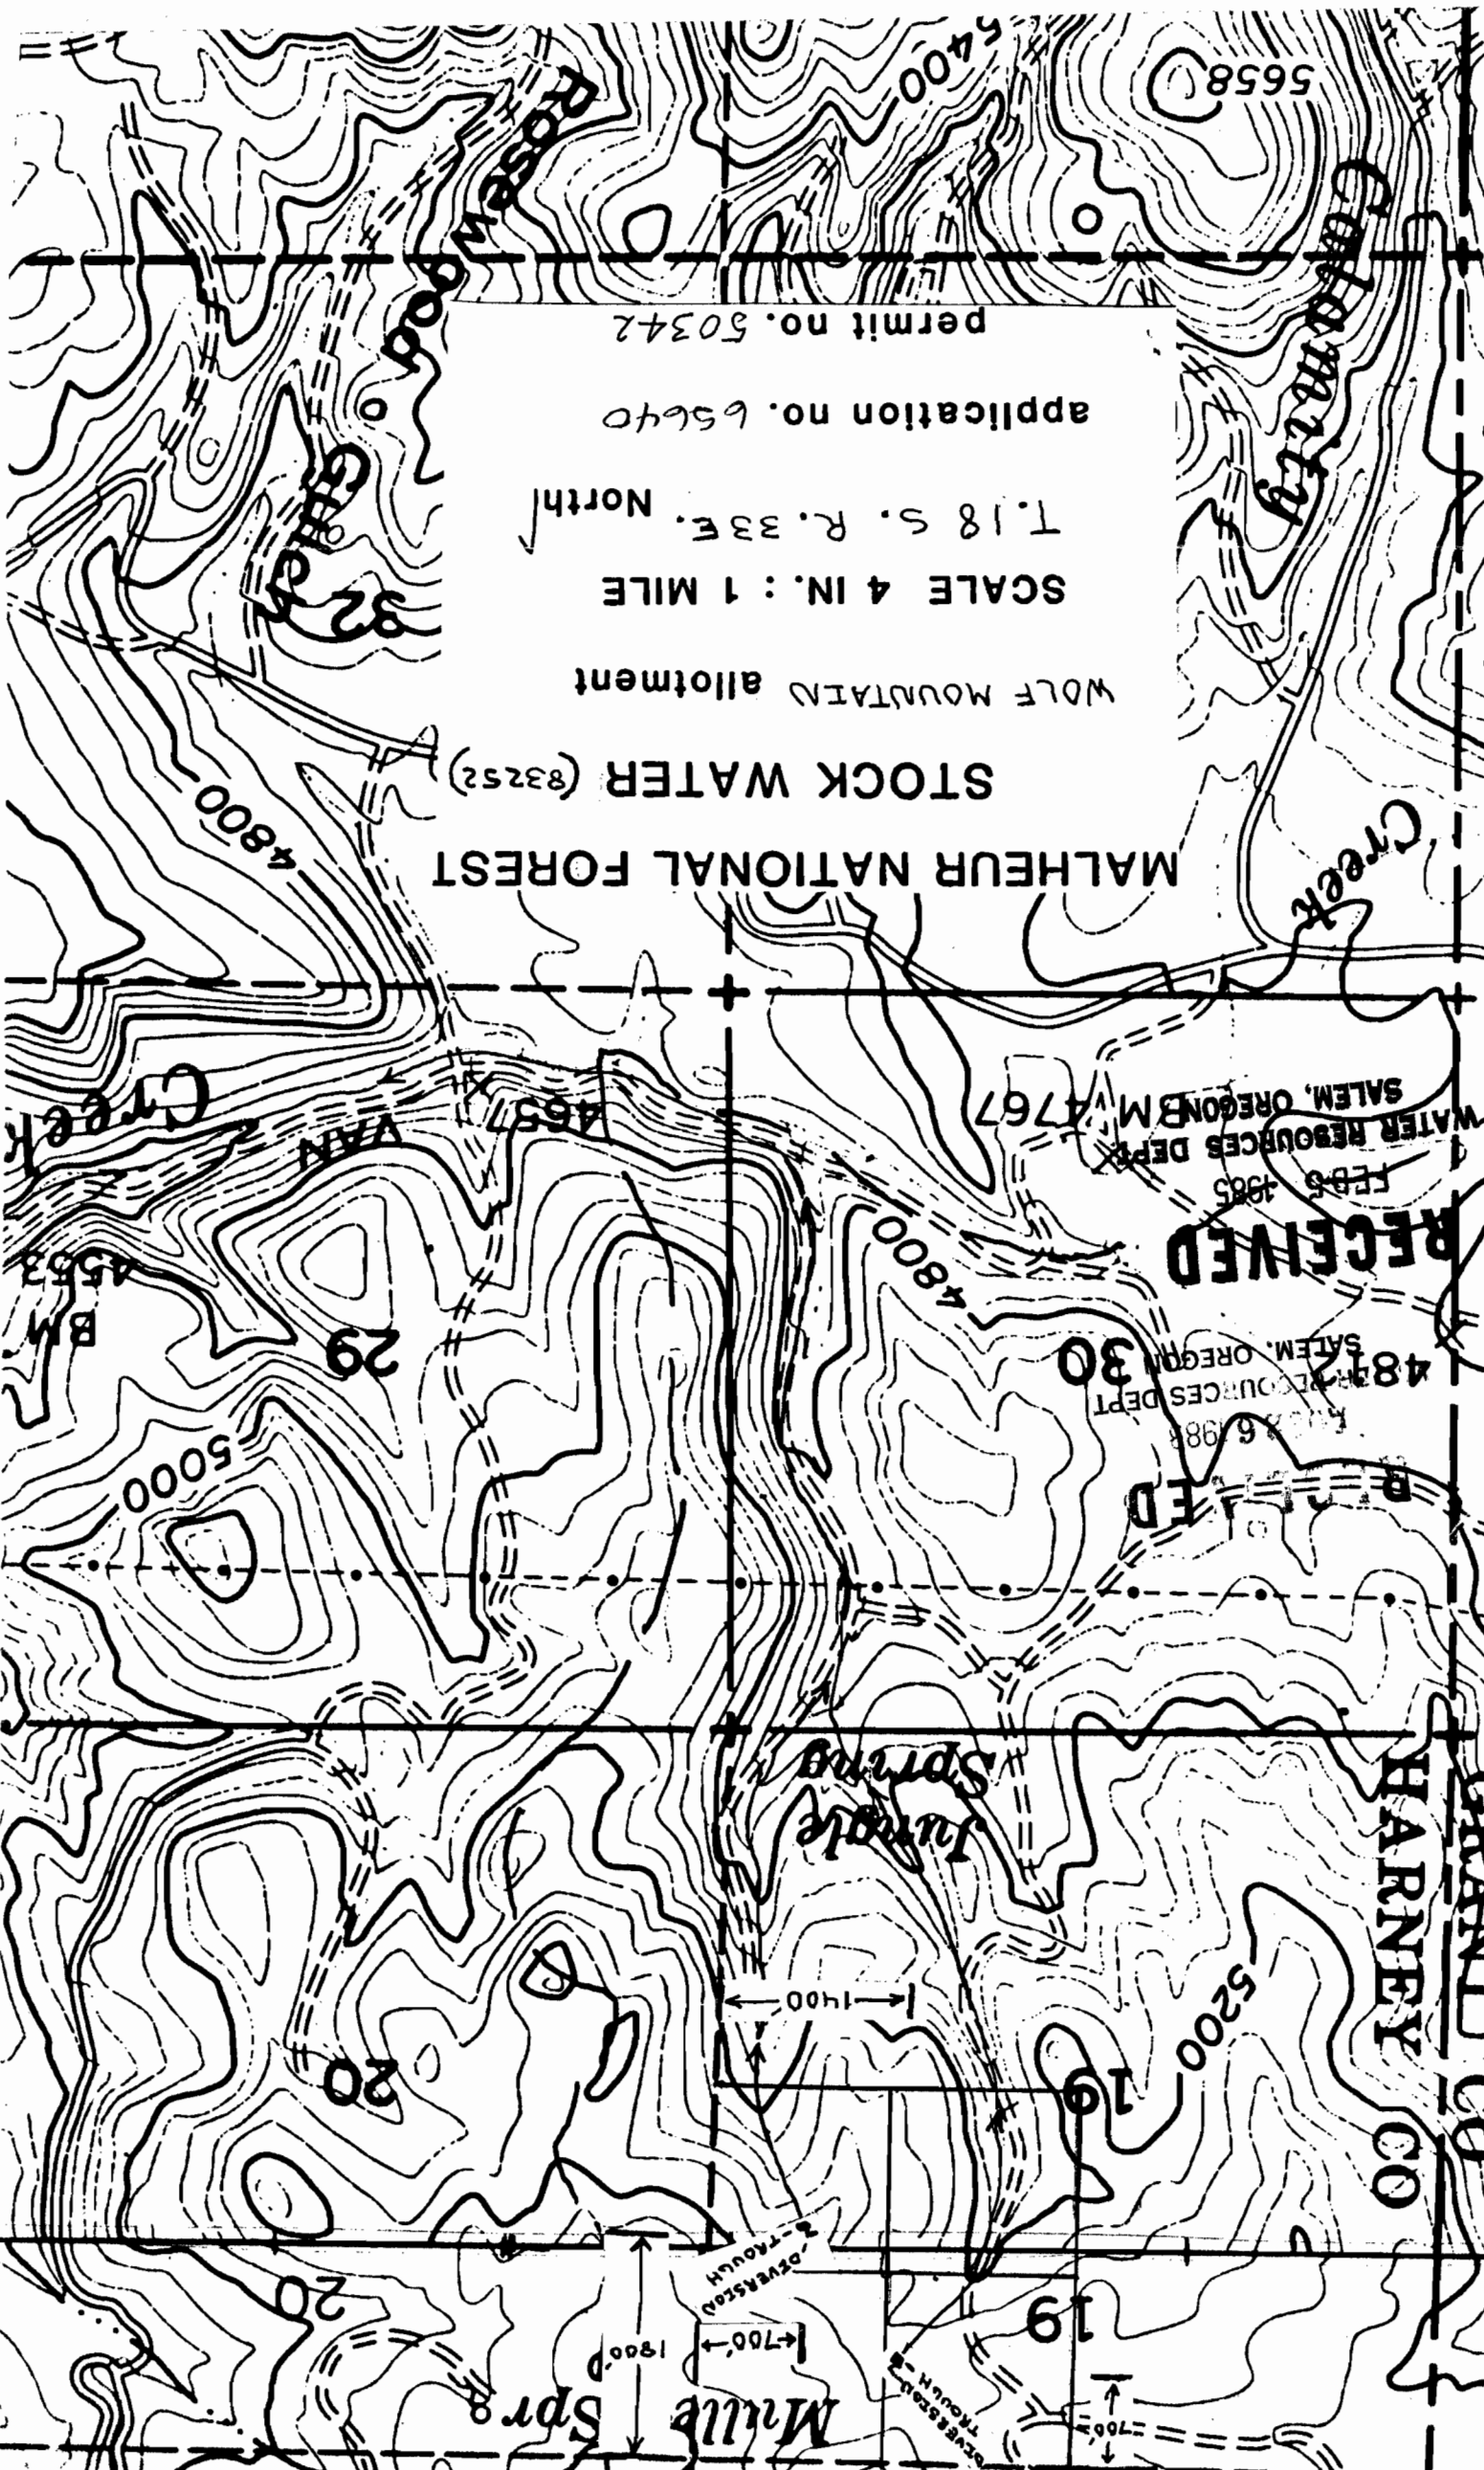

MALHEUR NATIONAL FOREST
STOCK WATER (83252)

SCALE 4 IN. : 1 MILE
T. 18 S. R. 33 E. North

application no. 65640
permit no. 50342

WOLF MOUNTAIN allotment

RECEIVED

4812
FEB 6 1988
WATER RESOURCES DEPT
SALEM, OREGON

RECEIVED

GRANT CO
HARNEY CO

Jungle Springs

Mule Spr.


700'

1400'

700'

1900'