

RECEIVED

FEB 6 1985


WATER RESOURCES DEPT.
SALEM, OREGON

RECEIVED

FEB 6 1983

WATER RESOURCES DEPT.
SALEM, OREGON

Crazy Spr

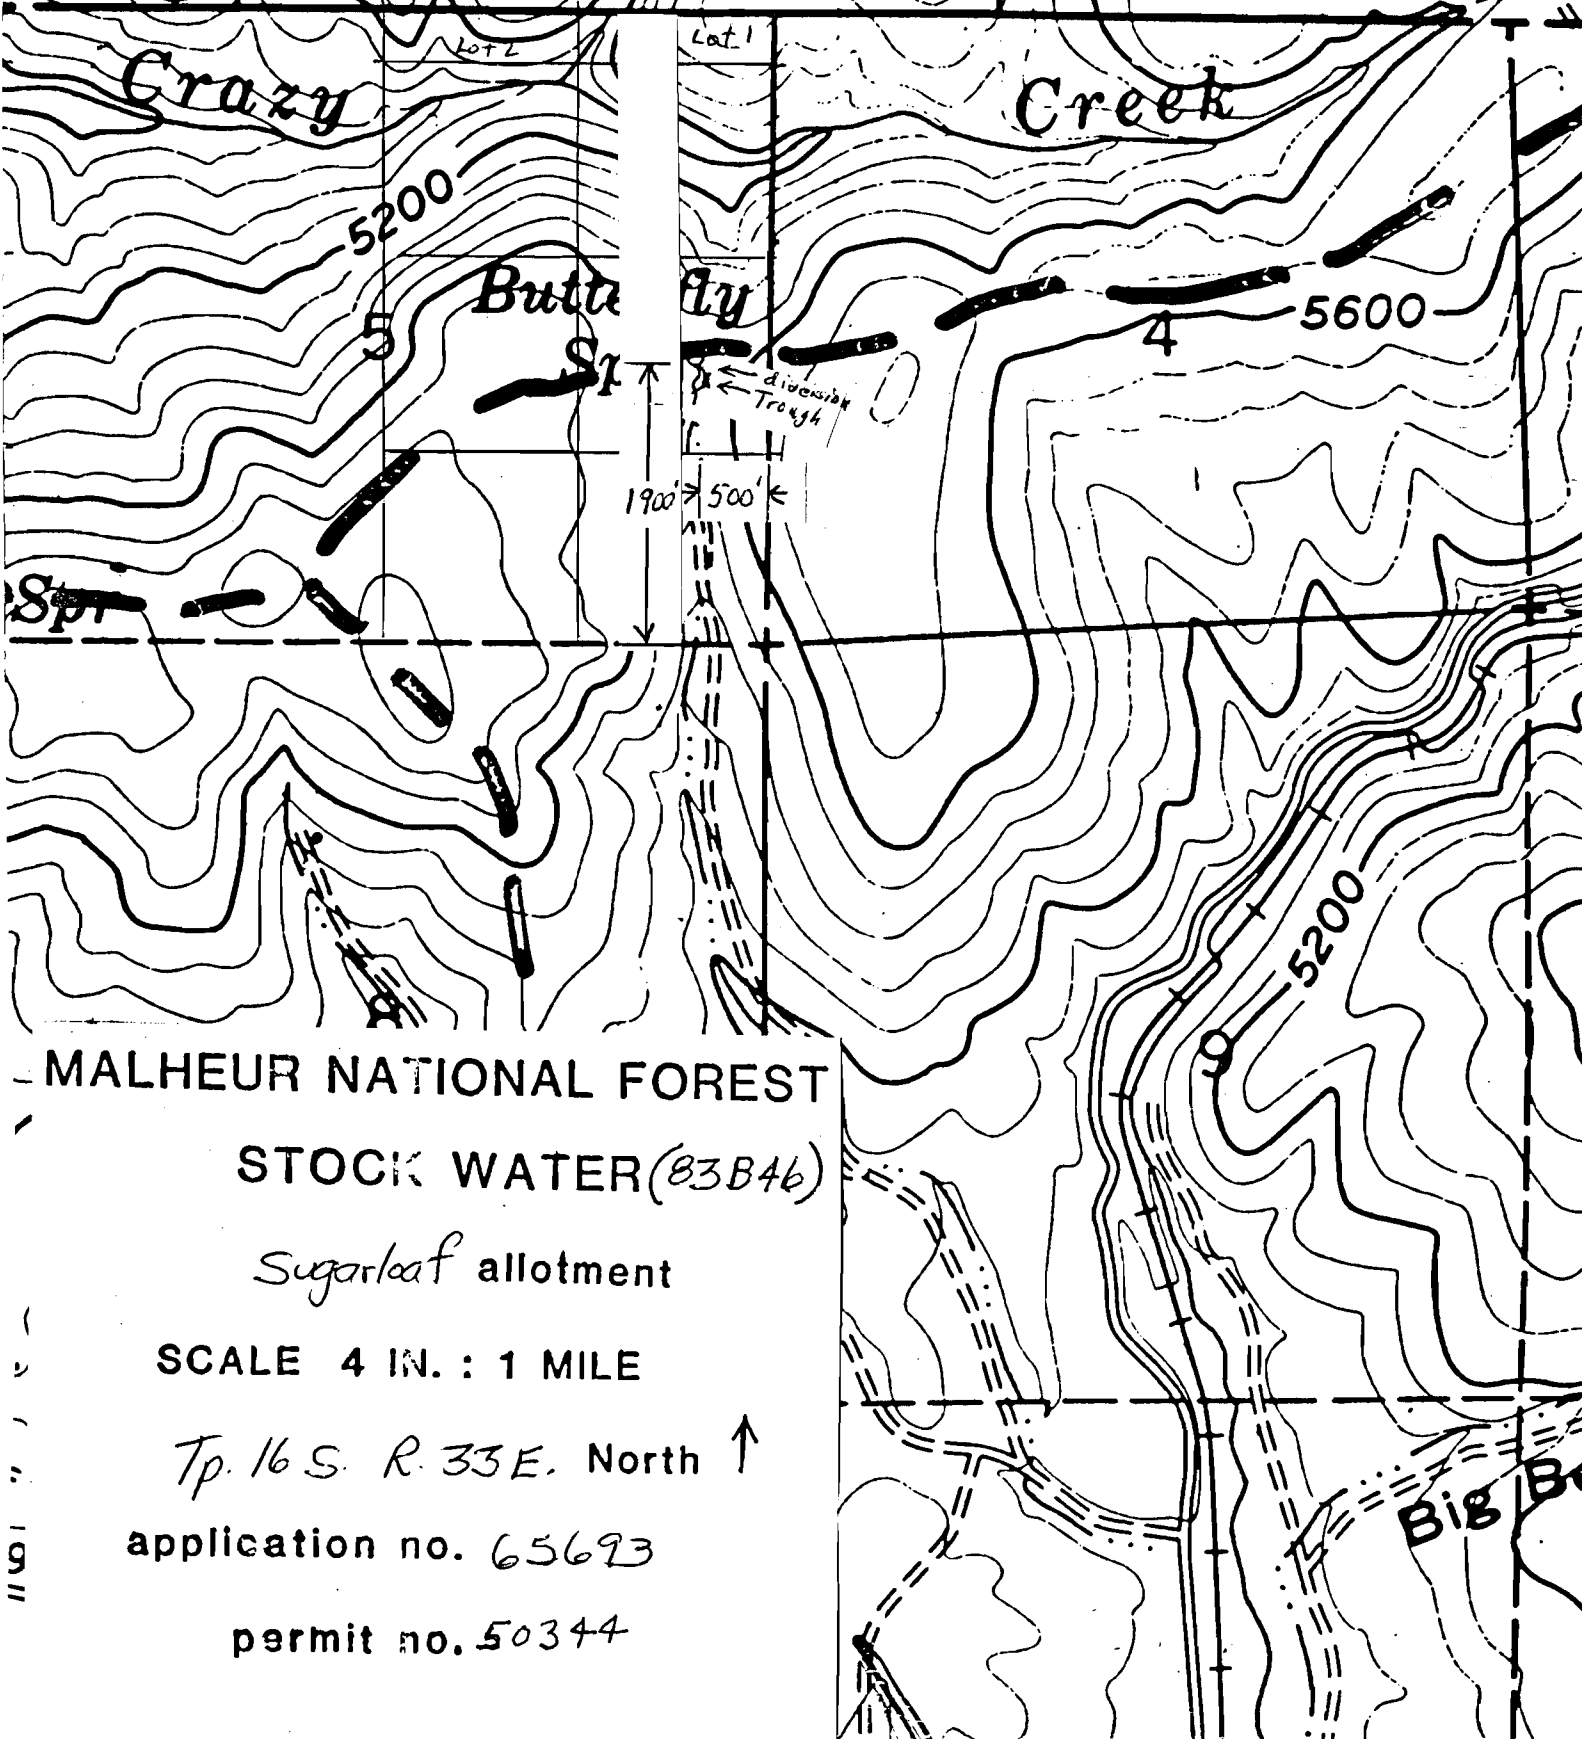

MALHEUR NATIONAL FOREST

STOCK WATER (83B46)

Sugarloaf allotment

SCALE 4 IN. : 1 MILE

Tp. 16 S. R. 33 E. North ↑

application no. 65693

permit no. 50344