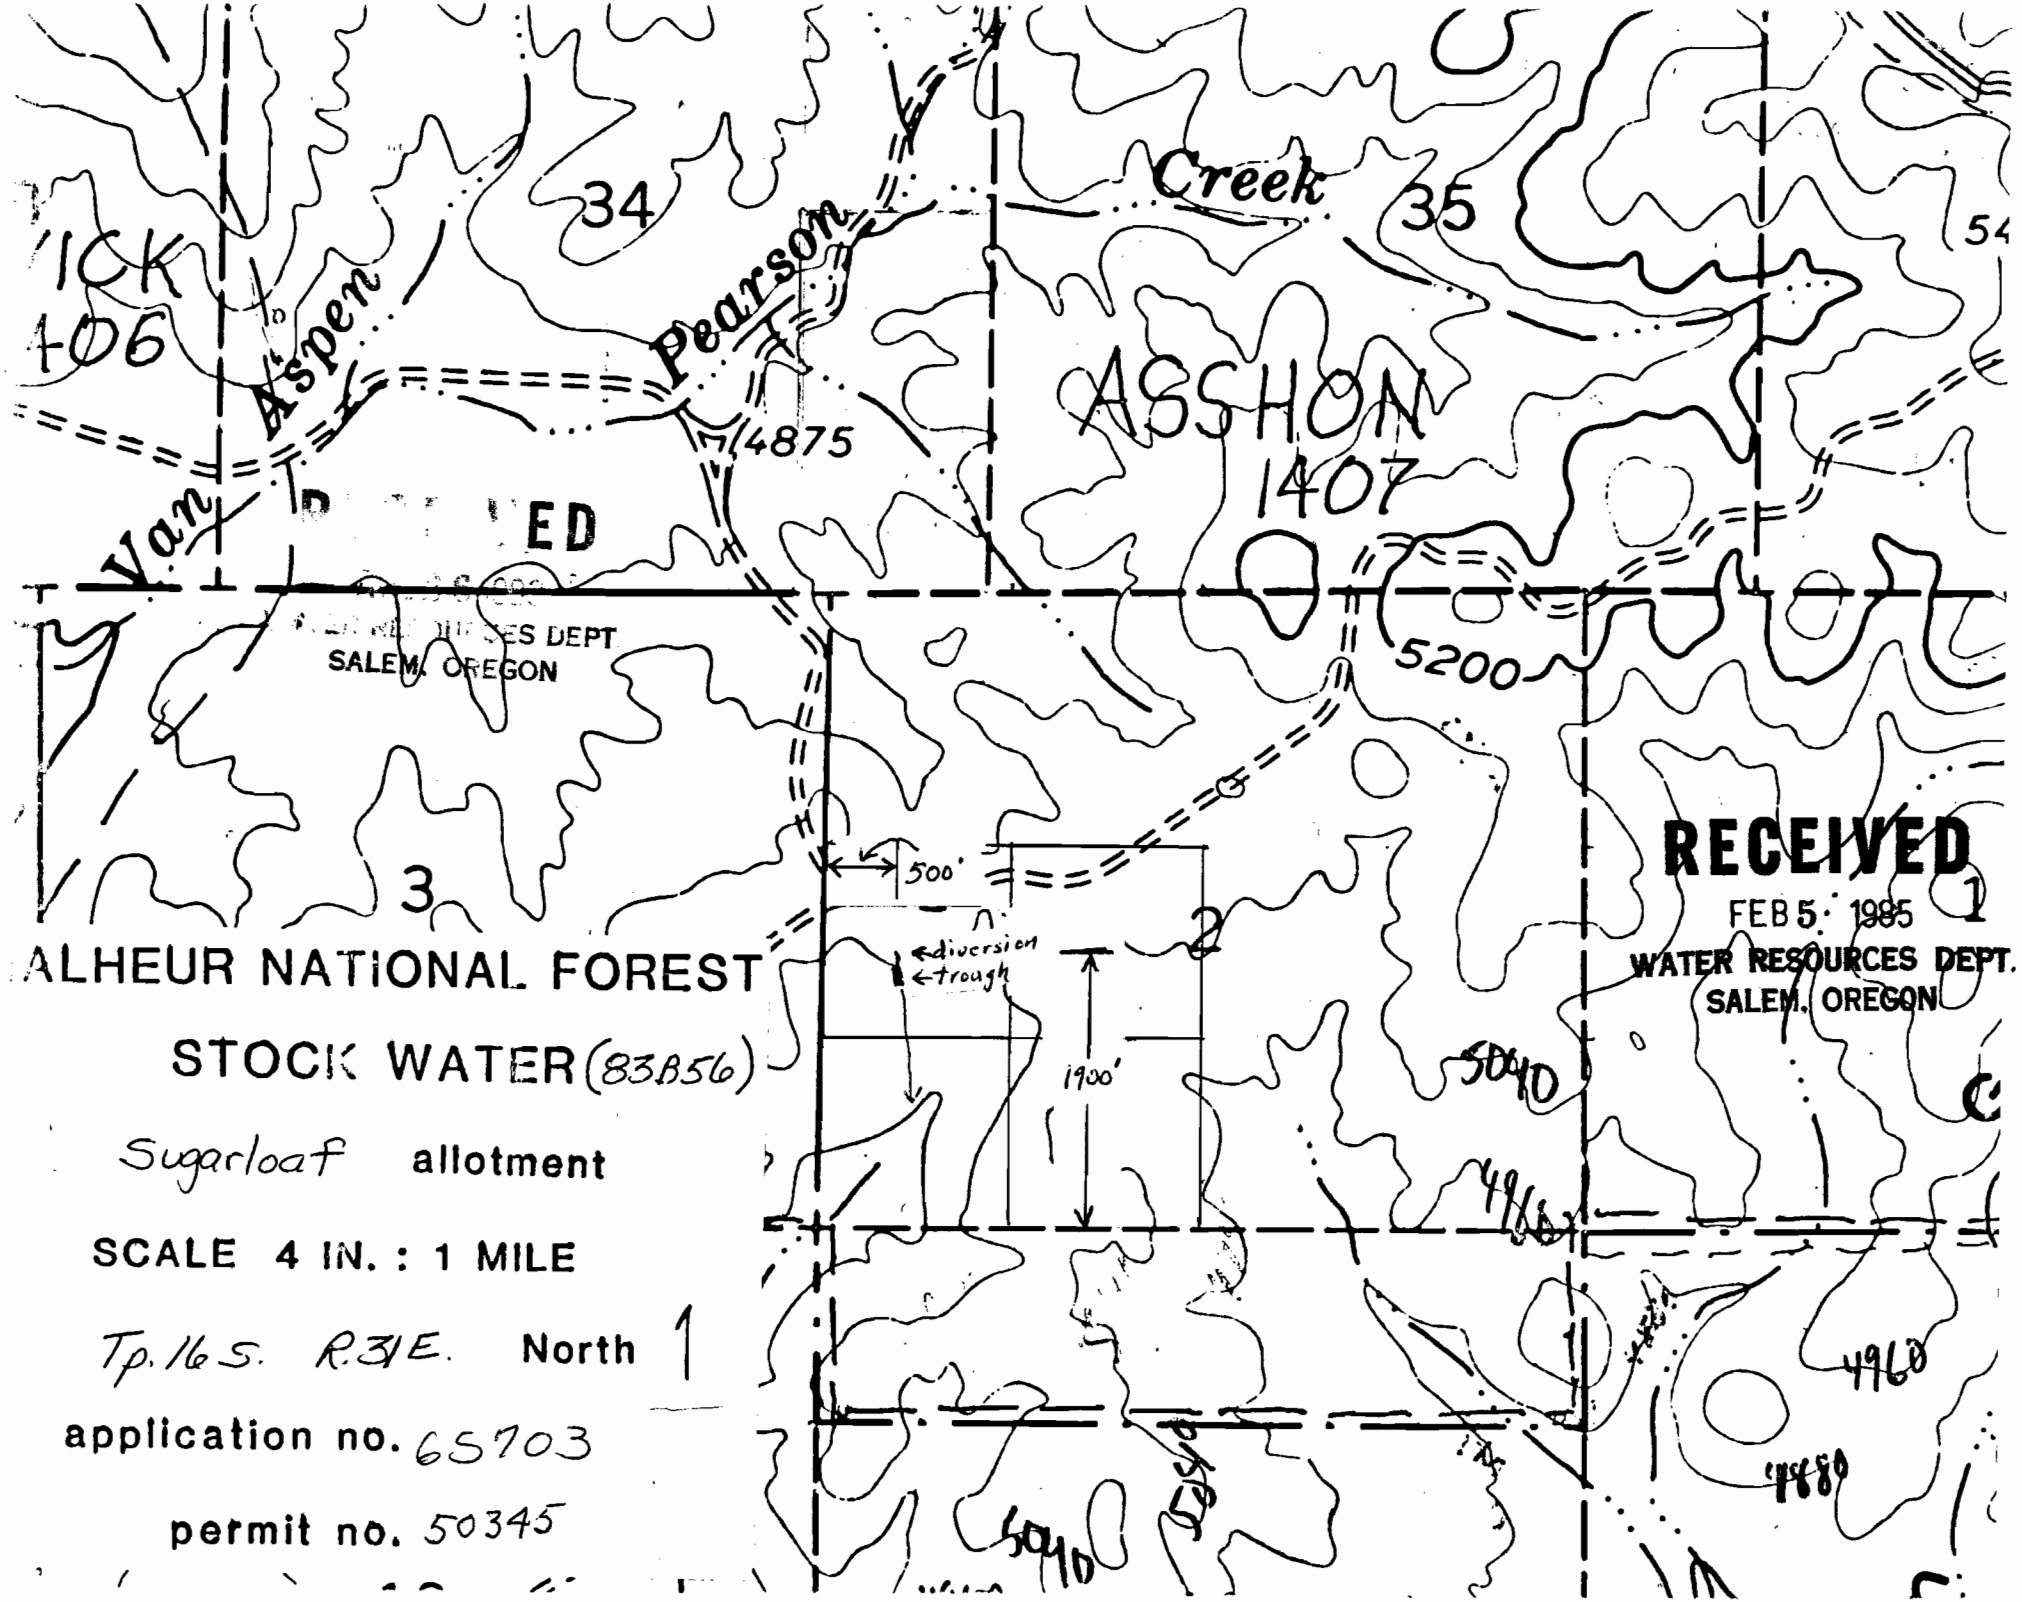

ALHEUR NATIONAL FOREST

STOCK WATER (83B56)

Sugarloaf allotment

SCALE 4 IN. : 1 MILE

Tp. 16 S. R. 31 E. North

application no. 65703

permit no. 50345