


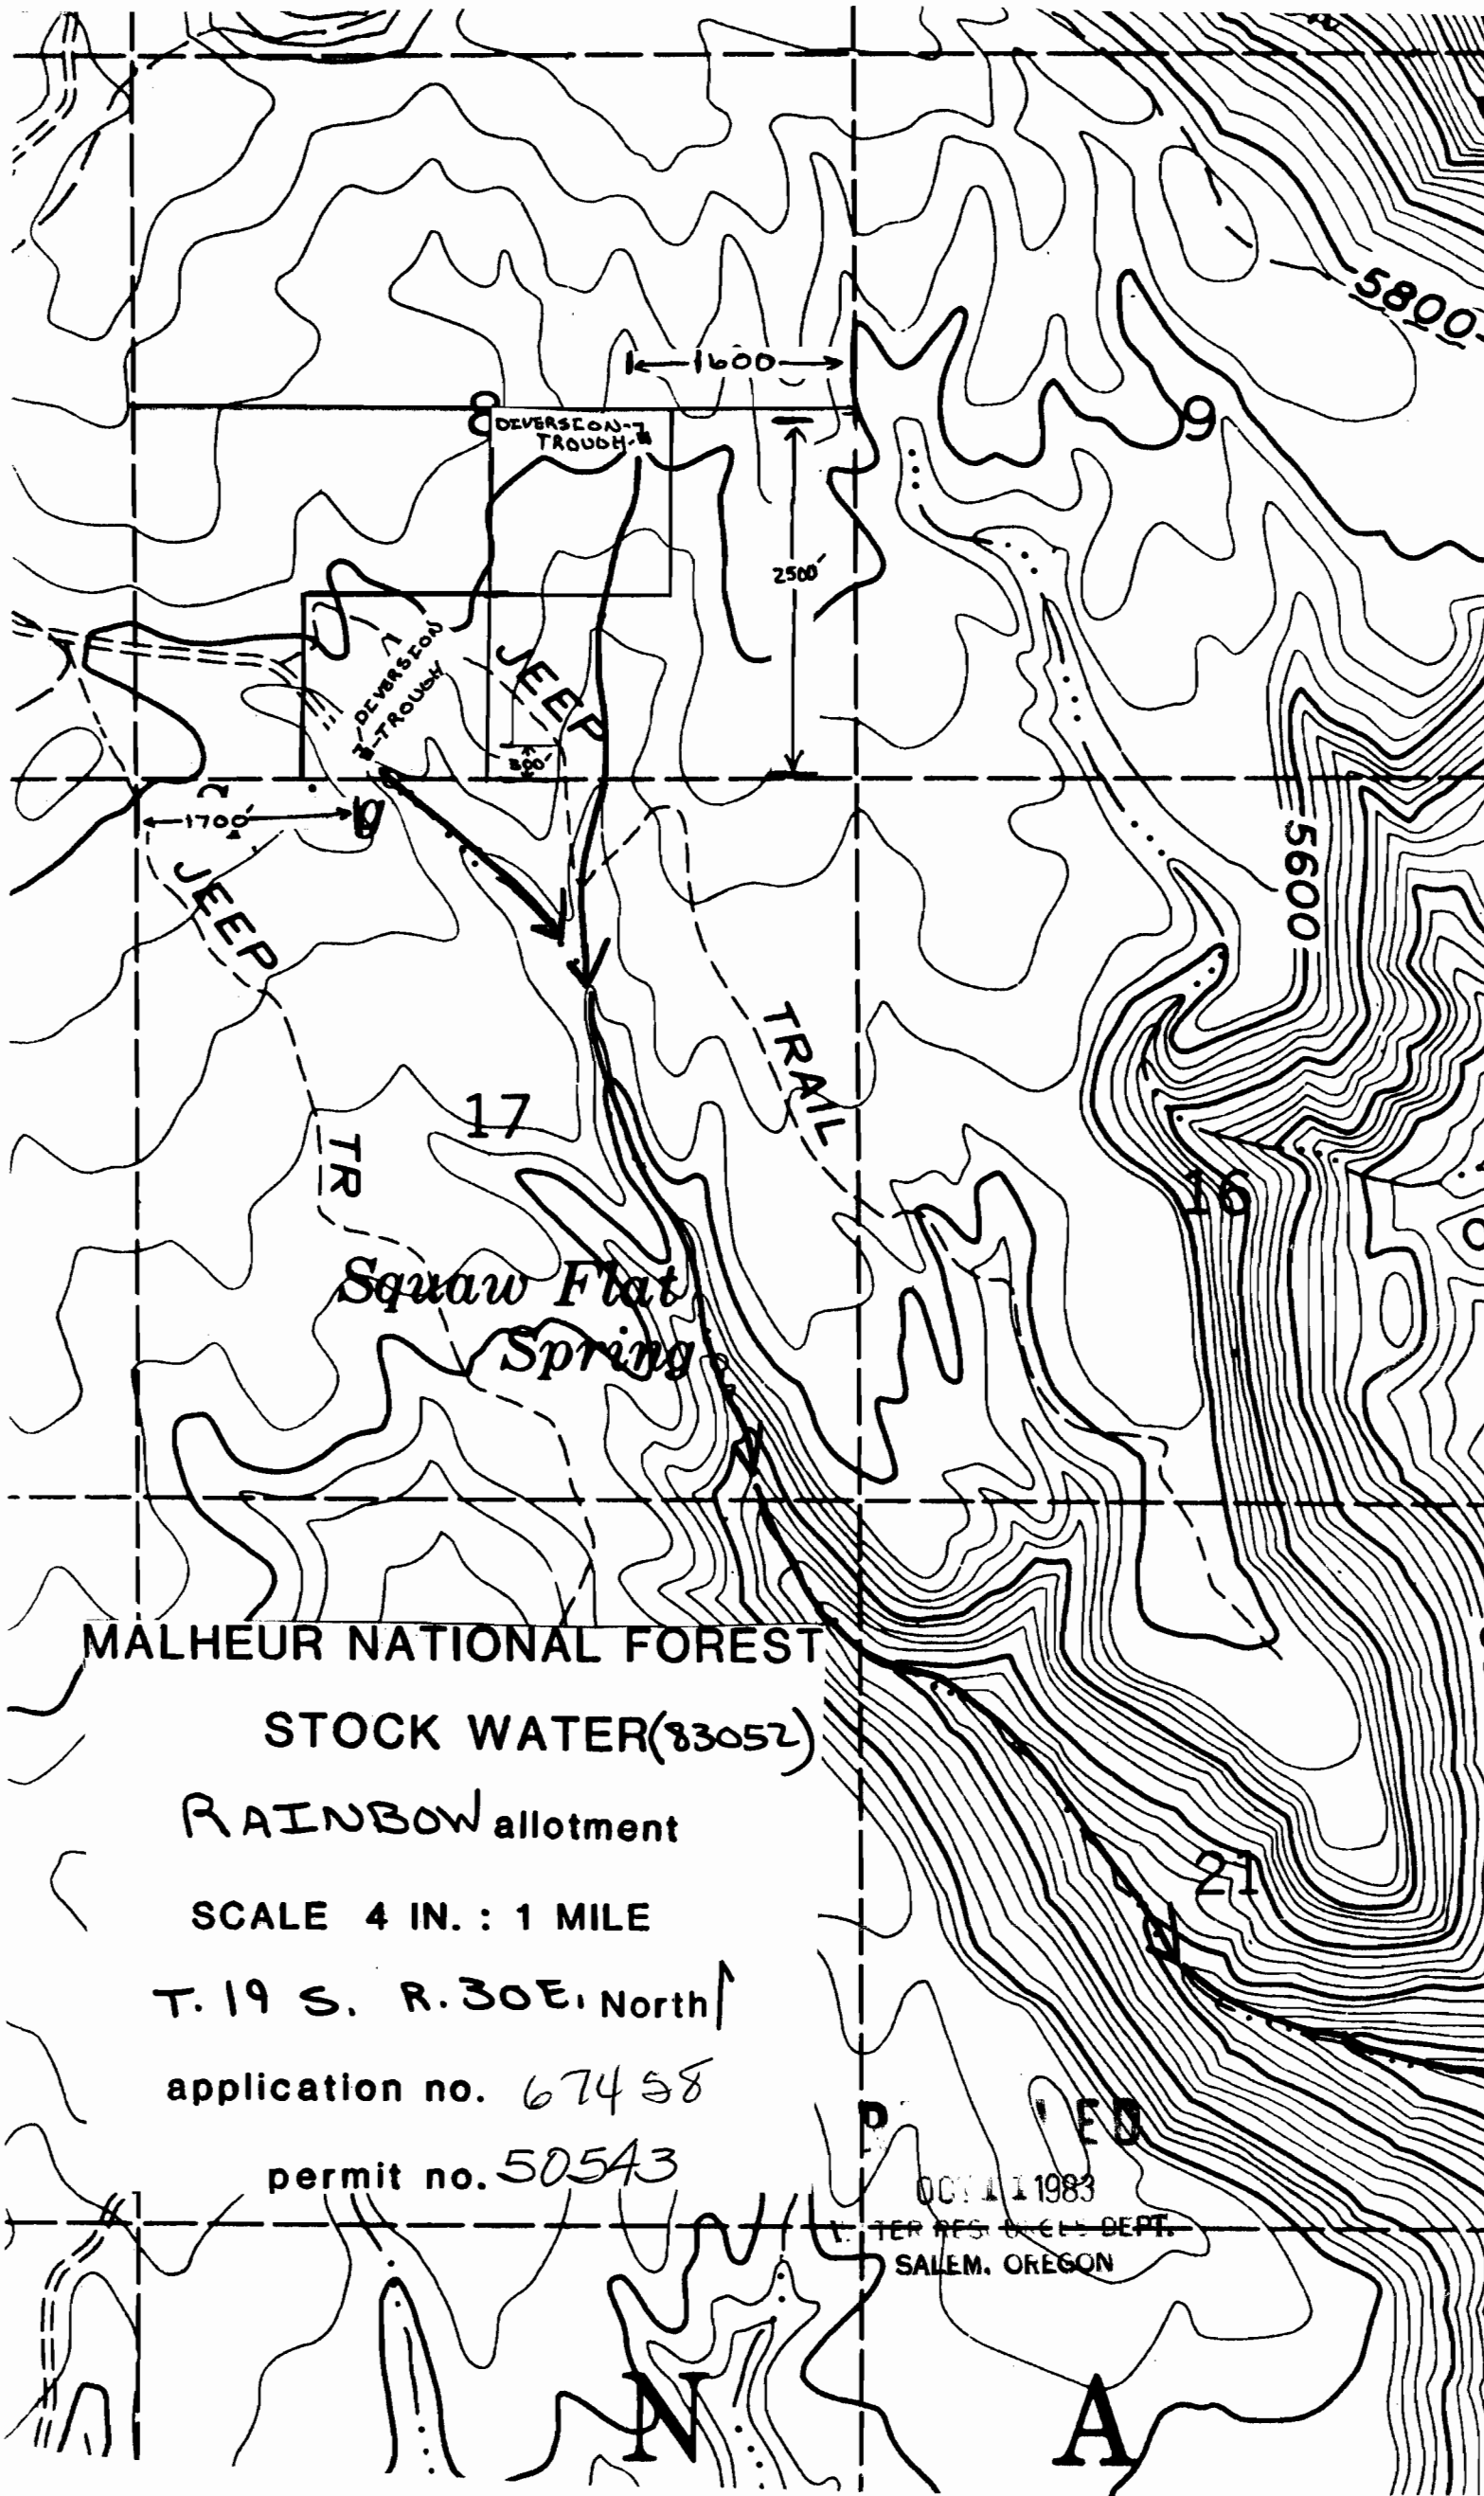

MALHEUR NATIONAL FOREST

STOCK WATER(83052)

RAINBOW allotment

SCALE 4 IN. : 1 MILE

T. 19 S. R. 30 E. North

application no. 67458

permit no. 50543

P E D

OCT 11 1983

TER RES. & GEN. DEPT.
SALEM, OREGON

N

A