


Form A1-187
March 1961

UNITED STATES
DEPARTMENT OF THE INTERIOR
BUREAU OF LAND MANAGEMENT

SECTION
SE 1/4 SE 1/4
Sec 20

Oregon State Water Filings

TOWNSHIP 21S, RANGE 31E, W. M.

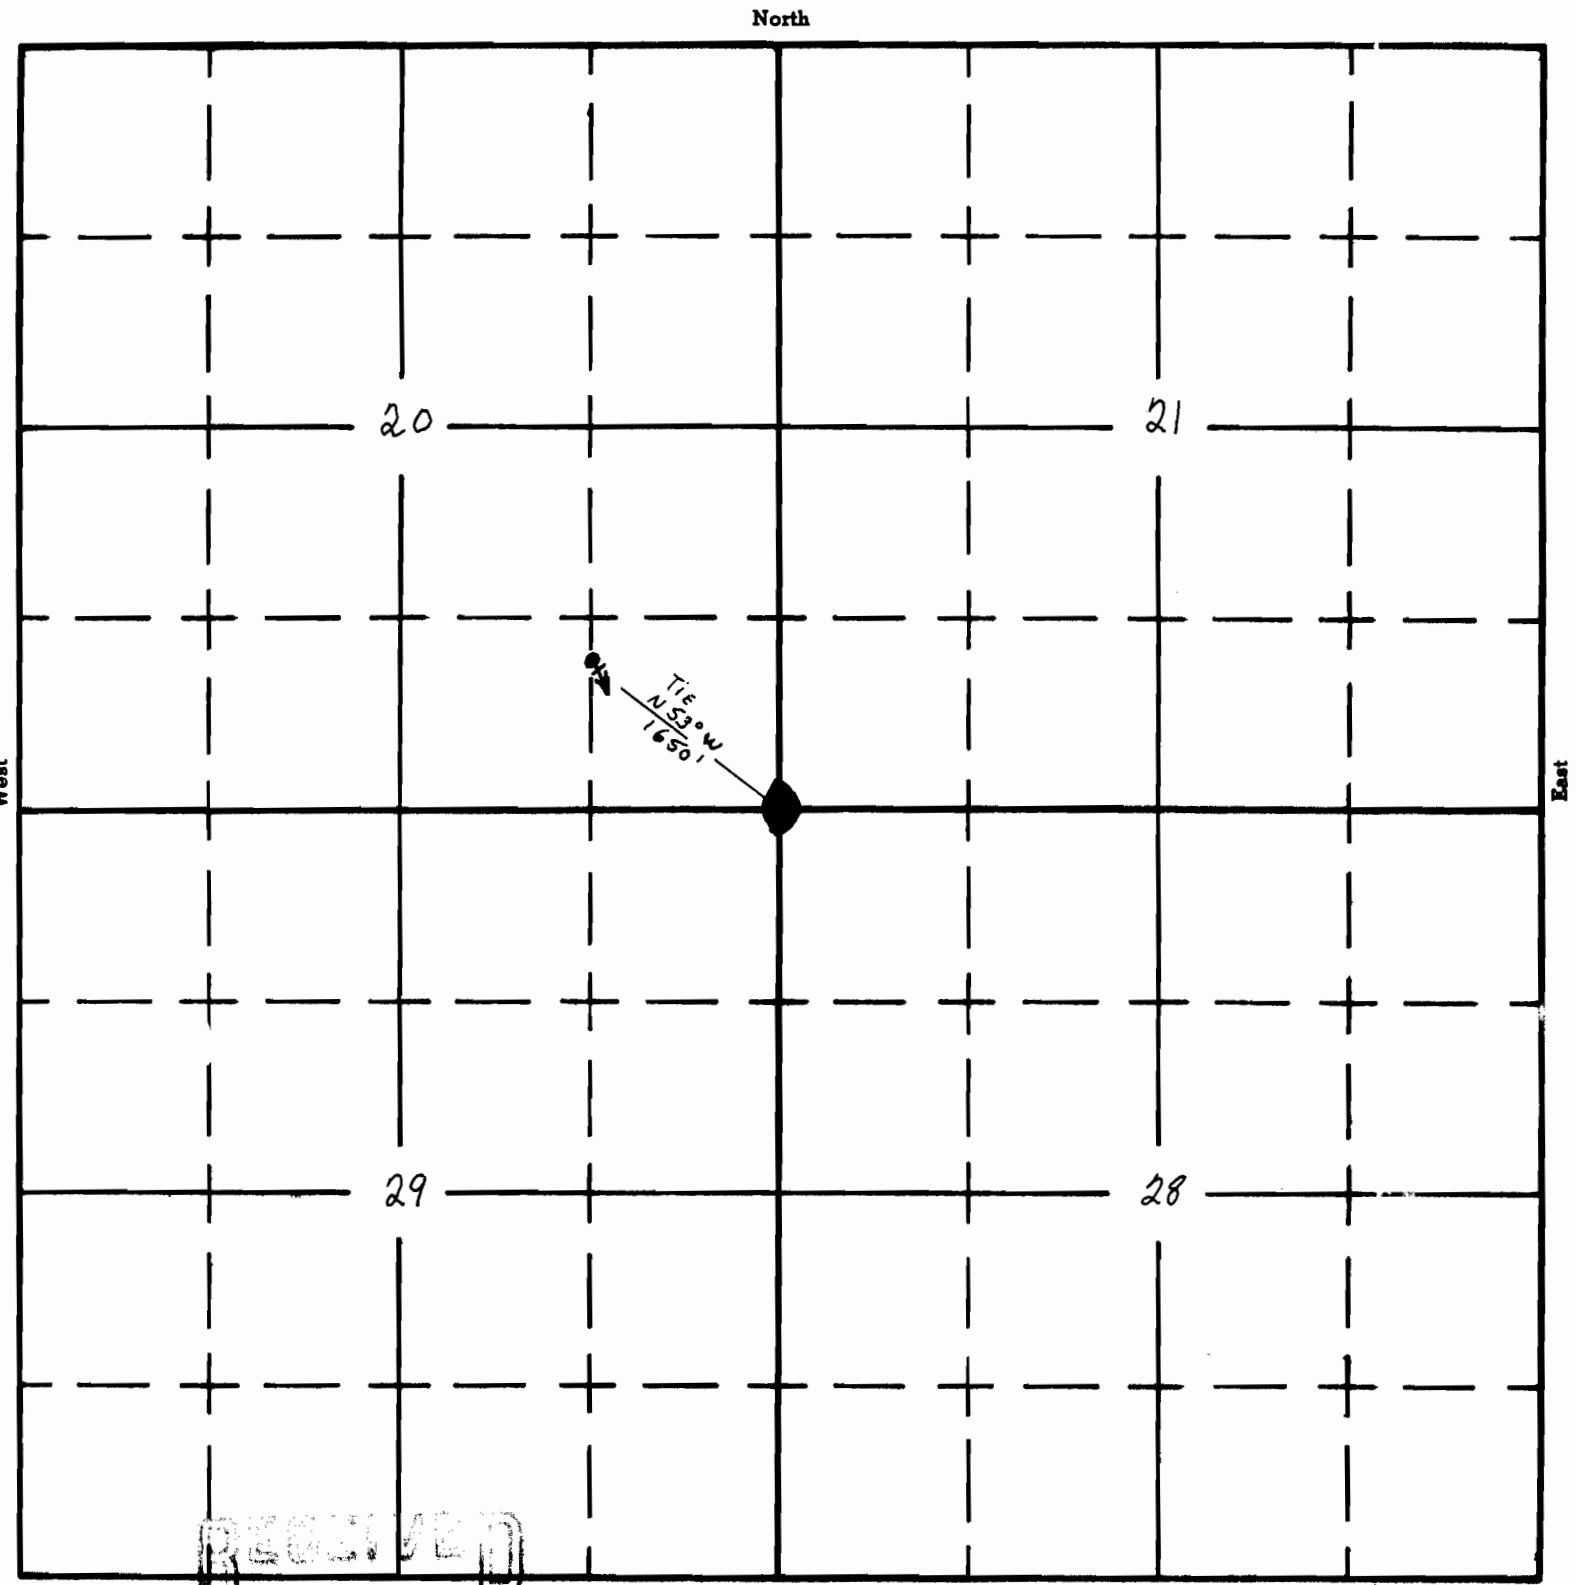

RECEIVED
MAR - 5 1962
STATE ENGINEER

APPLICATION No. 35383
PERMIT No. 28254