

Form A1-187
March 1961

UNITED STATES
DEPARTMENT OF THE INTERIOR
BUREAU OF LAND MANAGEMENT

SECTION


Oregon State Water Filings

Sw $\frac{1}{4}$

TOWNSHIP 22S, RANGE 36E, W. M.

Sec 28

North

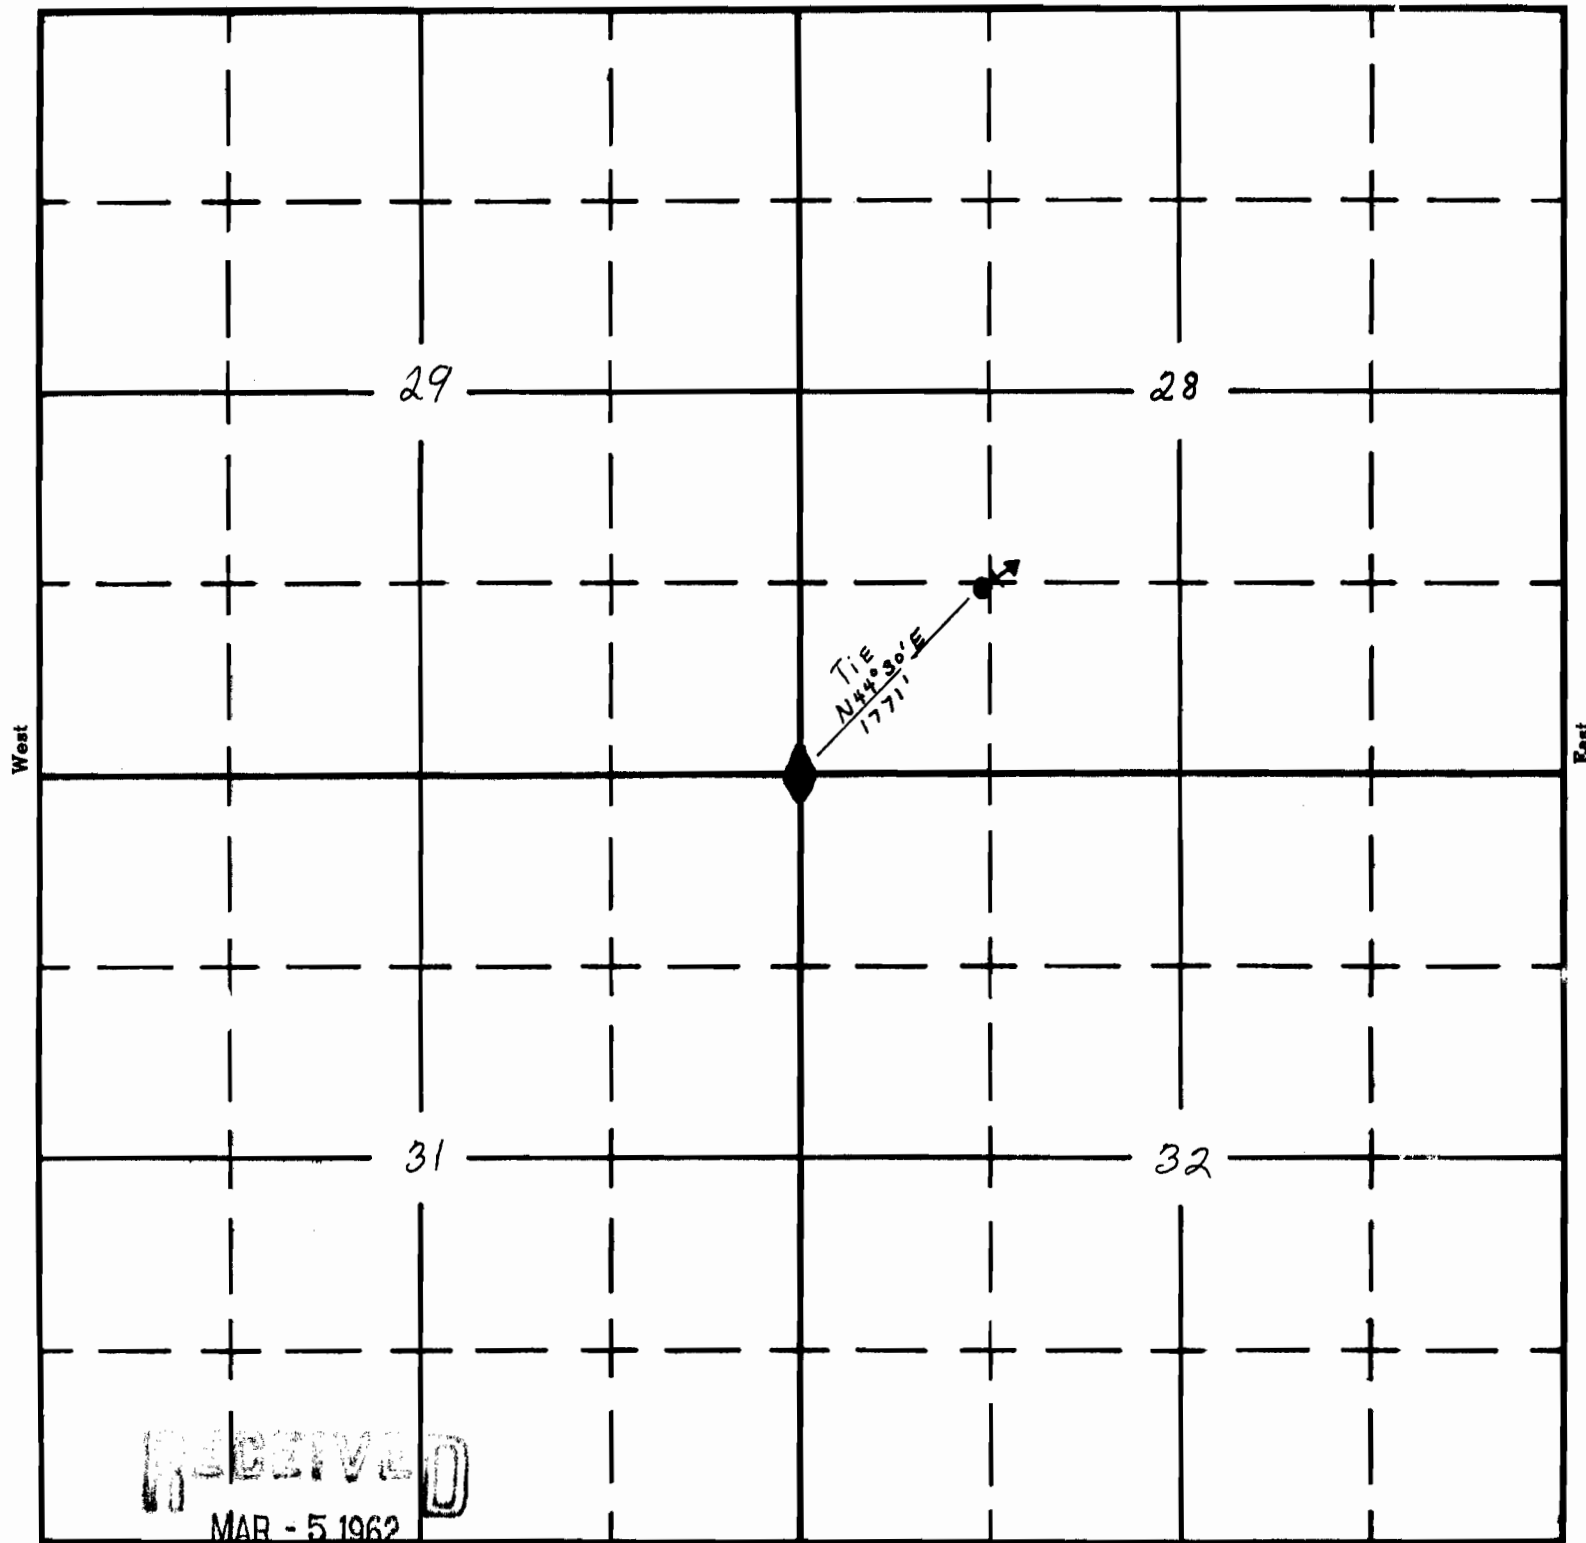

RECEIVED

MAR - 5 1962

STATE ENGINEER
B. L. M. OREGON

South

APPLICATION No. ~~35385~~ 35385

PERMIT No. 28255