


Form A1-187
March 1961

UNITED STATES
DEPARTMENT OF THE INTERIOR
BUREAU OF LAND MANAGEMENT

SECTION
NW¹/₄ NW¹/₄
Sec 21

Oregon State Water Filings
TOWNSHIP 22S, RANGE 36E, W. M.

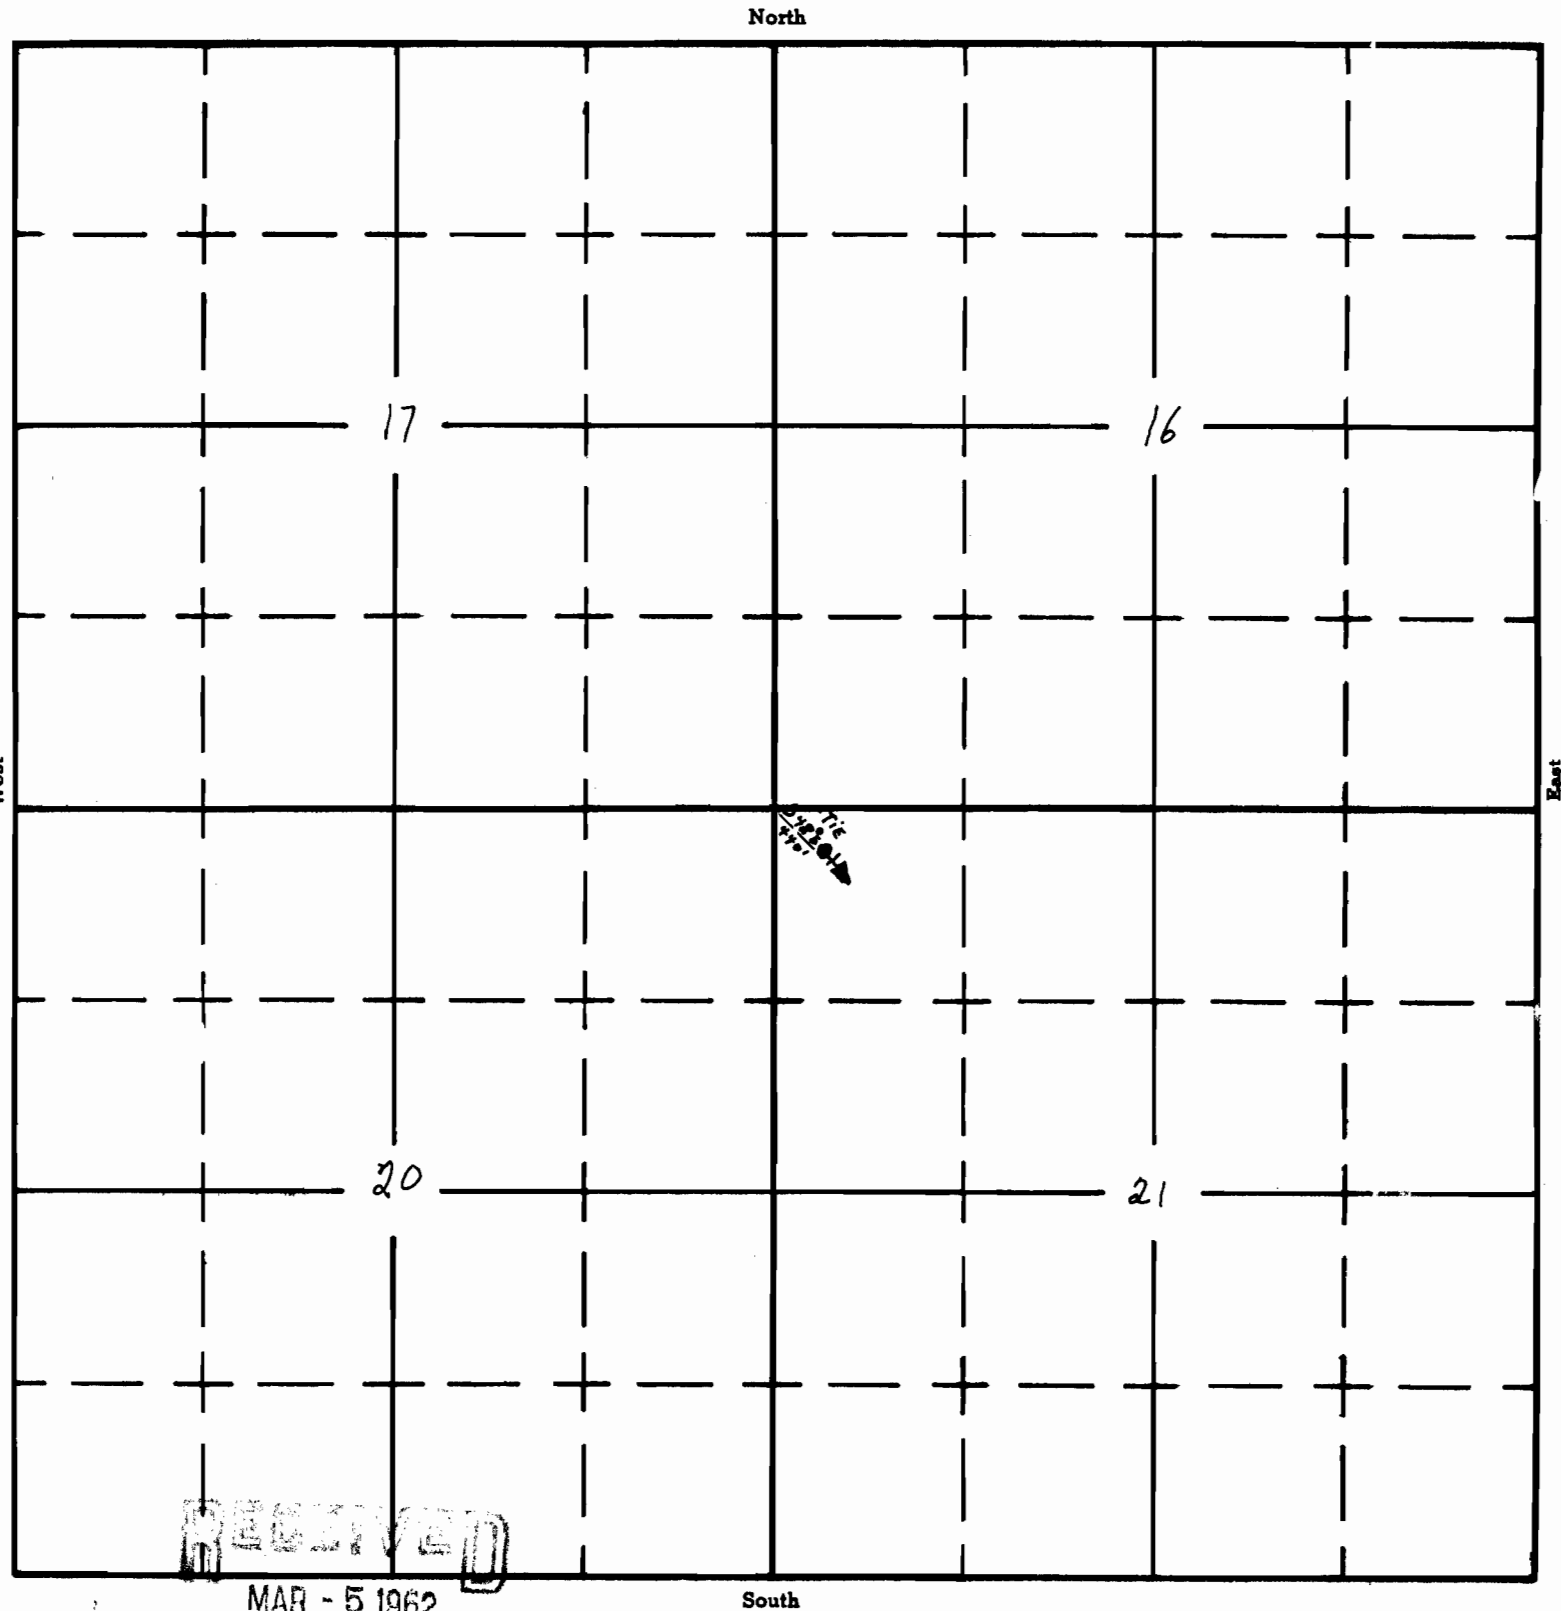

RECEIVED
MAR - 5 1962
STATE ENGINEER
SALEMAN

APPLICATION No. 35386
PERMIT No. 28256