

Form A1-187
March 1961


UNITED STATES
DEPARTMENT OF THE INTERIOR
BUREAU OF LAND MANAGEMENT

SECTION

Oregon State Water Filings

SW 1/4 SE 1/4
Sec 12

TOWNSHIP 21S, RANGE 36E, W. M.

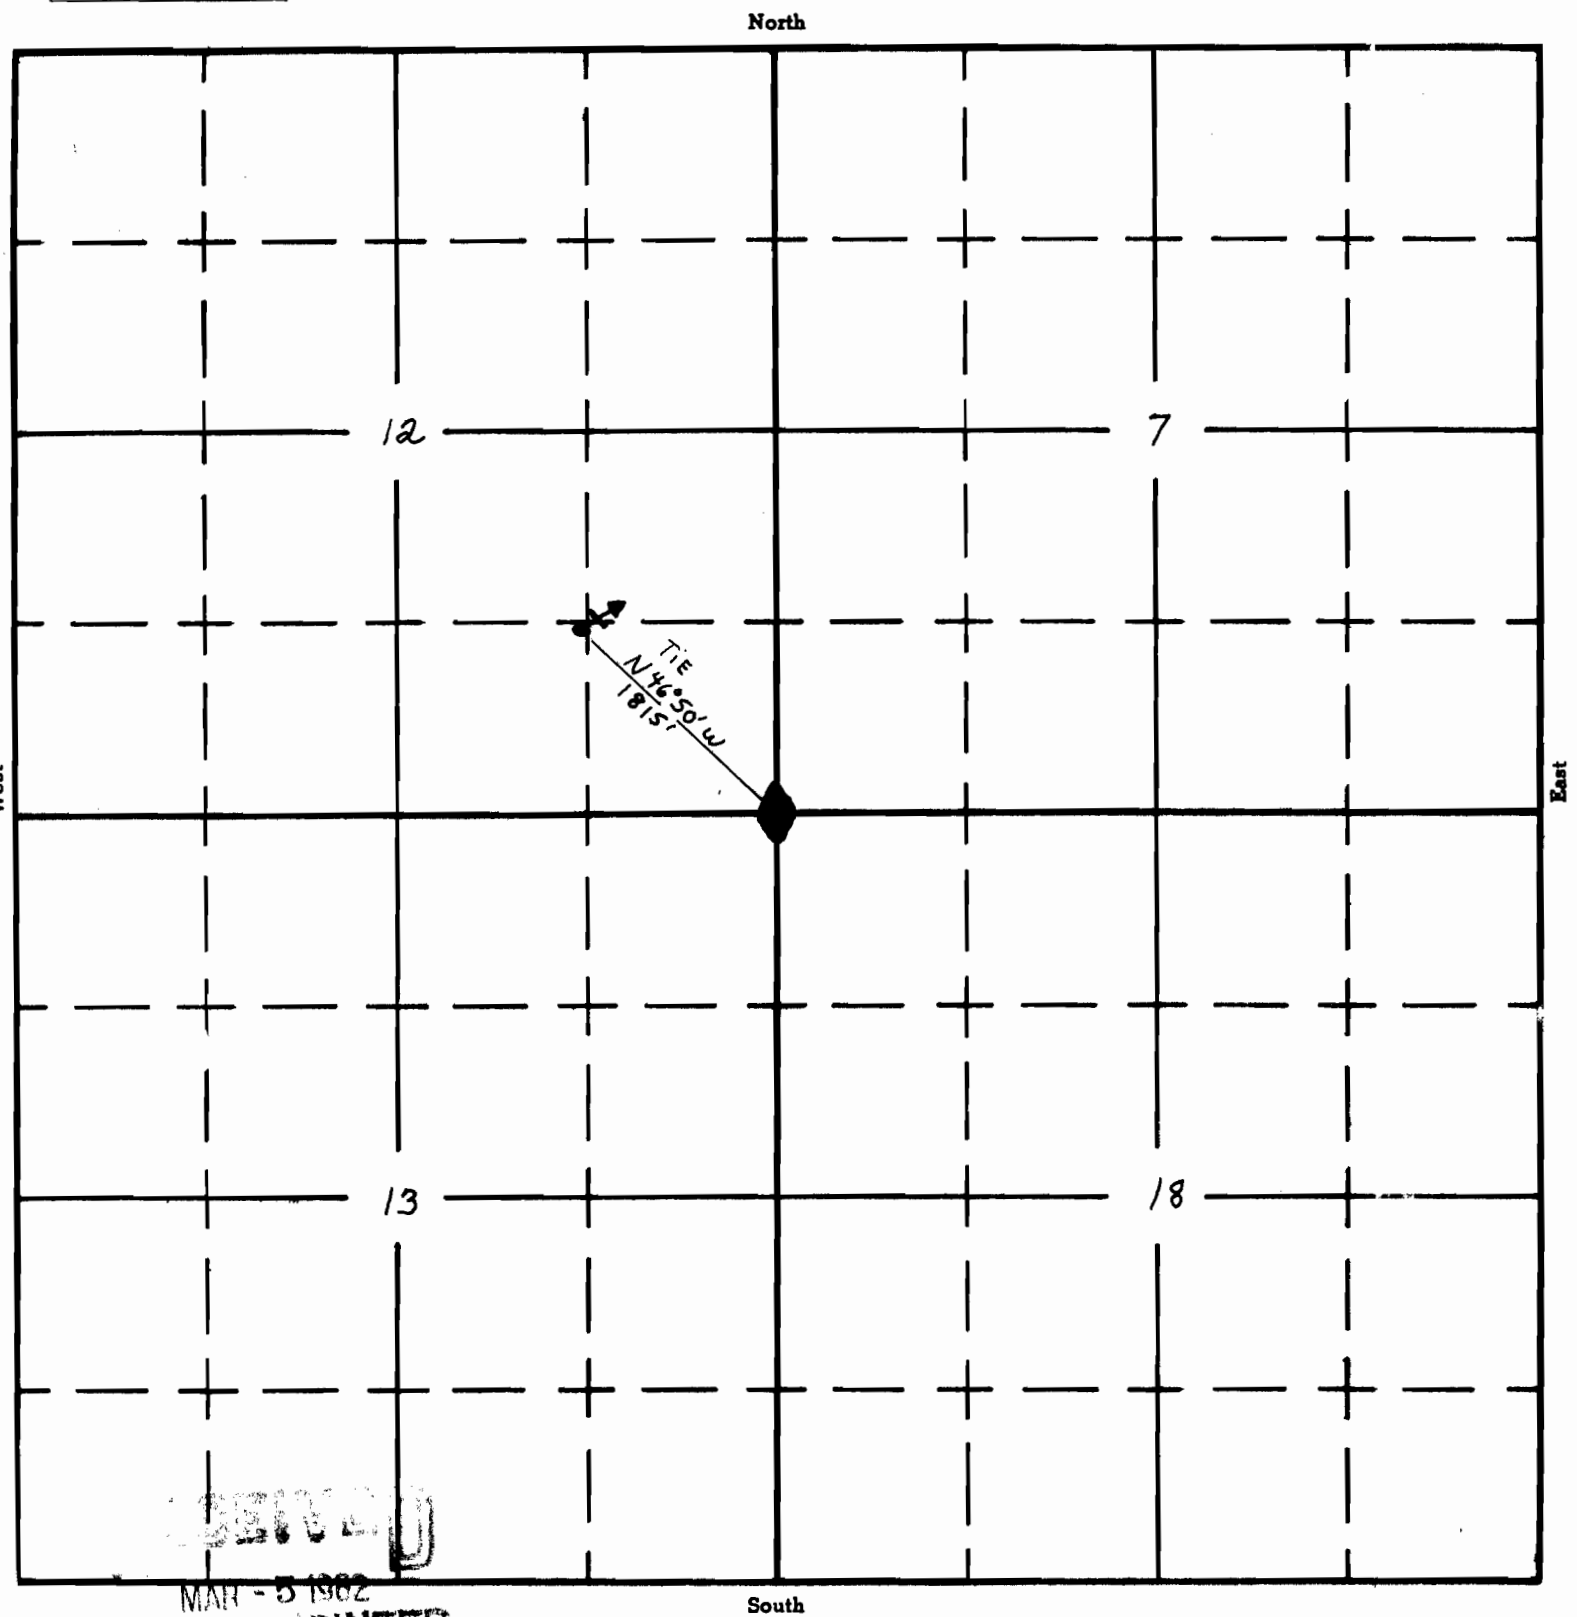

MAH - 5 1962
ENGINEER

APPLICATION No. 35389
PERMIT No. 28259