

UNITED STATES  
DEPARTMENT OF THE INTERIOR  
BUREAU OF LAND MANAGEMENT

SECTION


SW 1/4 NW 1/4

# Oregon State Water Filings

Sec 25

TOWNSHIP 18S, RANGE 35E, W. M.

North

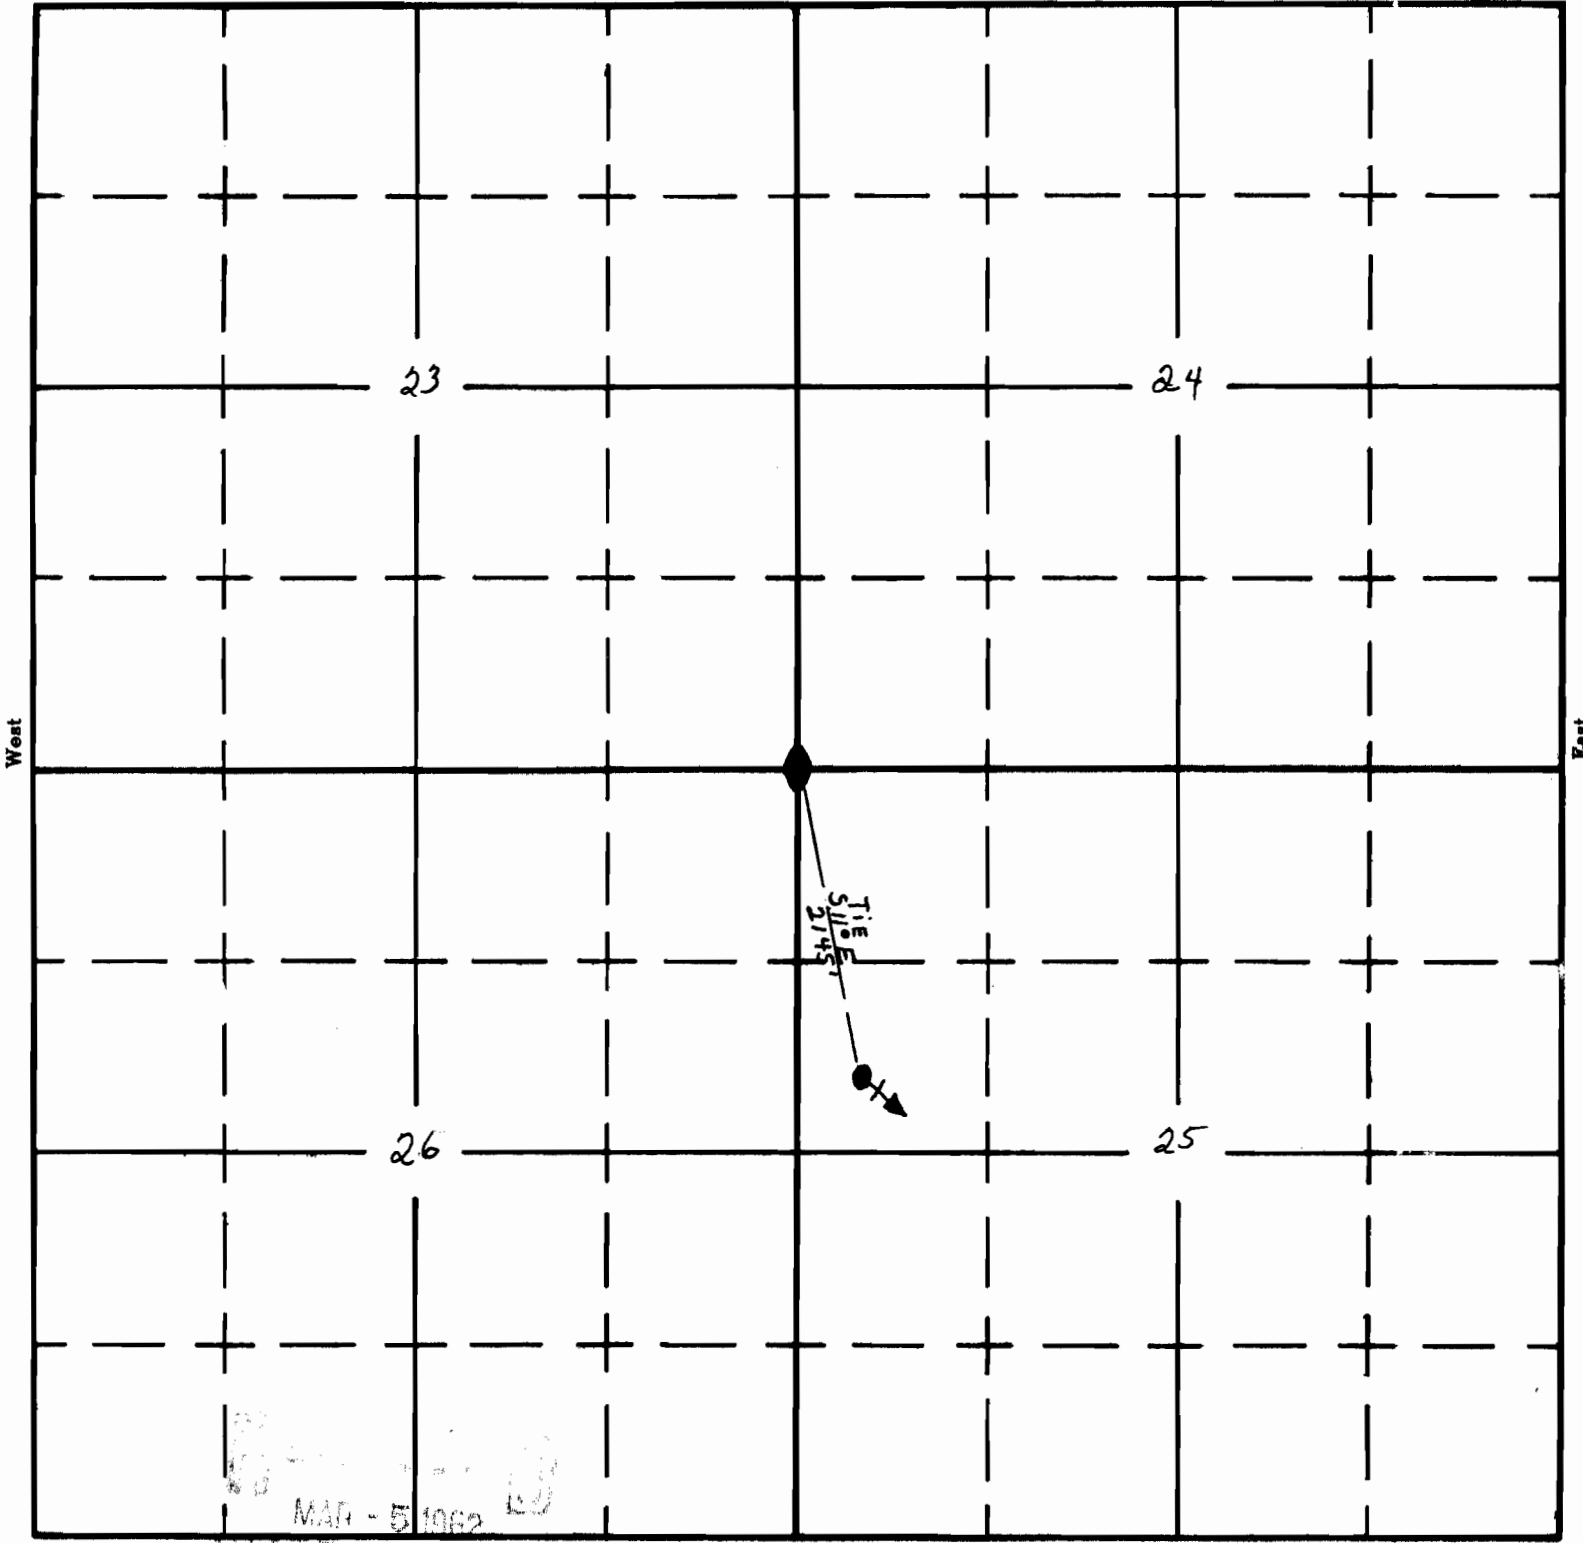

West

East

South

MAR - 5 1962  
SUPERVISOR

APPLICATION No. 35392

PERMIT No. 28260