

UNITED STATES
DEPARTMENT OF THE INTERIOR
BUREAU OF LAND MANAGEMENT

SECTION


NE $\frac{1}{4}$ SE $\frac{1}{4}$

Oregon State Water Filings

Sec 4

TOWNSHIP 21S, RANGE 30E, W. M.

North

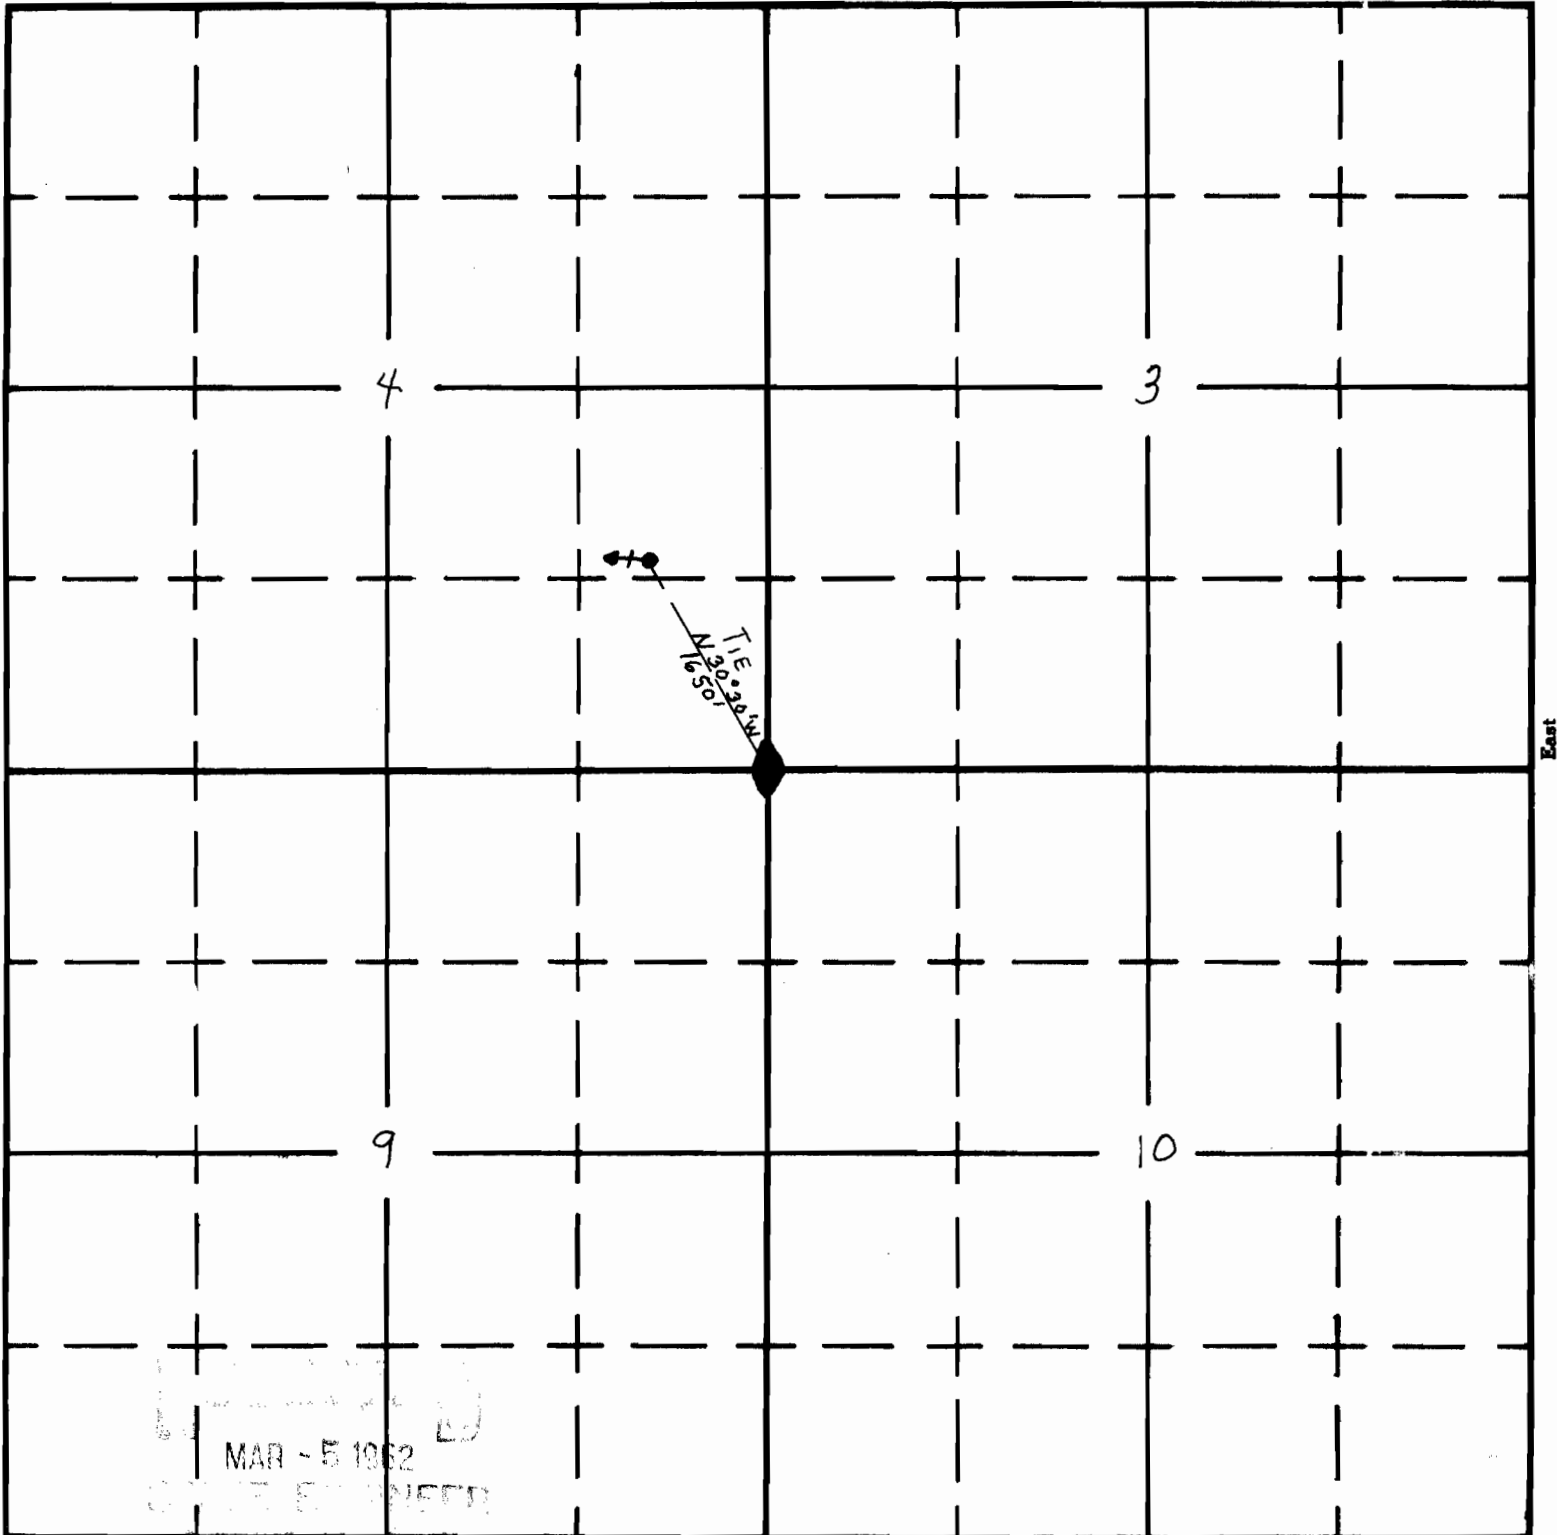

MAR - 5 1962

OFFICE OF THE ENGINEER

South

APPLICATION No. 35394

PERMIT No. 28262