

Form A1-187
March 1961

UNITED STATES
DEPARTMENT OF THE INTERIOR
BUREAU OF LAND MANAGEMENT


SECTION

Oregon State Water Filings

NE $\frac{1}{4}$ SE $\frac{1}{4}$

TOWNSHIP 37S, RANGE 32 $\frac{1}{2}$ E, W. M.

Sec. 7

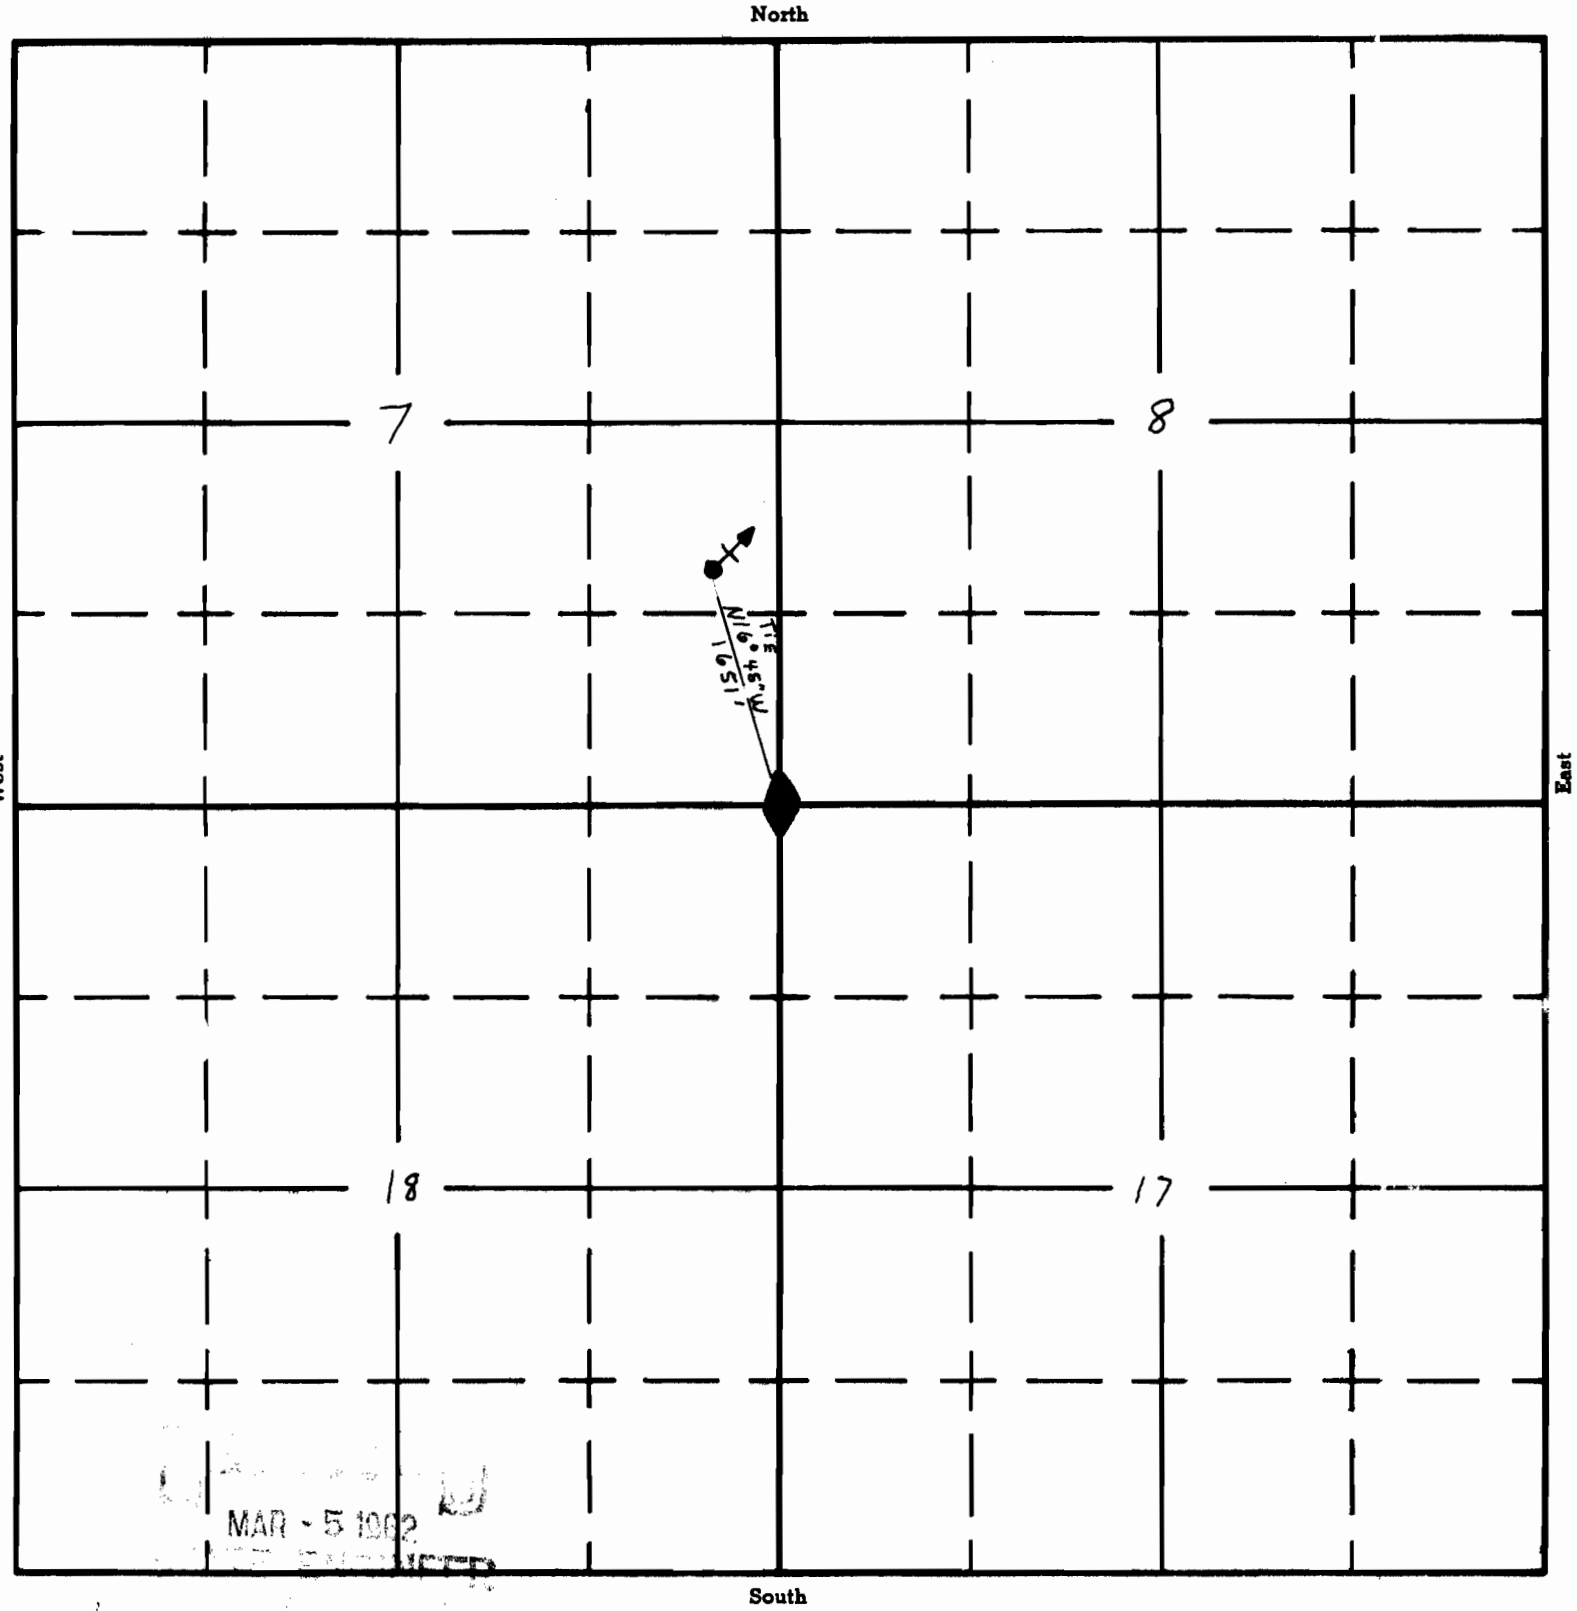

APPLICATION No. 35395
PERMIT No. 28263