

Form A1-187
March 1961

UNITED STATES
DEPARTMENT OF THE INTERIOR
BUREAU OF LAND MANAGEMENT

SECTION


Oregon State Water Filings

SE $\frac{1}{4}$ Sec 7

TOWNSHIP 19S, RANGE 36E, W. M.

Sec 7

North

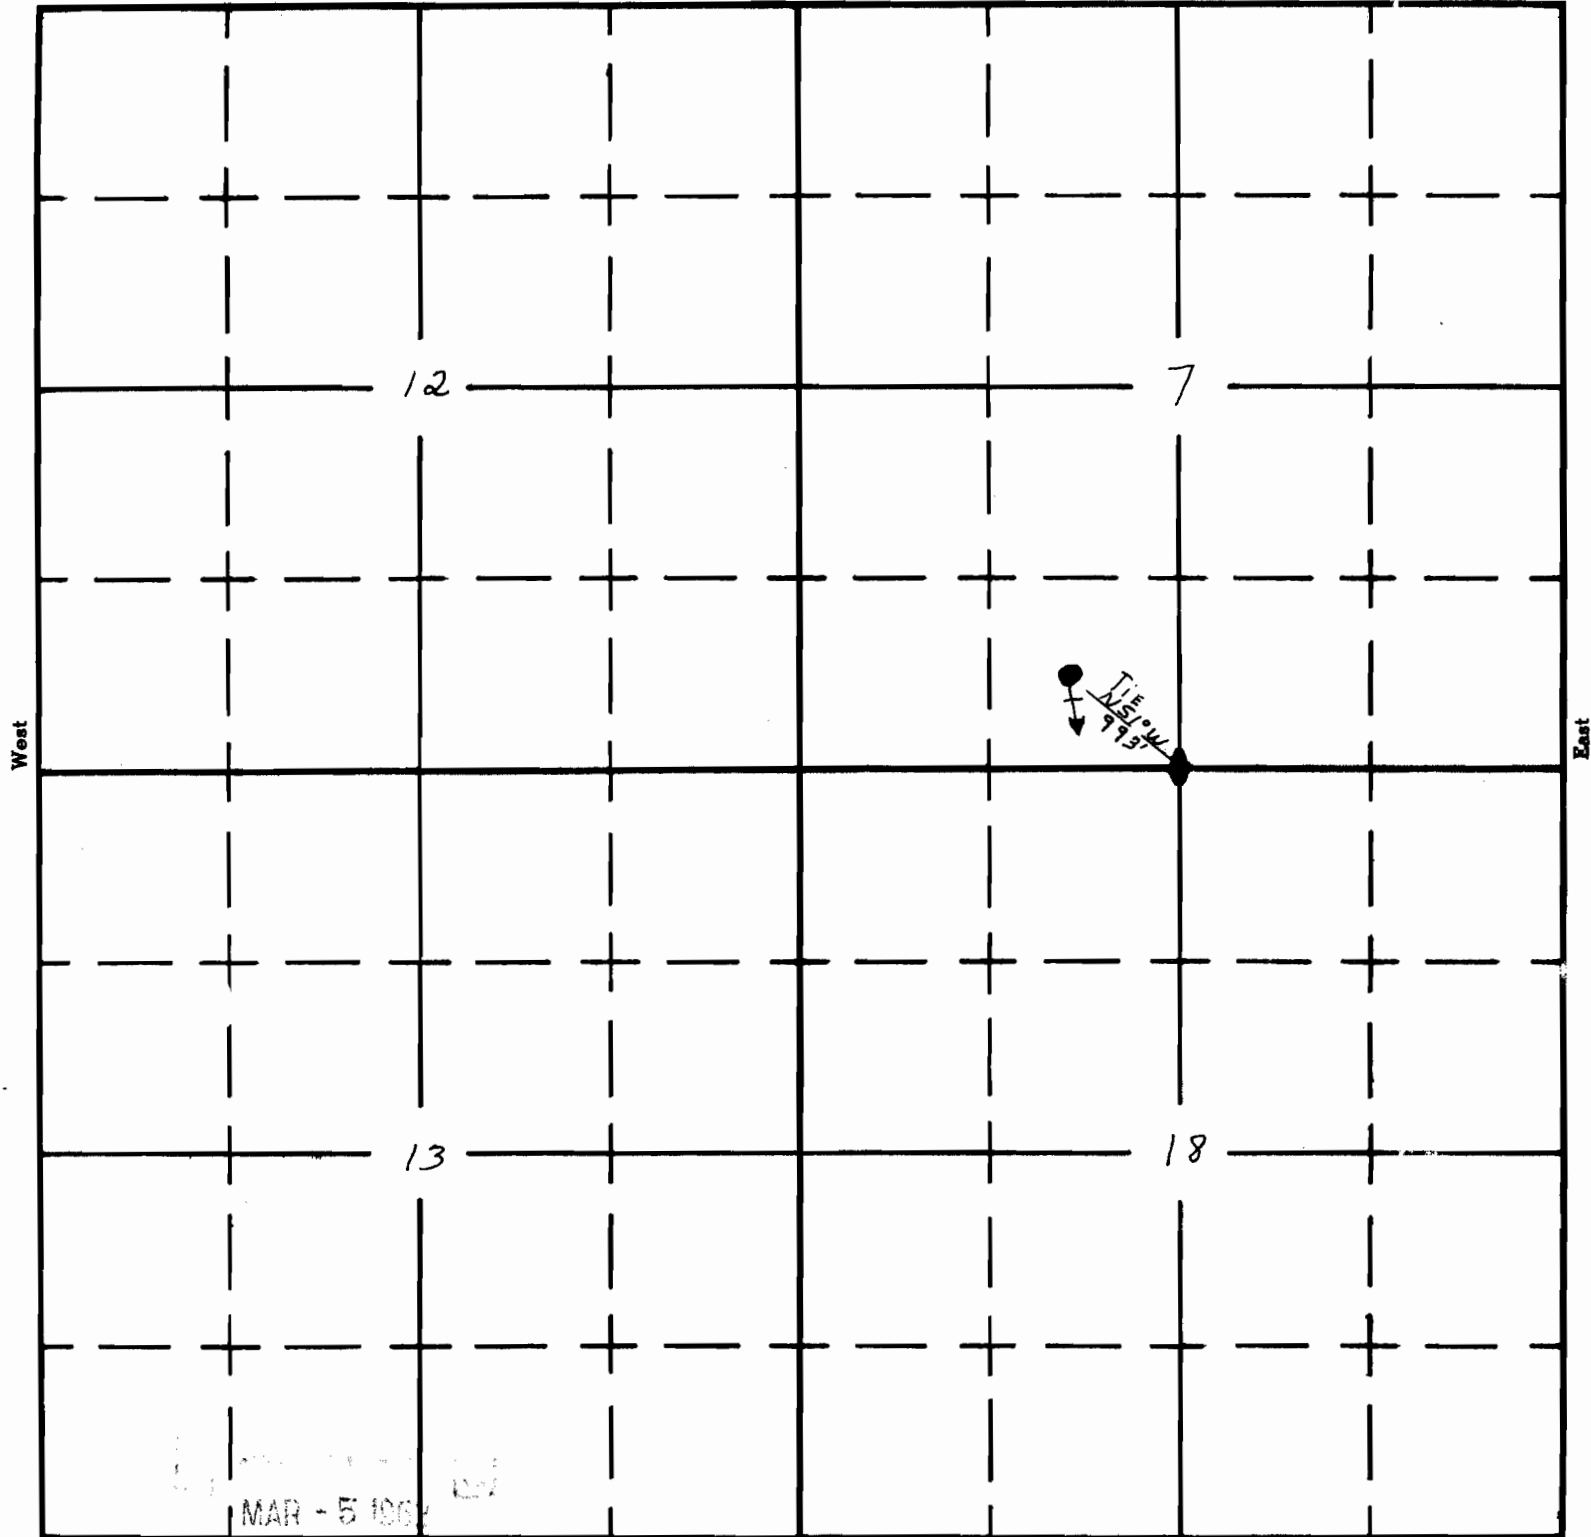

MAR - 5 1961

South

APPLICATION No. 35397
PERMIT No. 28265