

UNITED STATES
DEPARTMENT OF THE INTERIOR
BUREAU OF LAND MANAGEMENT

SECTION


Oregon State Water Filings

NW $\frac{1}{4}$ SW $\frac{1}{4}$

TOWNSHIP 23S, RANGE 28E, W. M.

Sec. 11

North

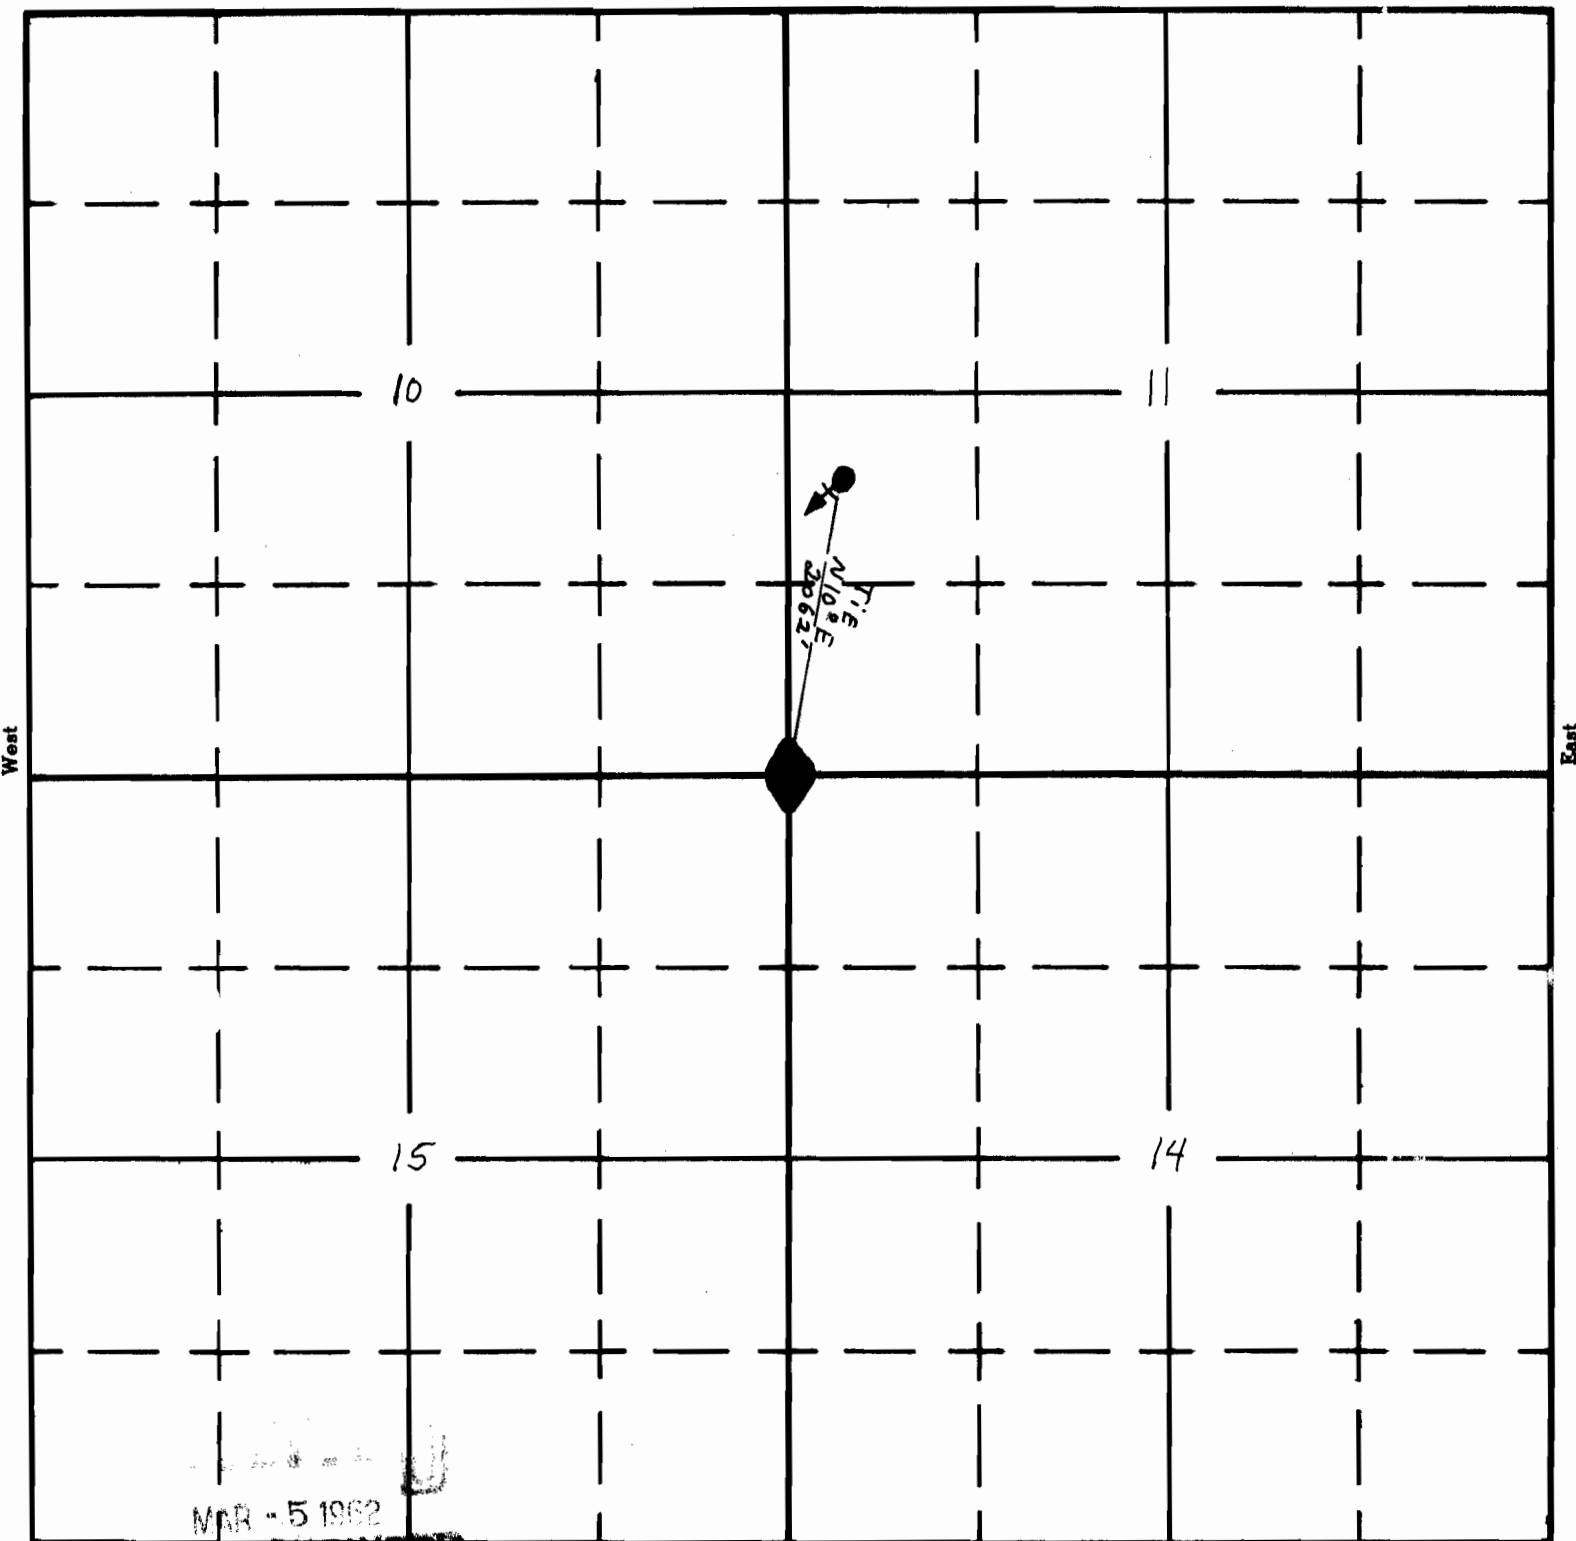

MAR - 5 1962

South

APPLICATION No. 35399

PERMIT No. 28267