

UNITED STATES  
DEPARTMENT OF THE INTERIOR  
BUREAU OF LAND MANAGEMENT

SECTION


SW 1/4 SE 1/4

Oregon State Water Filings

Sec 4

TOWNSHIP 21S, RANGE 30E, W. M.

North

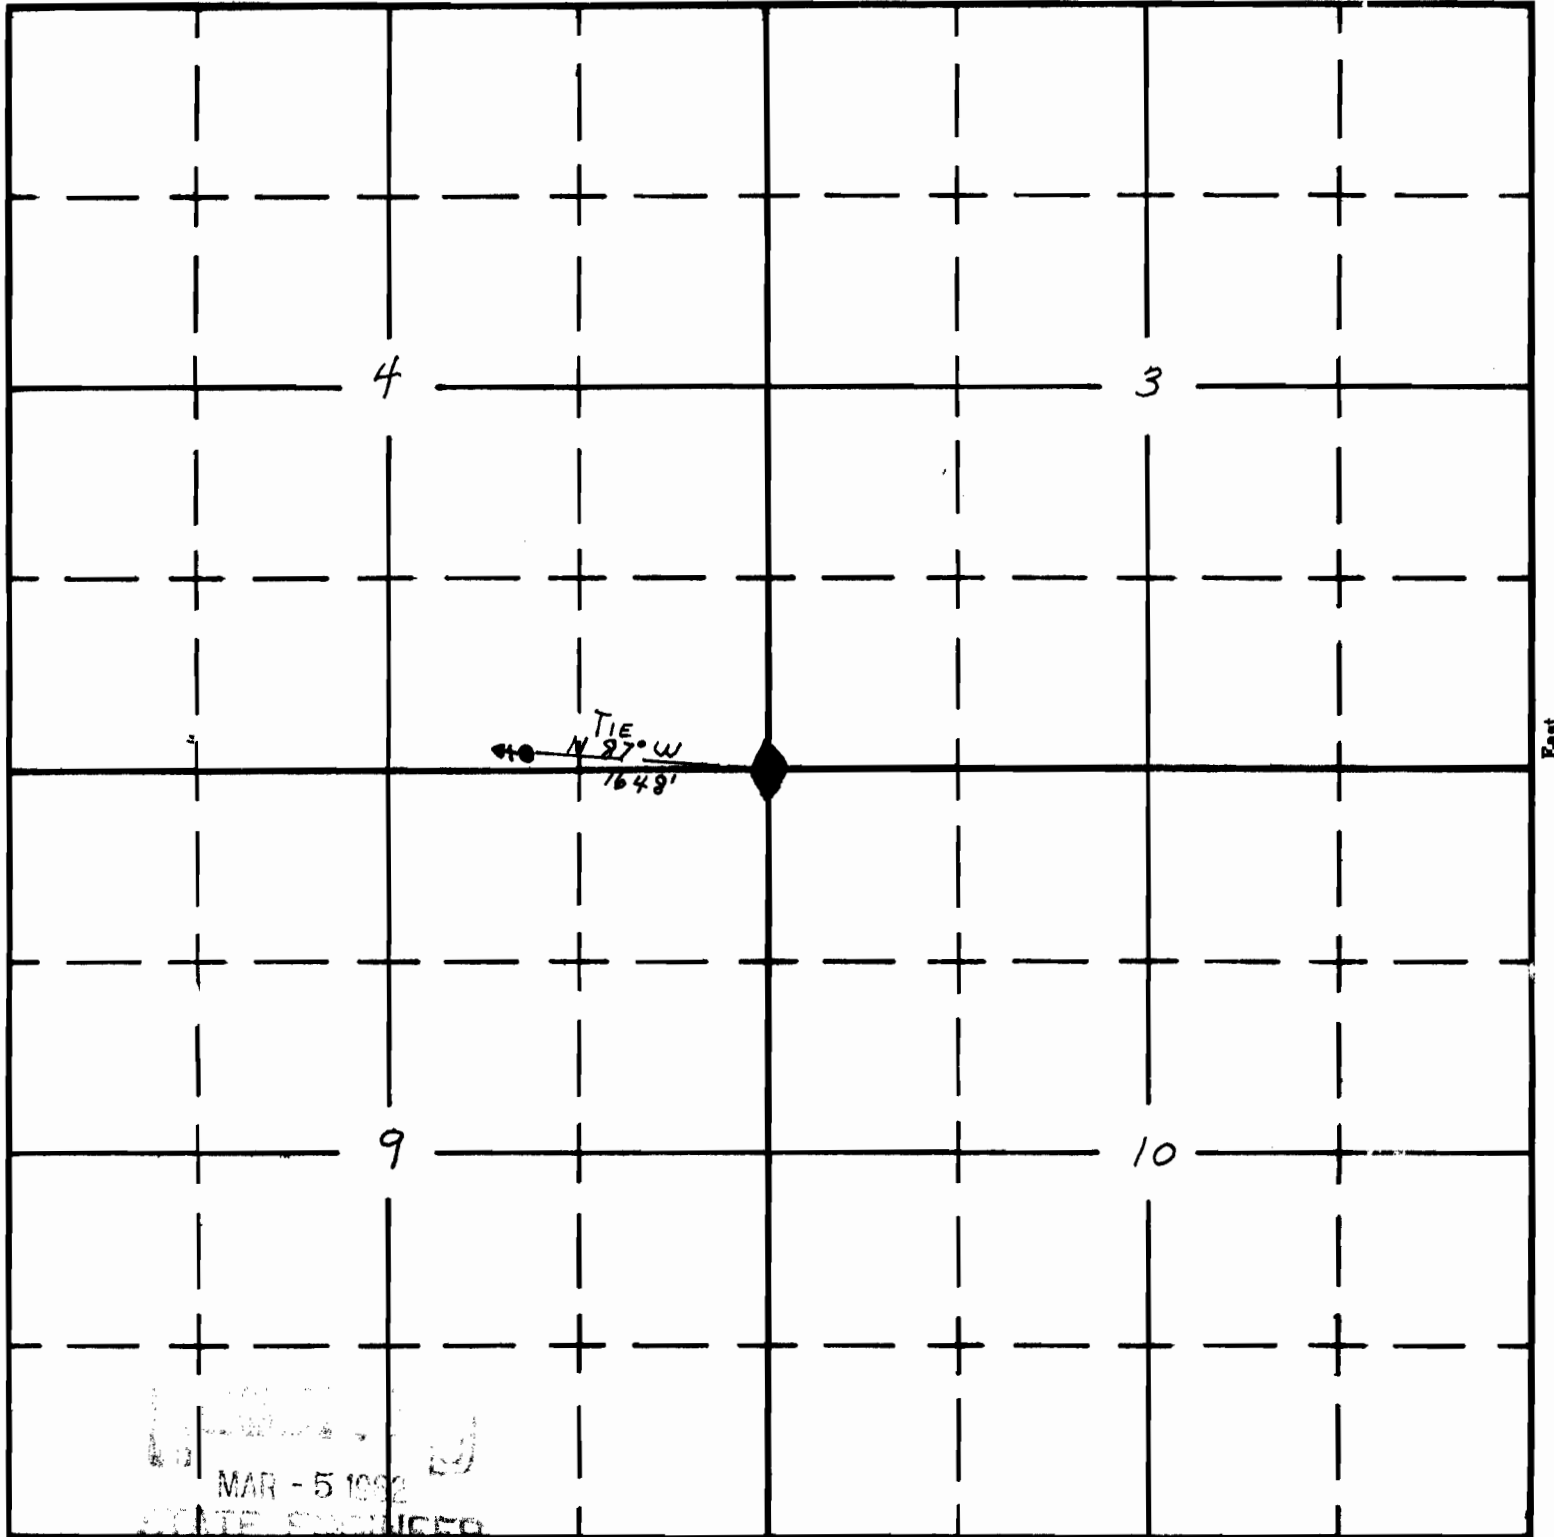

South

MAR - 5 1962

STATE ENGINEER

54101 - 1/4

APPLICATION No. 35402  
PERMIT No. 28916