


UNITED STATES
DEPARTMENT OF THE INTERIOR
BUREAU OF LAND MANAGEMENT

SECTION _____

Oregon State Water Filings

TOWNSHIP 39, RANGE 33 E, W. M.

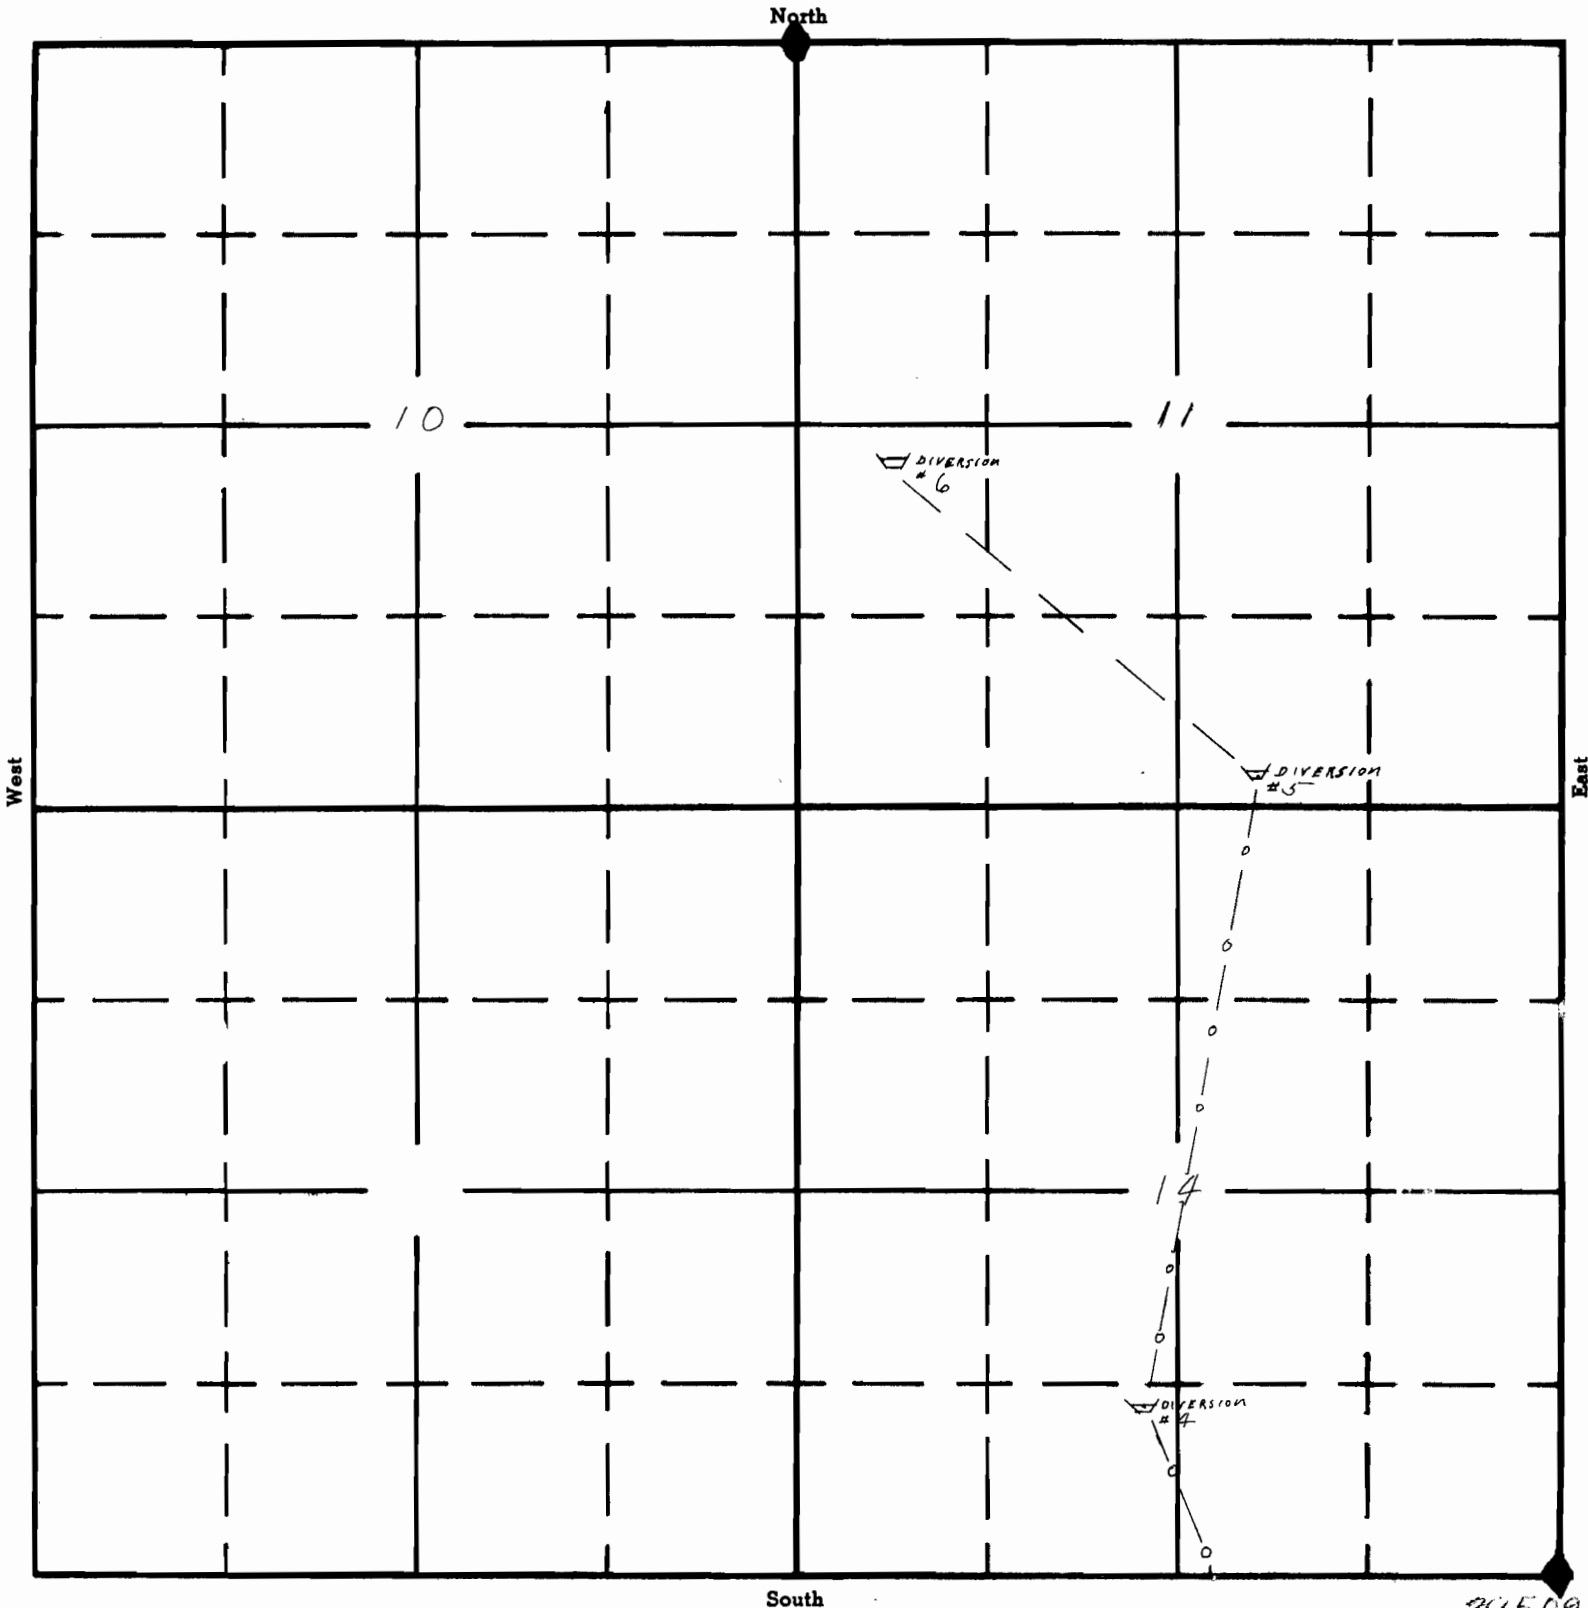


34509
APPLICATION No. 34796
29766
PERMIT No. 27332

UNITED STATES
DEPARTMENT OF THE INTERIOR
BUREAU OF LAND MANAGEMENT

SECTION _____

Oregon State Water Filings

TOWNSHIP 39, RANGE 33E, W. M.

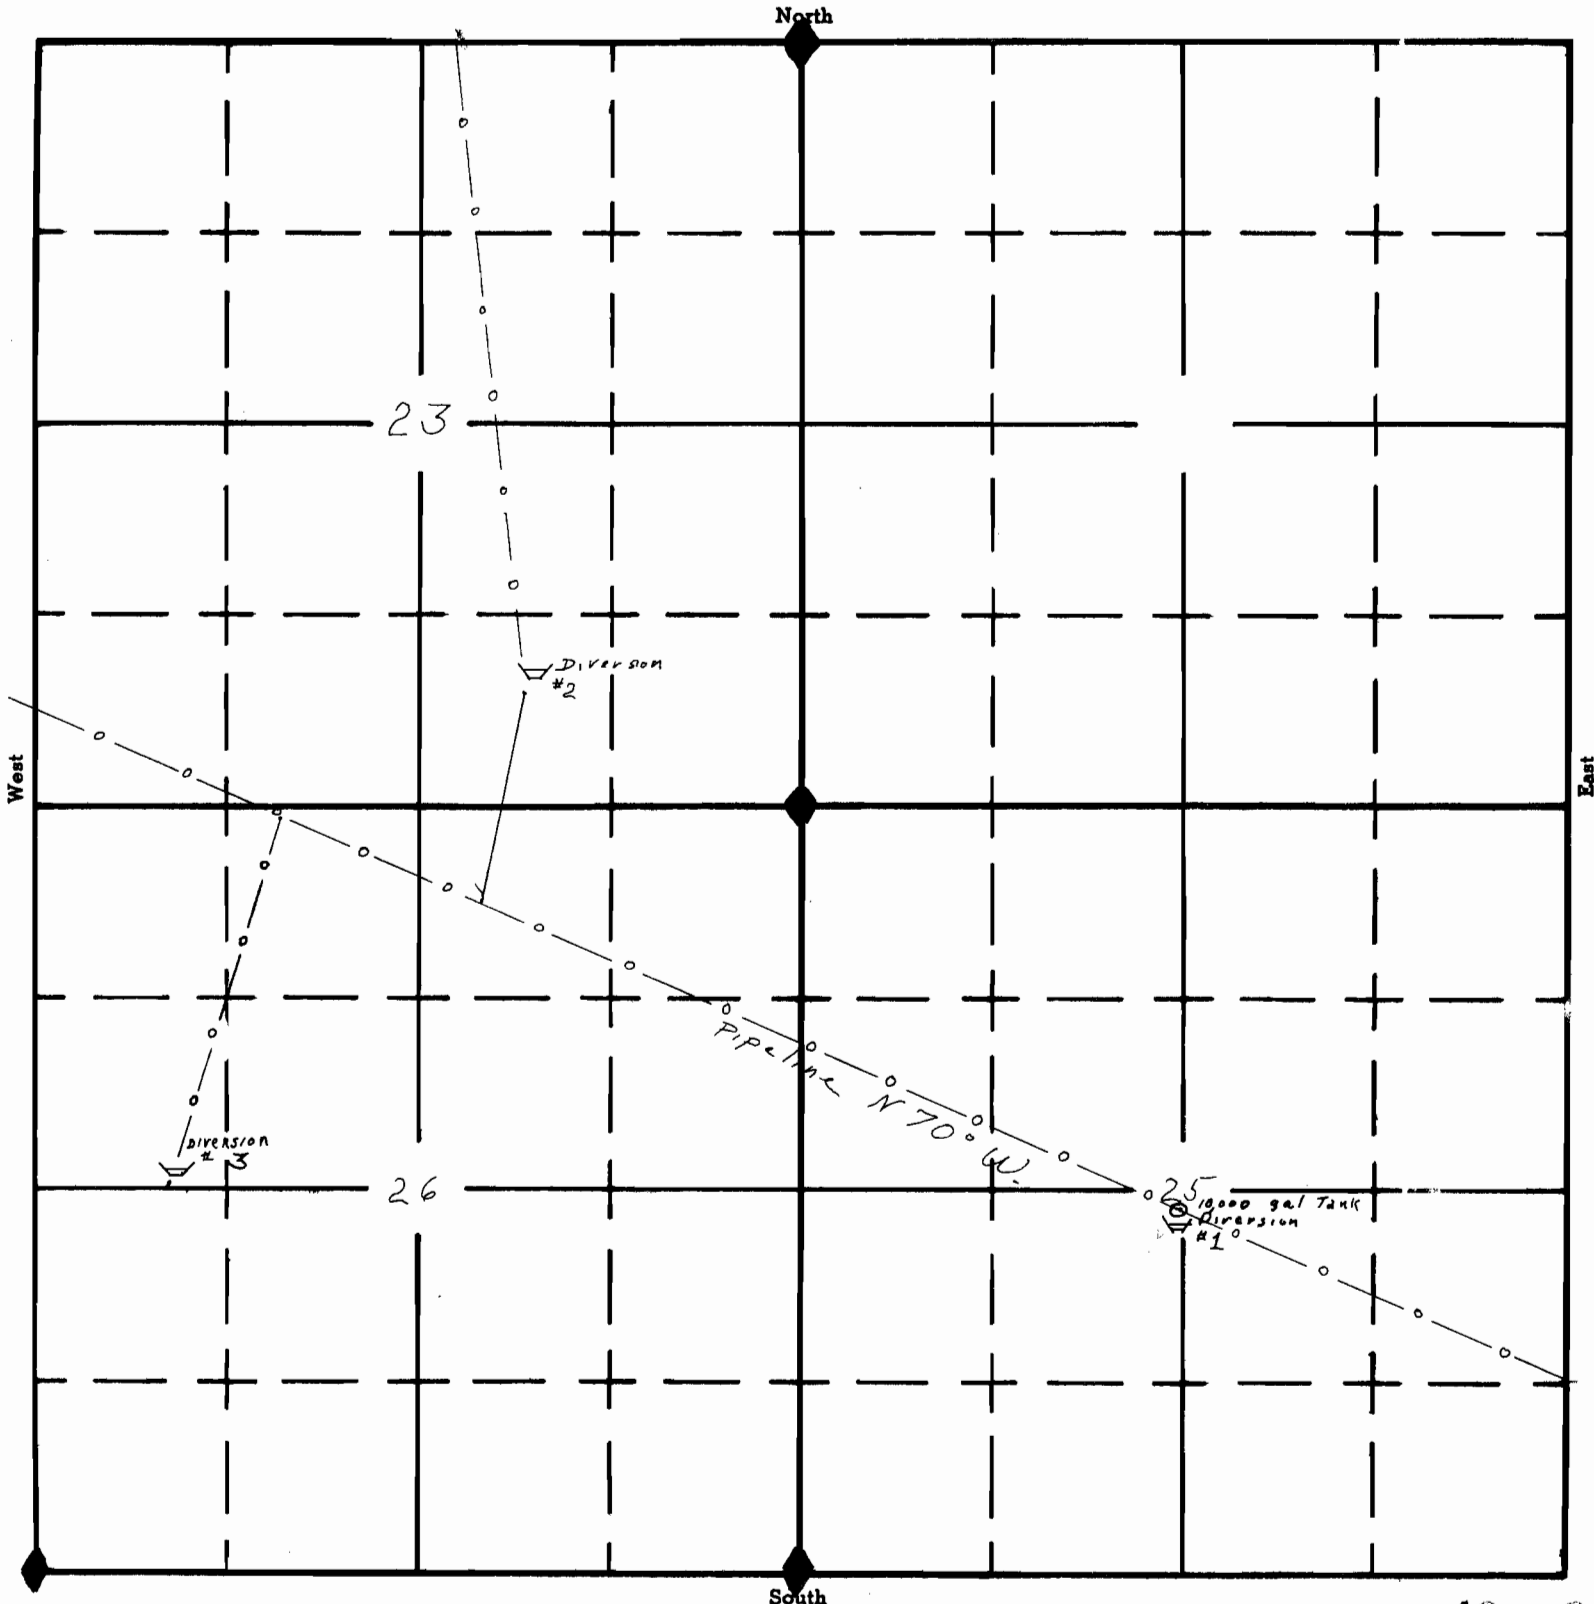

39509
APPLICATION No. 34796
29766
PERMIT No. 27332

Form A1-187
March 1961

UNITED STATES
DEPARTMENT OF THE INTERIOR
BUREAU OF LAND MANAGEMENT

SECTION

Oregon State Water Filings

TOWNSHIP 39S, RANGE 33E, W. M.

North

West

East

South

28

DIVERSION # 10


39509
APPLICATION No. 34796
29766
PERMIT No. 27332

UNITED STATES
DEPARTMENT OF THE INTERIOR
BUREAU OF LAND MANAGEMENT

SECTION _____

Oregon State Water Filings

TOWNSHIP 39_s, RANGE 34_e, W. M.

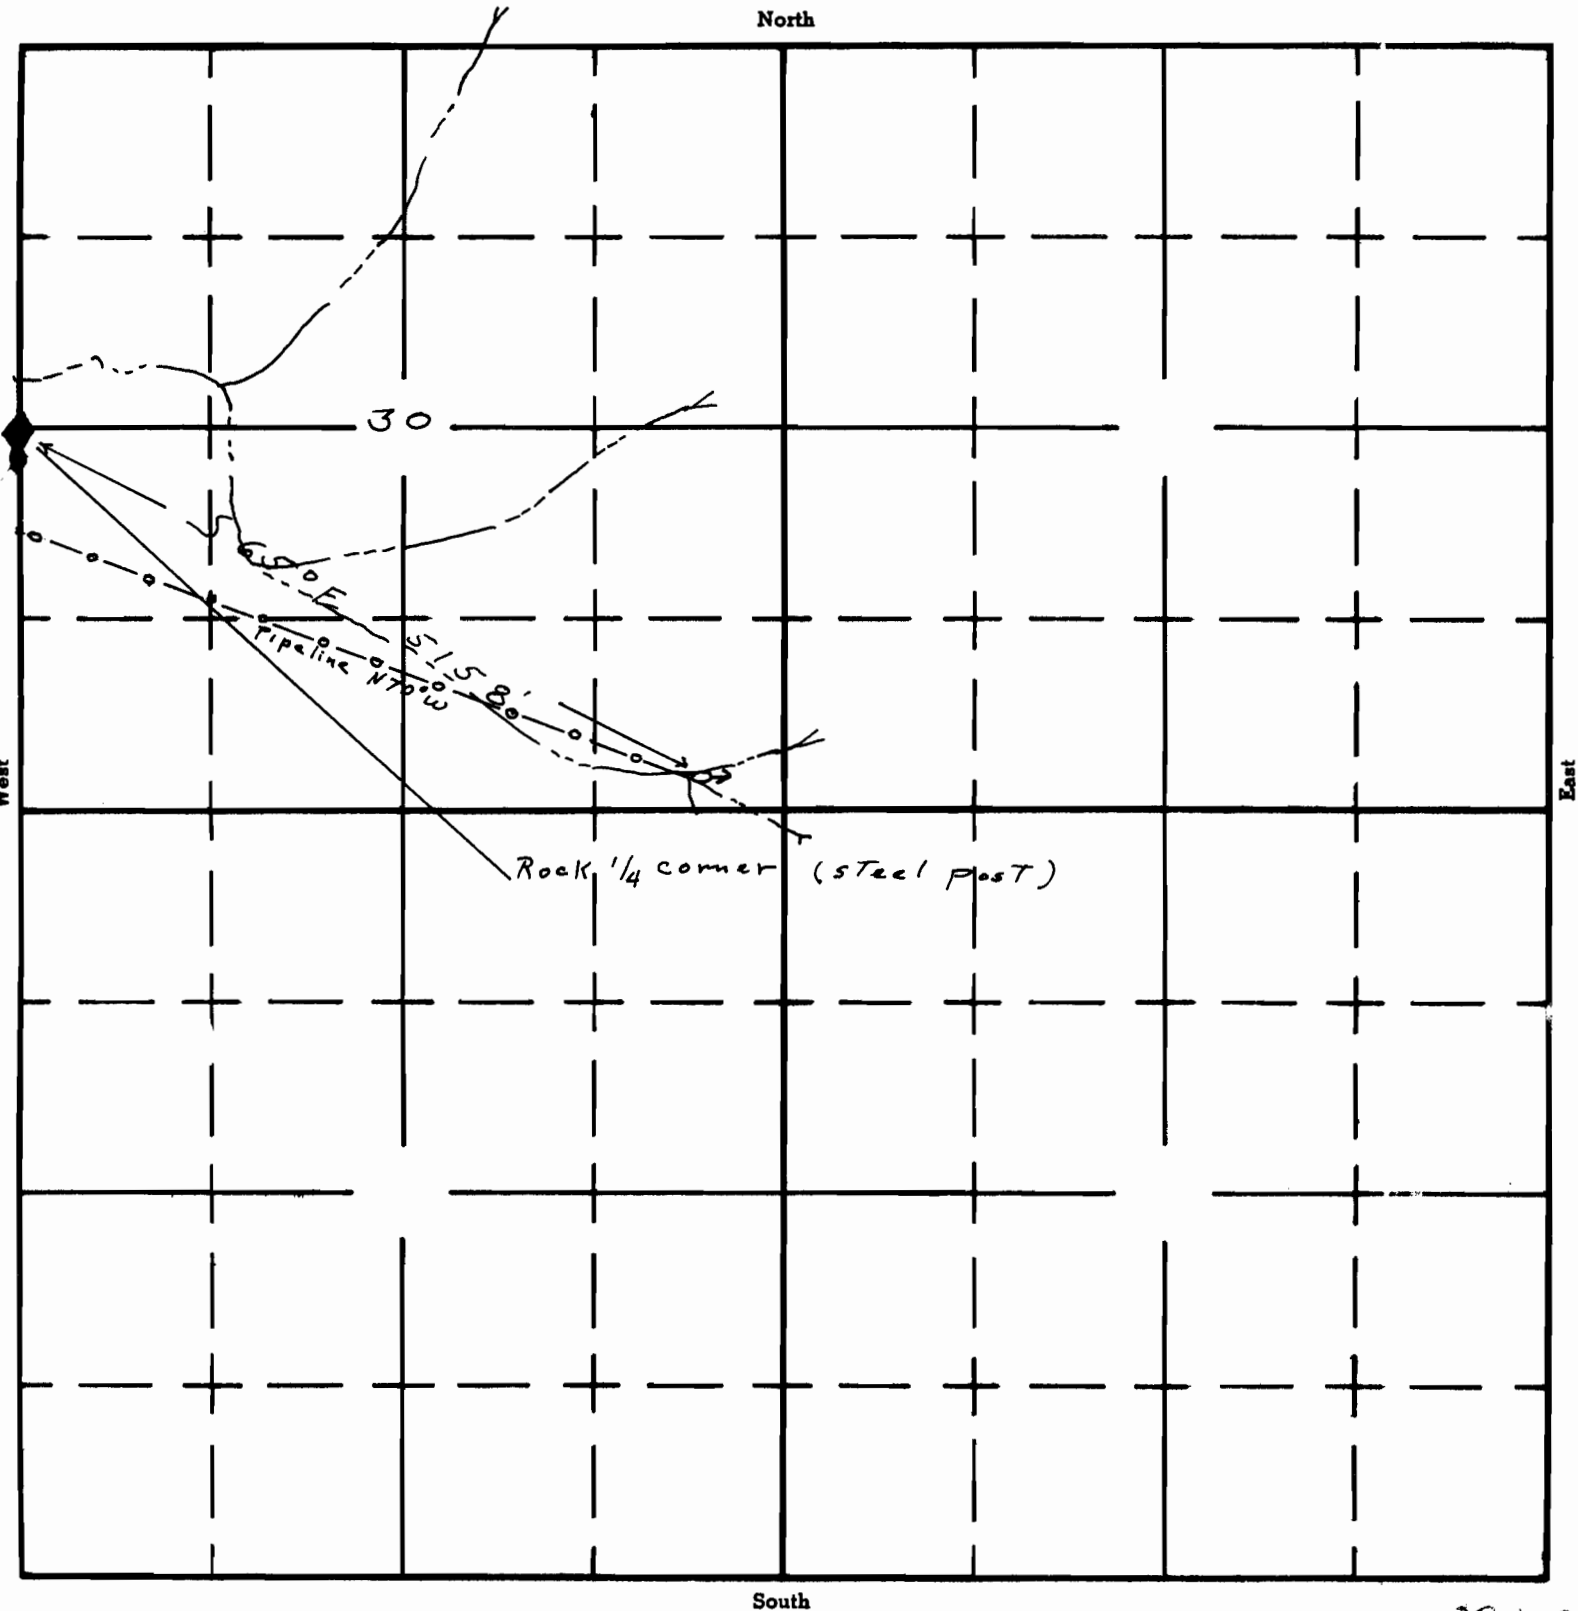


APPLICATION No. 39509
34796
PERMIT No. 29766
27332

UNITED STATES
DEPARTMENT OF THE INTERIOR
BUREAU OF LAND MANAGEMENT

SECTION _____

Oregon State Water Filings

TOWNSHIP 39_S, RANGE 33_E, W. M.

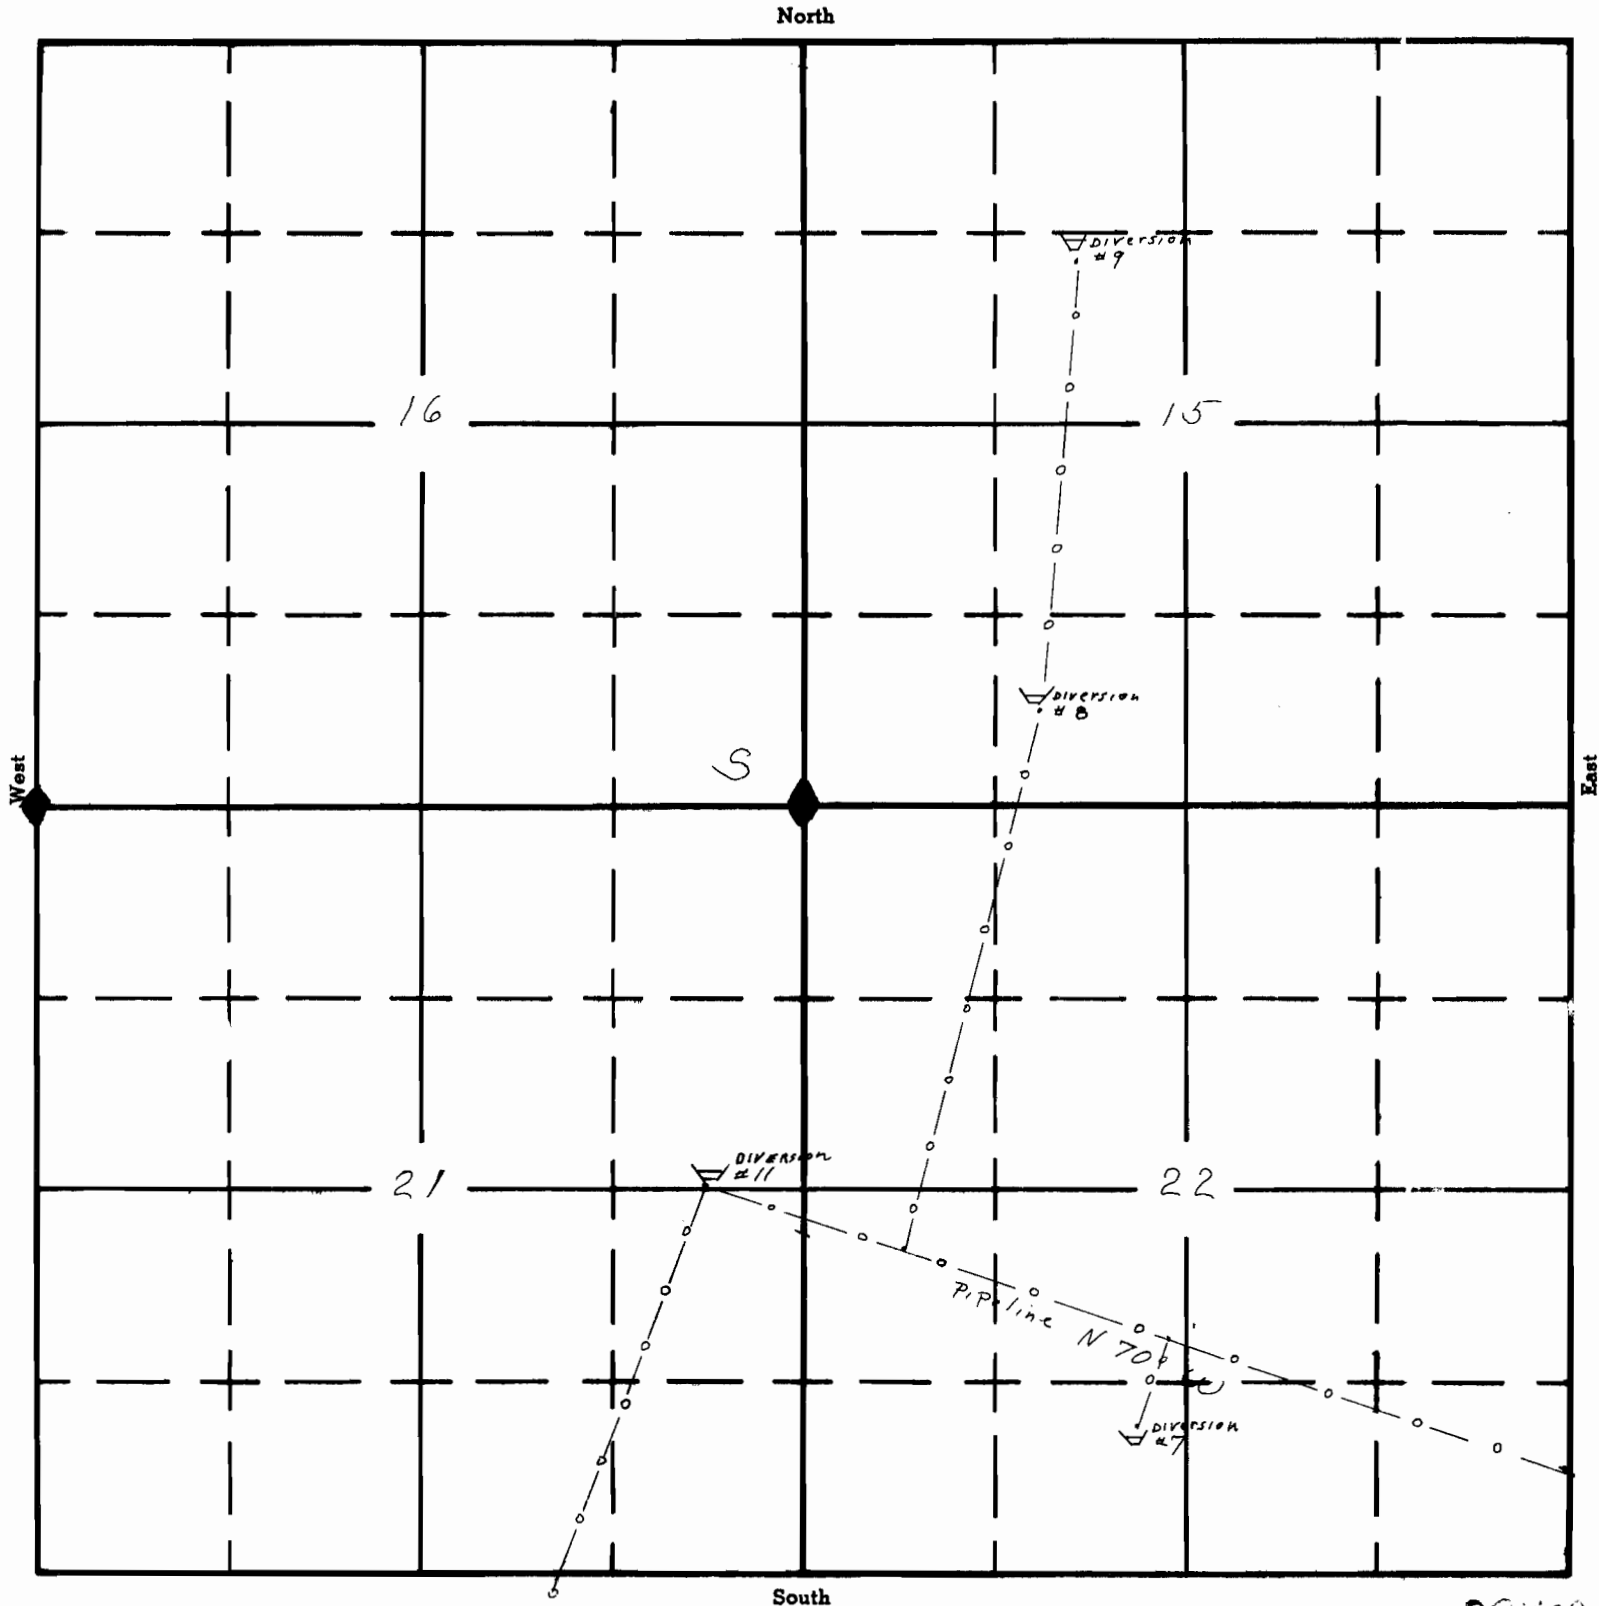

39509
APPLICATION No. 34796
29766
PERMIT No. 27382