

SECTION

NE 1/4, SE 1/4

PT. OF DIVERSION -

2600 FT N +

1000 FT W OF

SE CORNER, SE. 22


Oregon State Water Filings

TOWNSHIP 19S, RANGE 32E, W. M.

4" = 1 mile  North

M.P. SPRING #1

15-4577

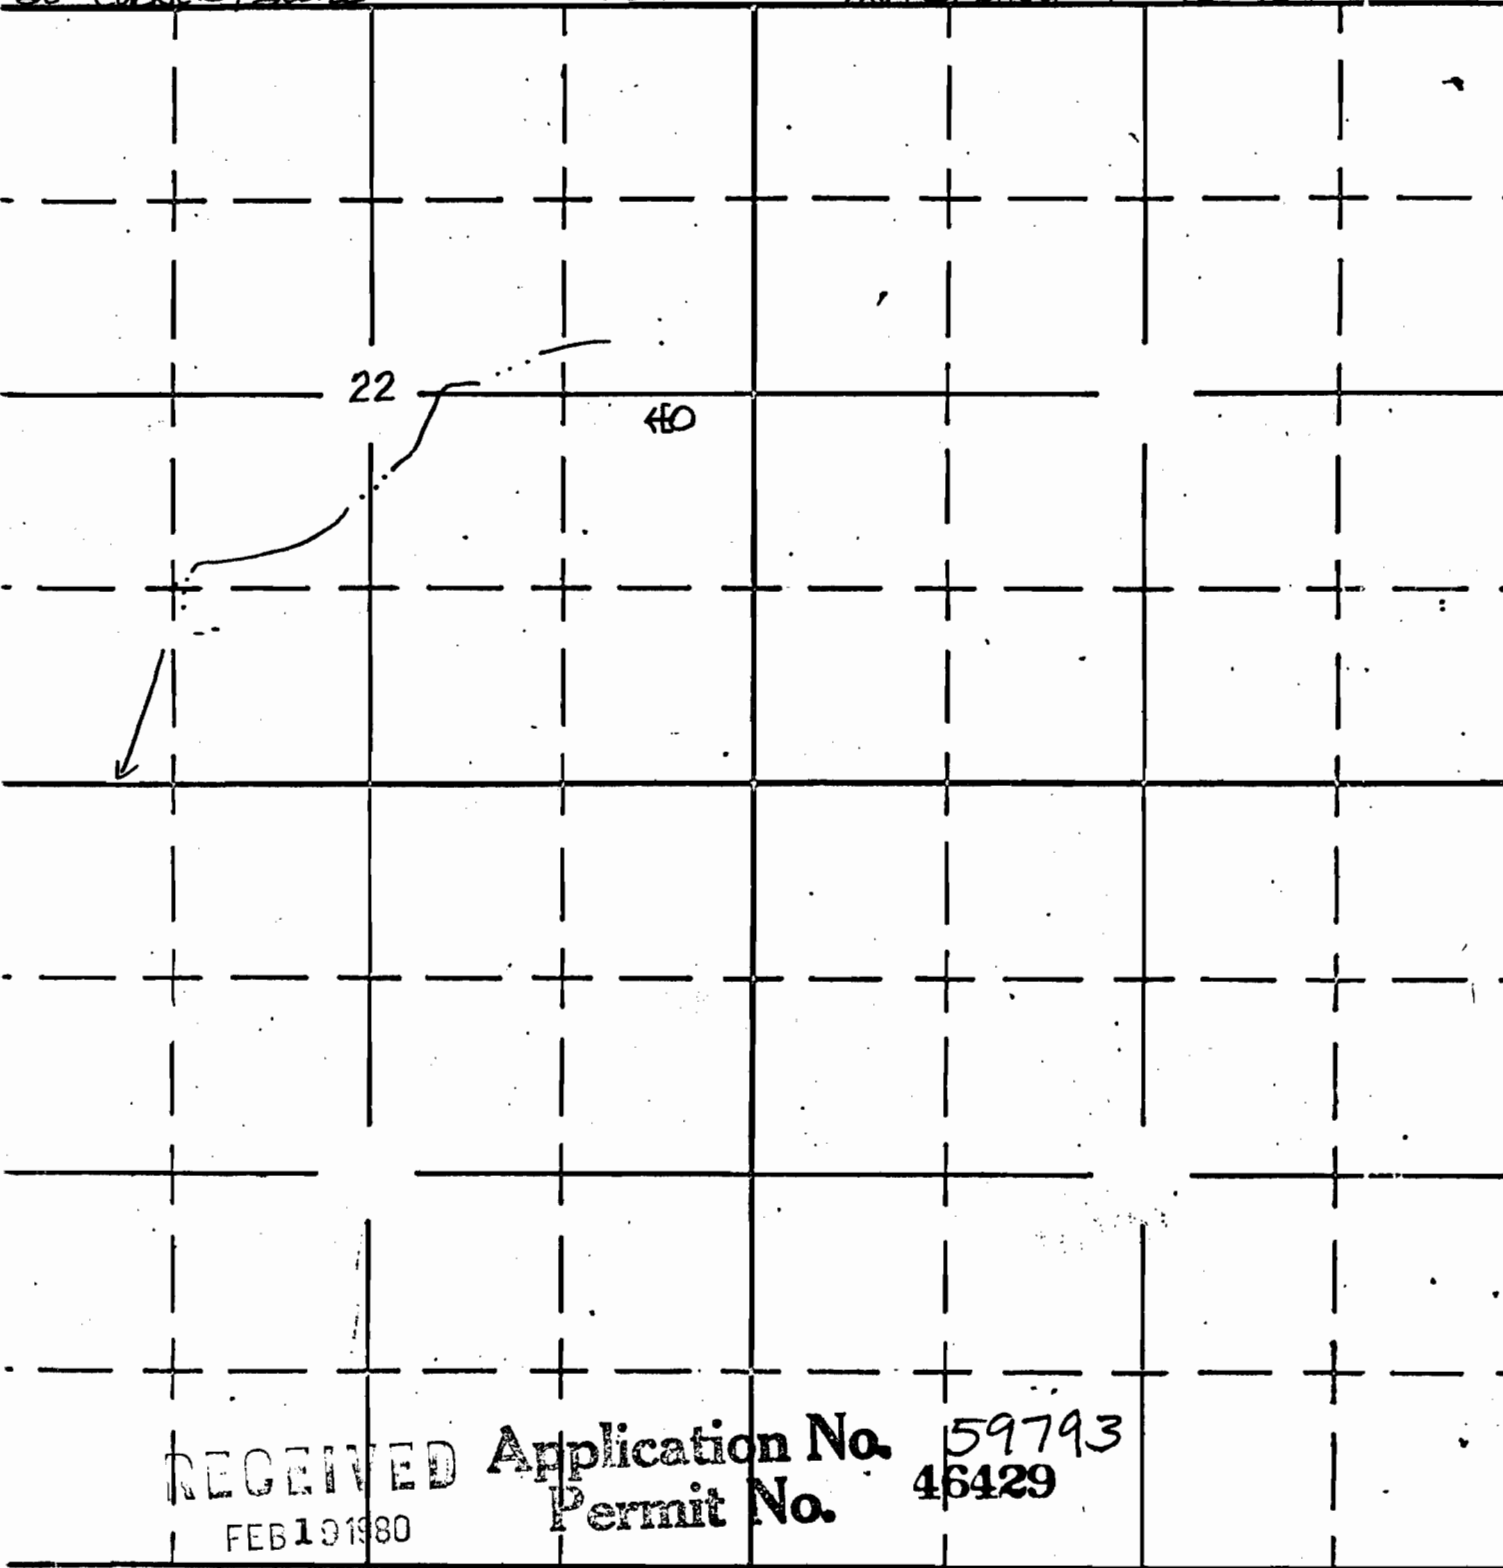

RECEIVED Application No. 59793
FEB 19 1980 Permit No. 46429

WATER RESOURCES DEPT
SALEM, OREGON

South

APPLICATION No.
PERMIT No.