


Township 2 N.

4/14/10

App. No. 9498
Point No. 6405

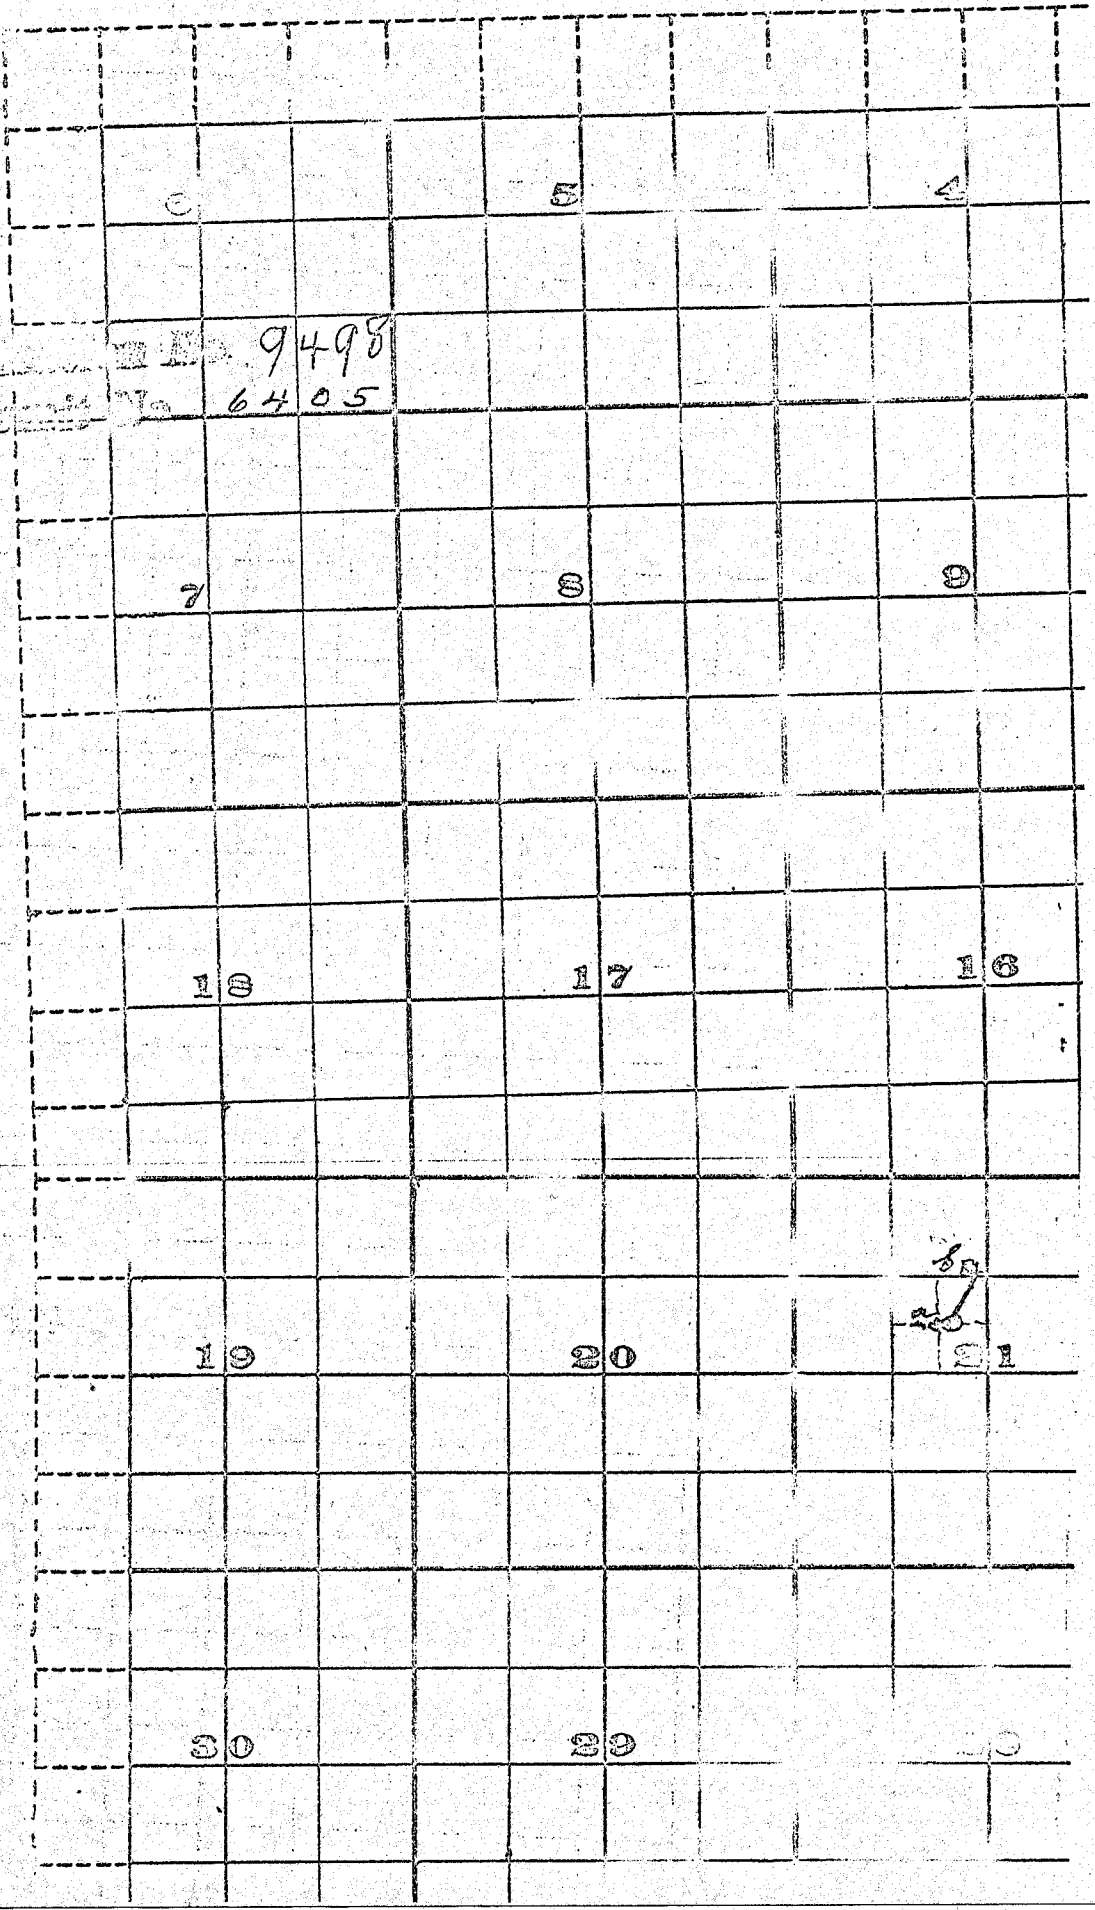

T 2 N
R 10 E

a. spring
b. dwelling

