


SECTION
SW SW

#-114-10mrock Spring

TOWNSHIP 19 S., RANGE 34 E., W. M.

North

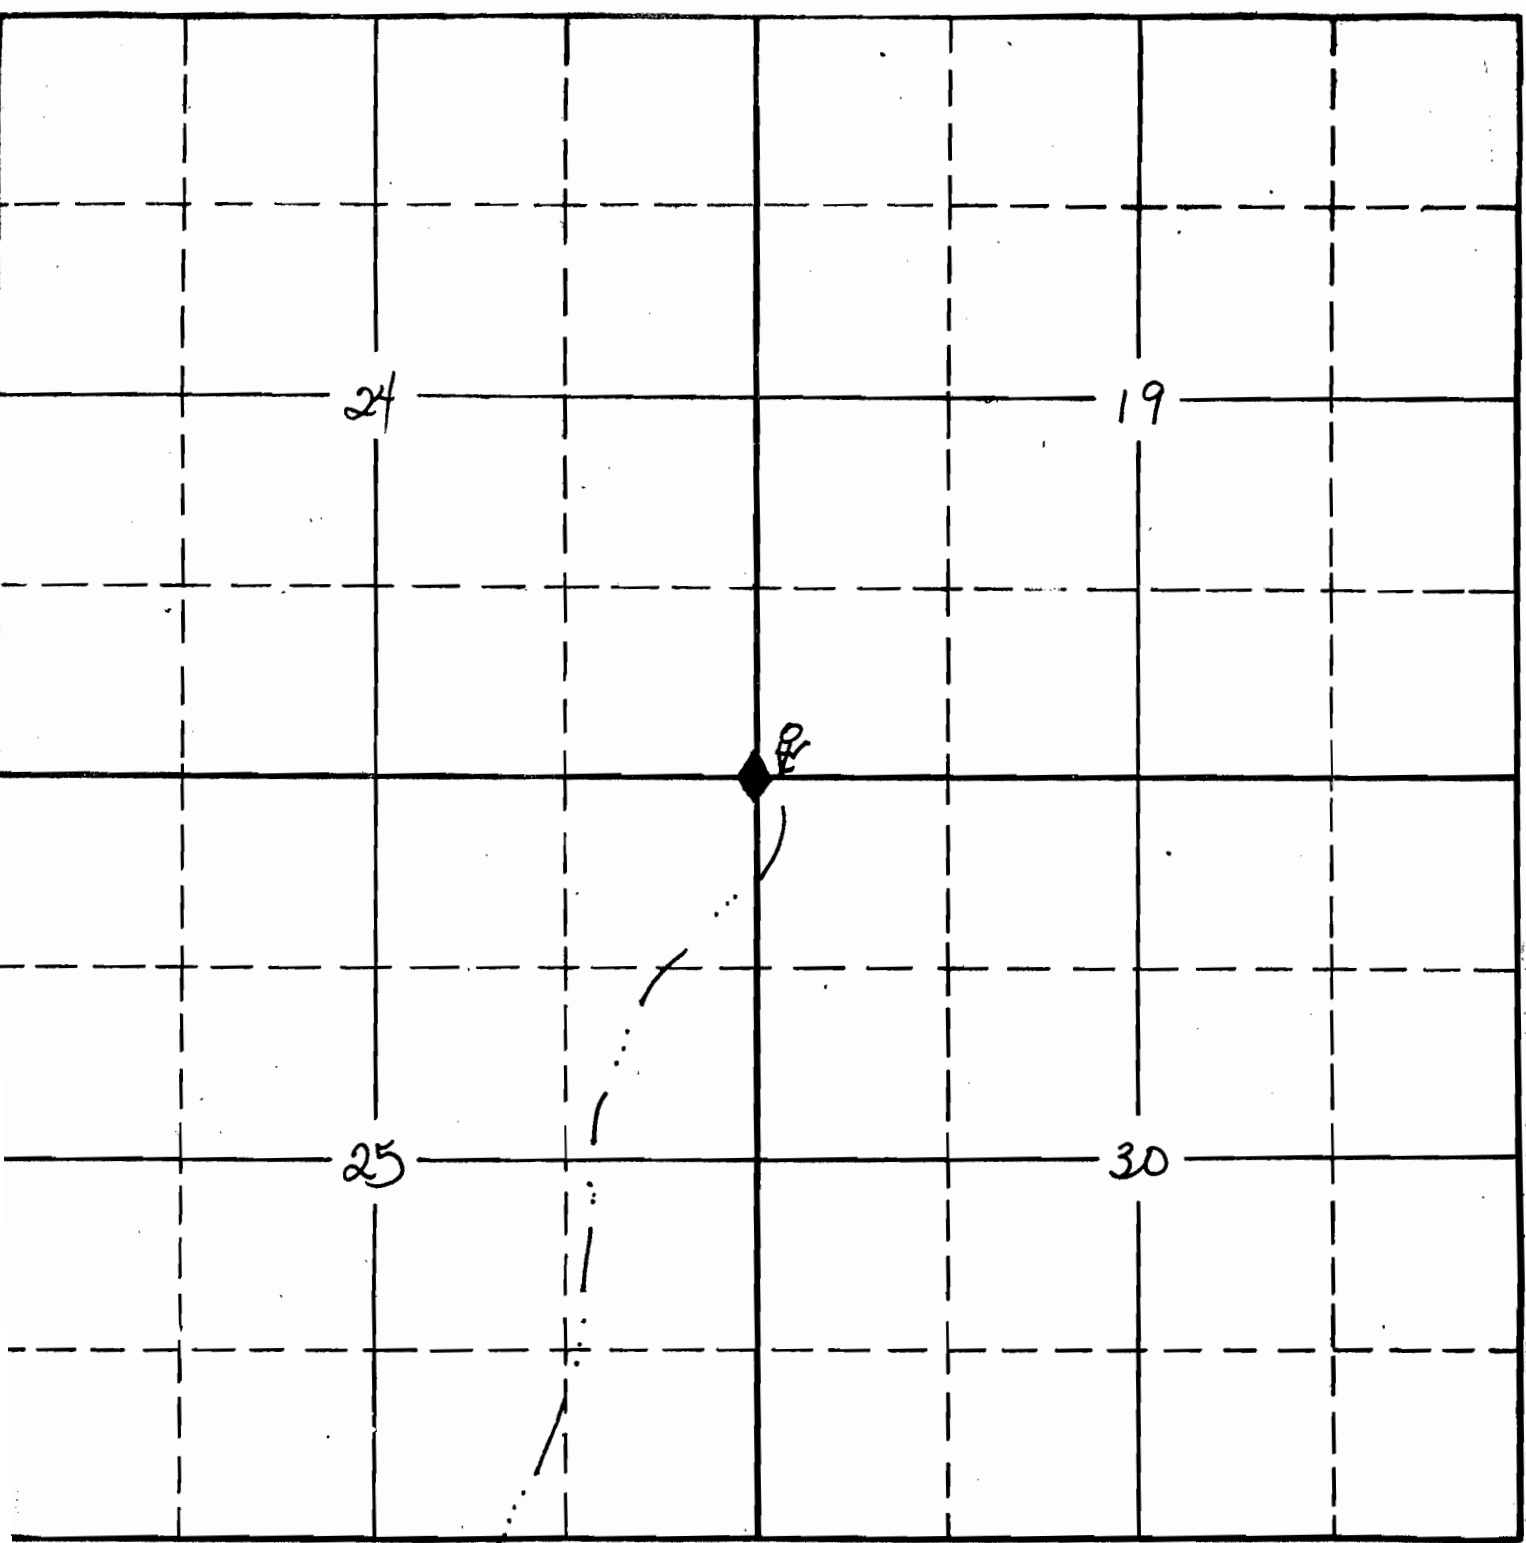

East

South

RECEIVED

SEP 19 1983
WATER RESOURCES DEPT.
SALEM, OREGON

APPLICATION No.
PERMIT No.

Application No. 66111
Permit No. 48347