


SECTION 20
SE SE

#4259- Four Corners Spring

TOWNSHIP 19 S, RANGE 33 1/2 E, W: M.

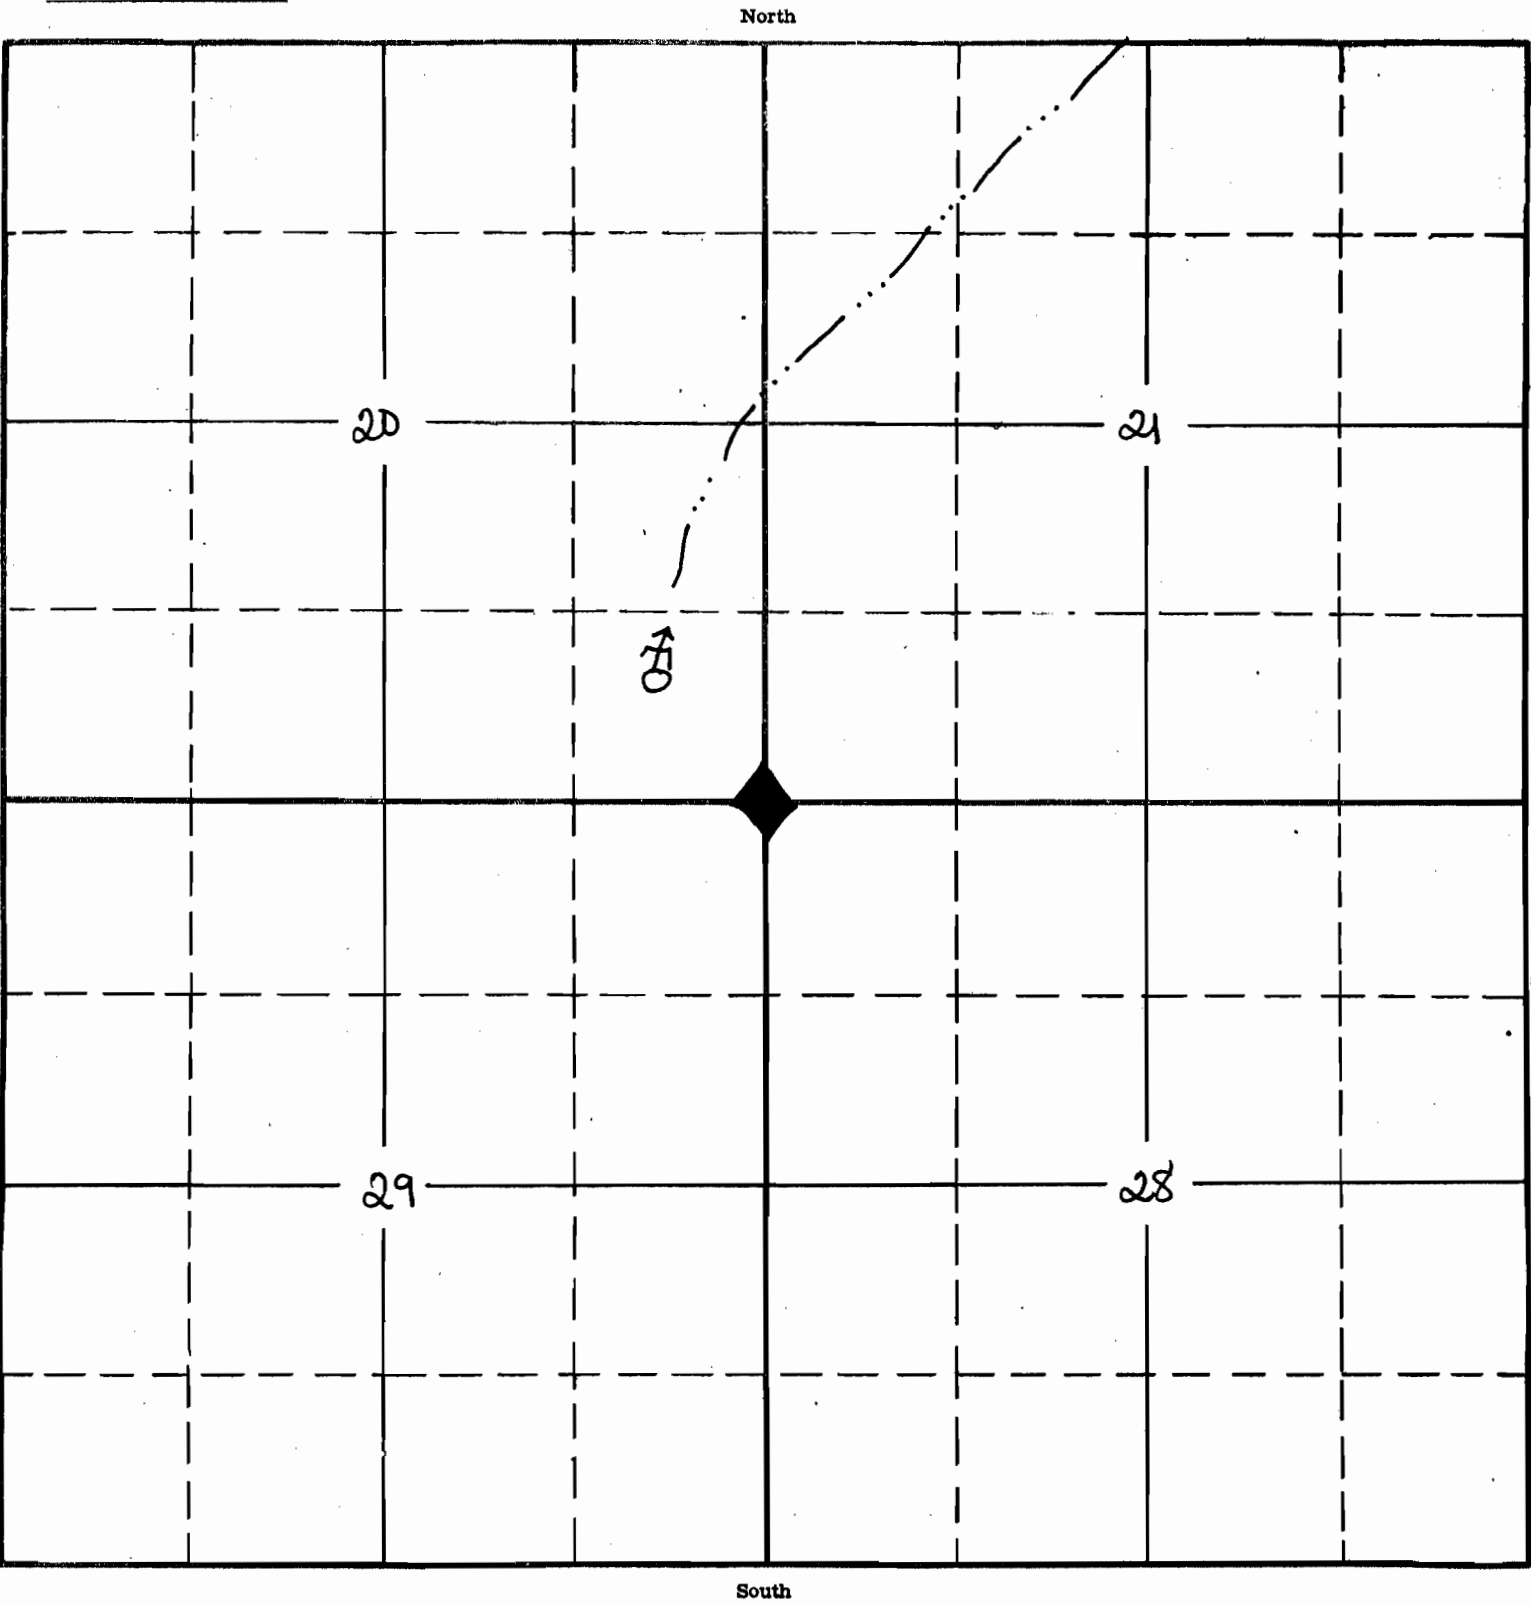

RECEIVED

SEP 19 1993
WATER RESOURCES DEPT.
SALEM, OREGON

APPLICATION No.
PERMIT No.

Application No. 66412
Permit No. 48348