


SECTION 5
NE SE

#4280-043 mth. Spring #1

TOWNSHIP 19 S, RANGE 35 E, W. M.

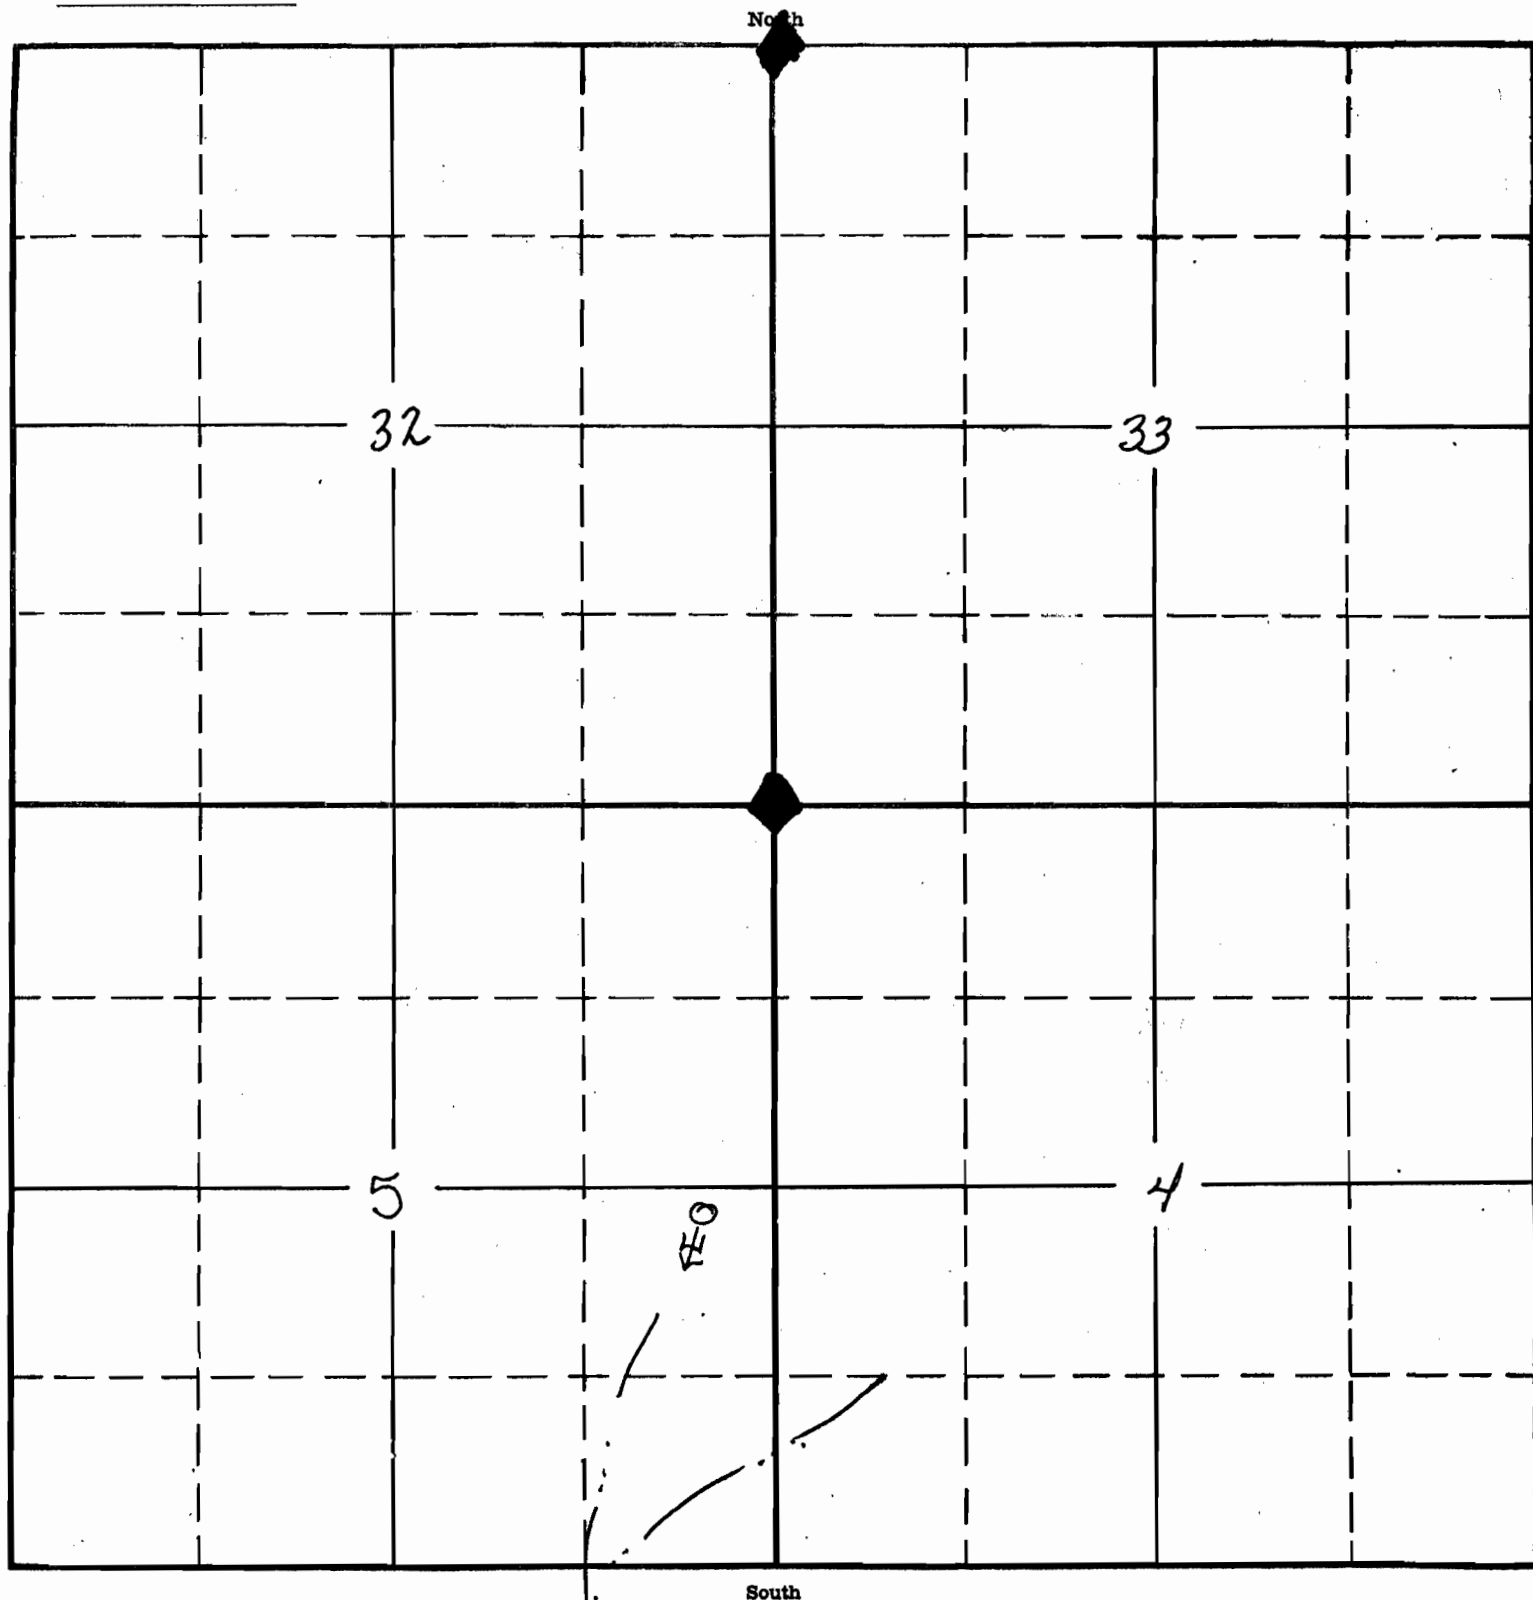

RECEIVED

SEP 19 1983

WATER RESOURCES DEPT.
SALEM, OREGON

APPLICATION No.
PERMIT No.

Application No. 66113
Permit No. 48349