


SECTION 12

#1128 - Borderline Spring

NESE

TOWNSHIP 22S, RANGE 34E, W. M.

North

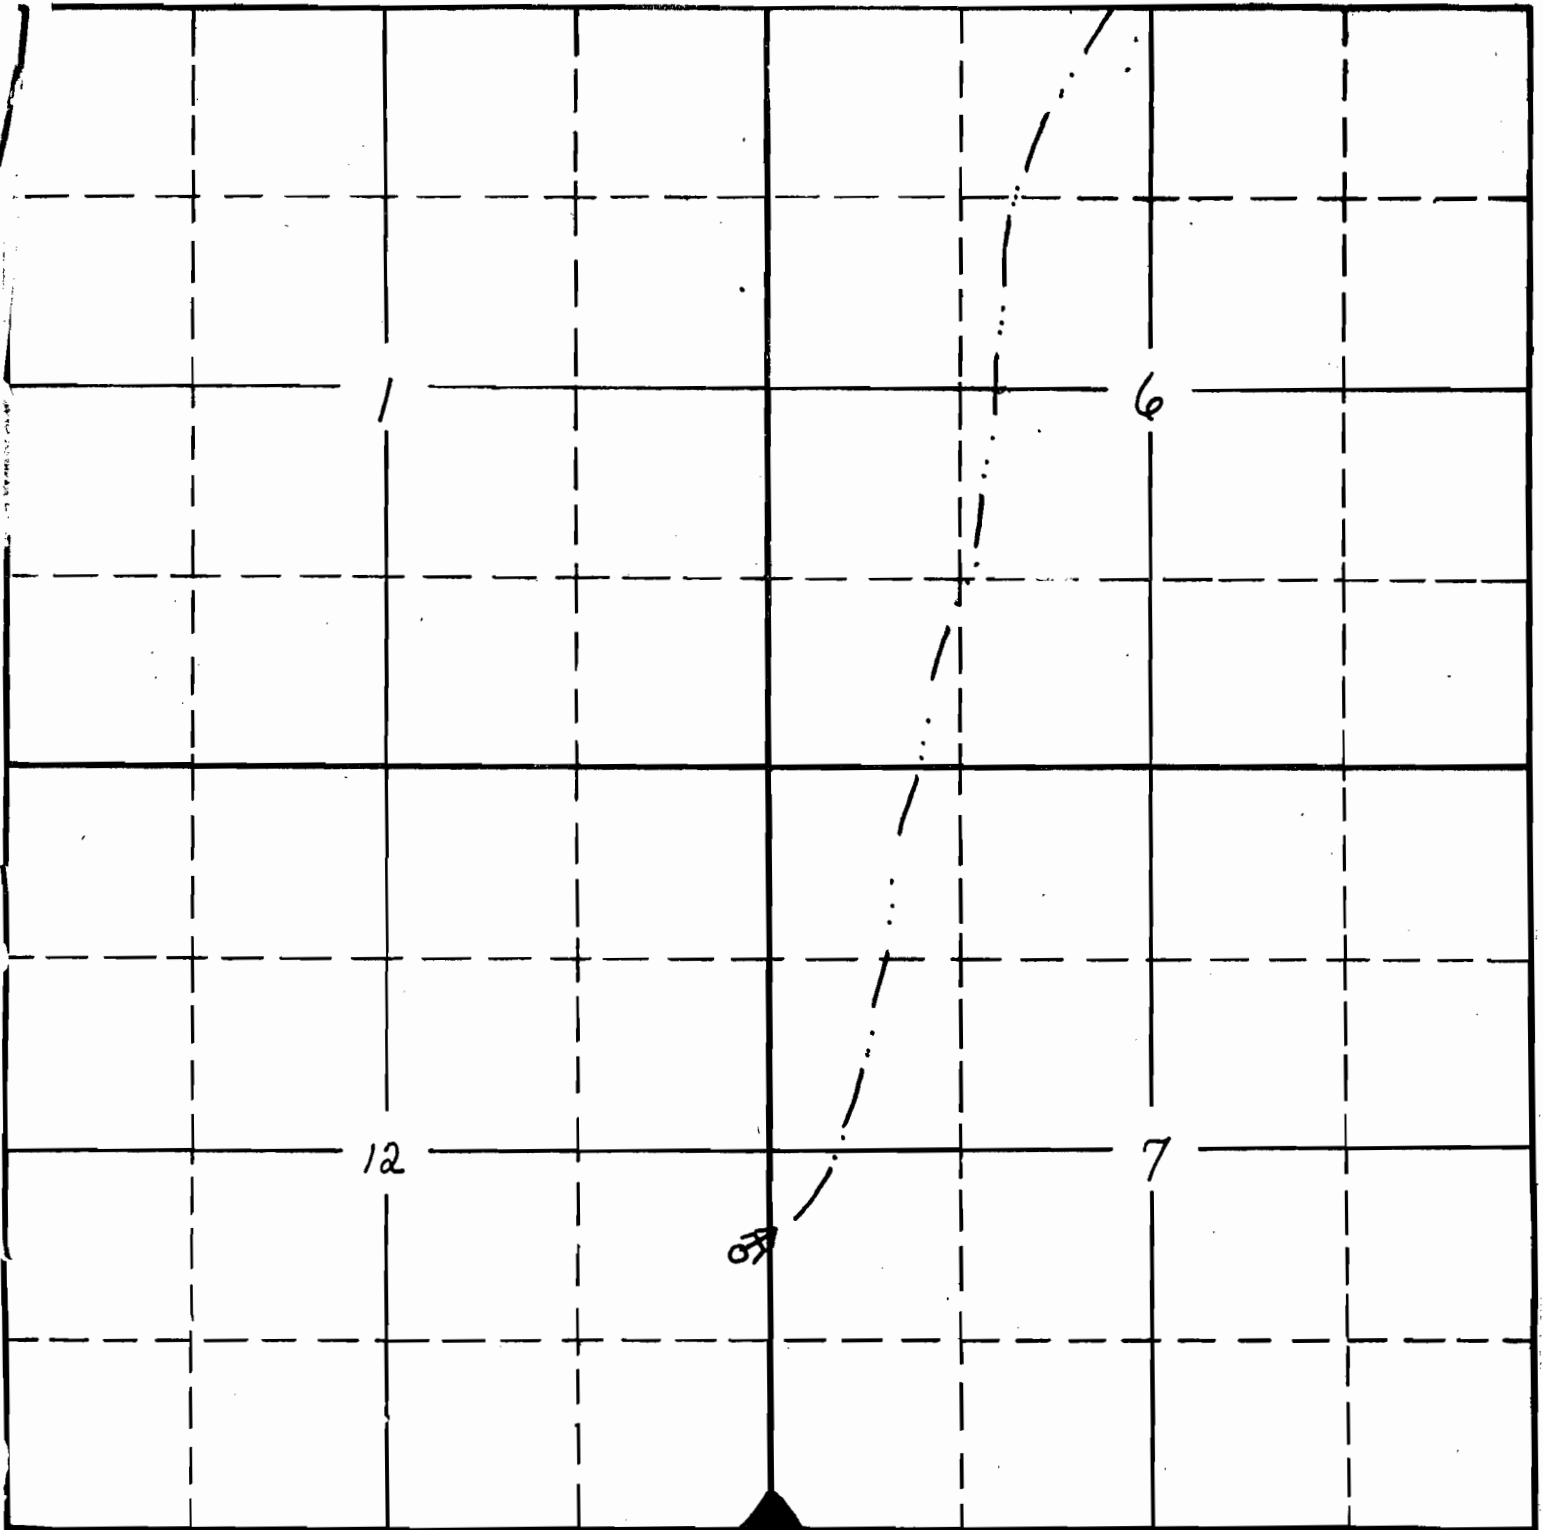

East

S

APPLICATION No.

PERMIT No.

SEP 19 1983
WATER RESOURCES DEPT.
SALEM, OREGON

Application No. 66114
Permit No. 48350