


SECTION

26 SE NW

TOWNSHIP 22 S, RANGE 27 E, W. M.

North #1063 - Badger Spring Dev.

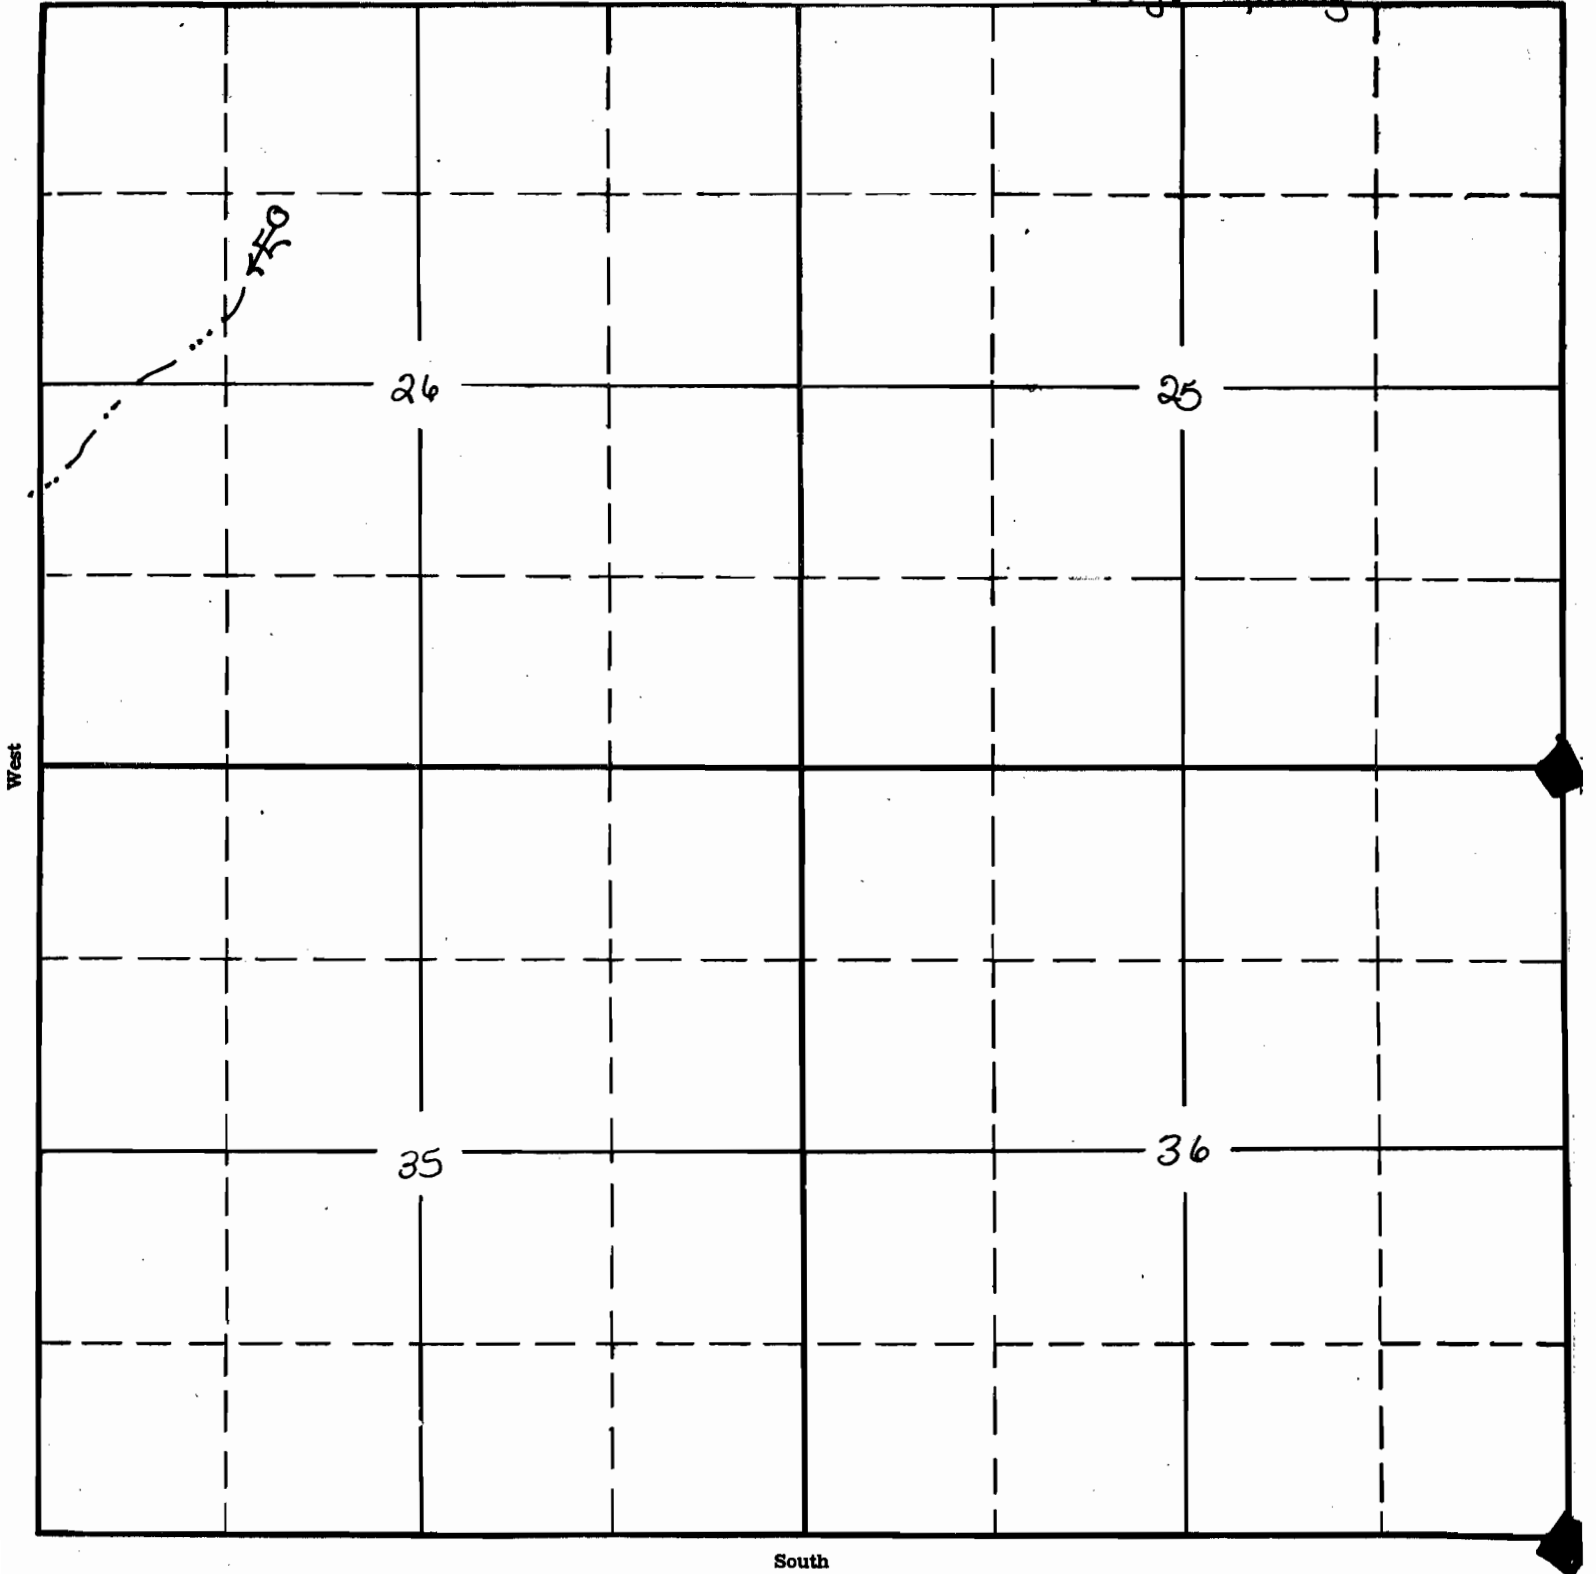

RECEIVED

SEP 19 1993
WATER RESOURCES DEPT.
SALEM, OREGON

Application No. 66117
Permit No. 48352

APPLICATION No.
PERMIT No.