


NW SW

TOWNSHIP 30 S, RANGE 30 E, W. M.

North # 4549 - Matt Davies Spring

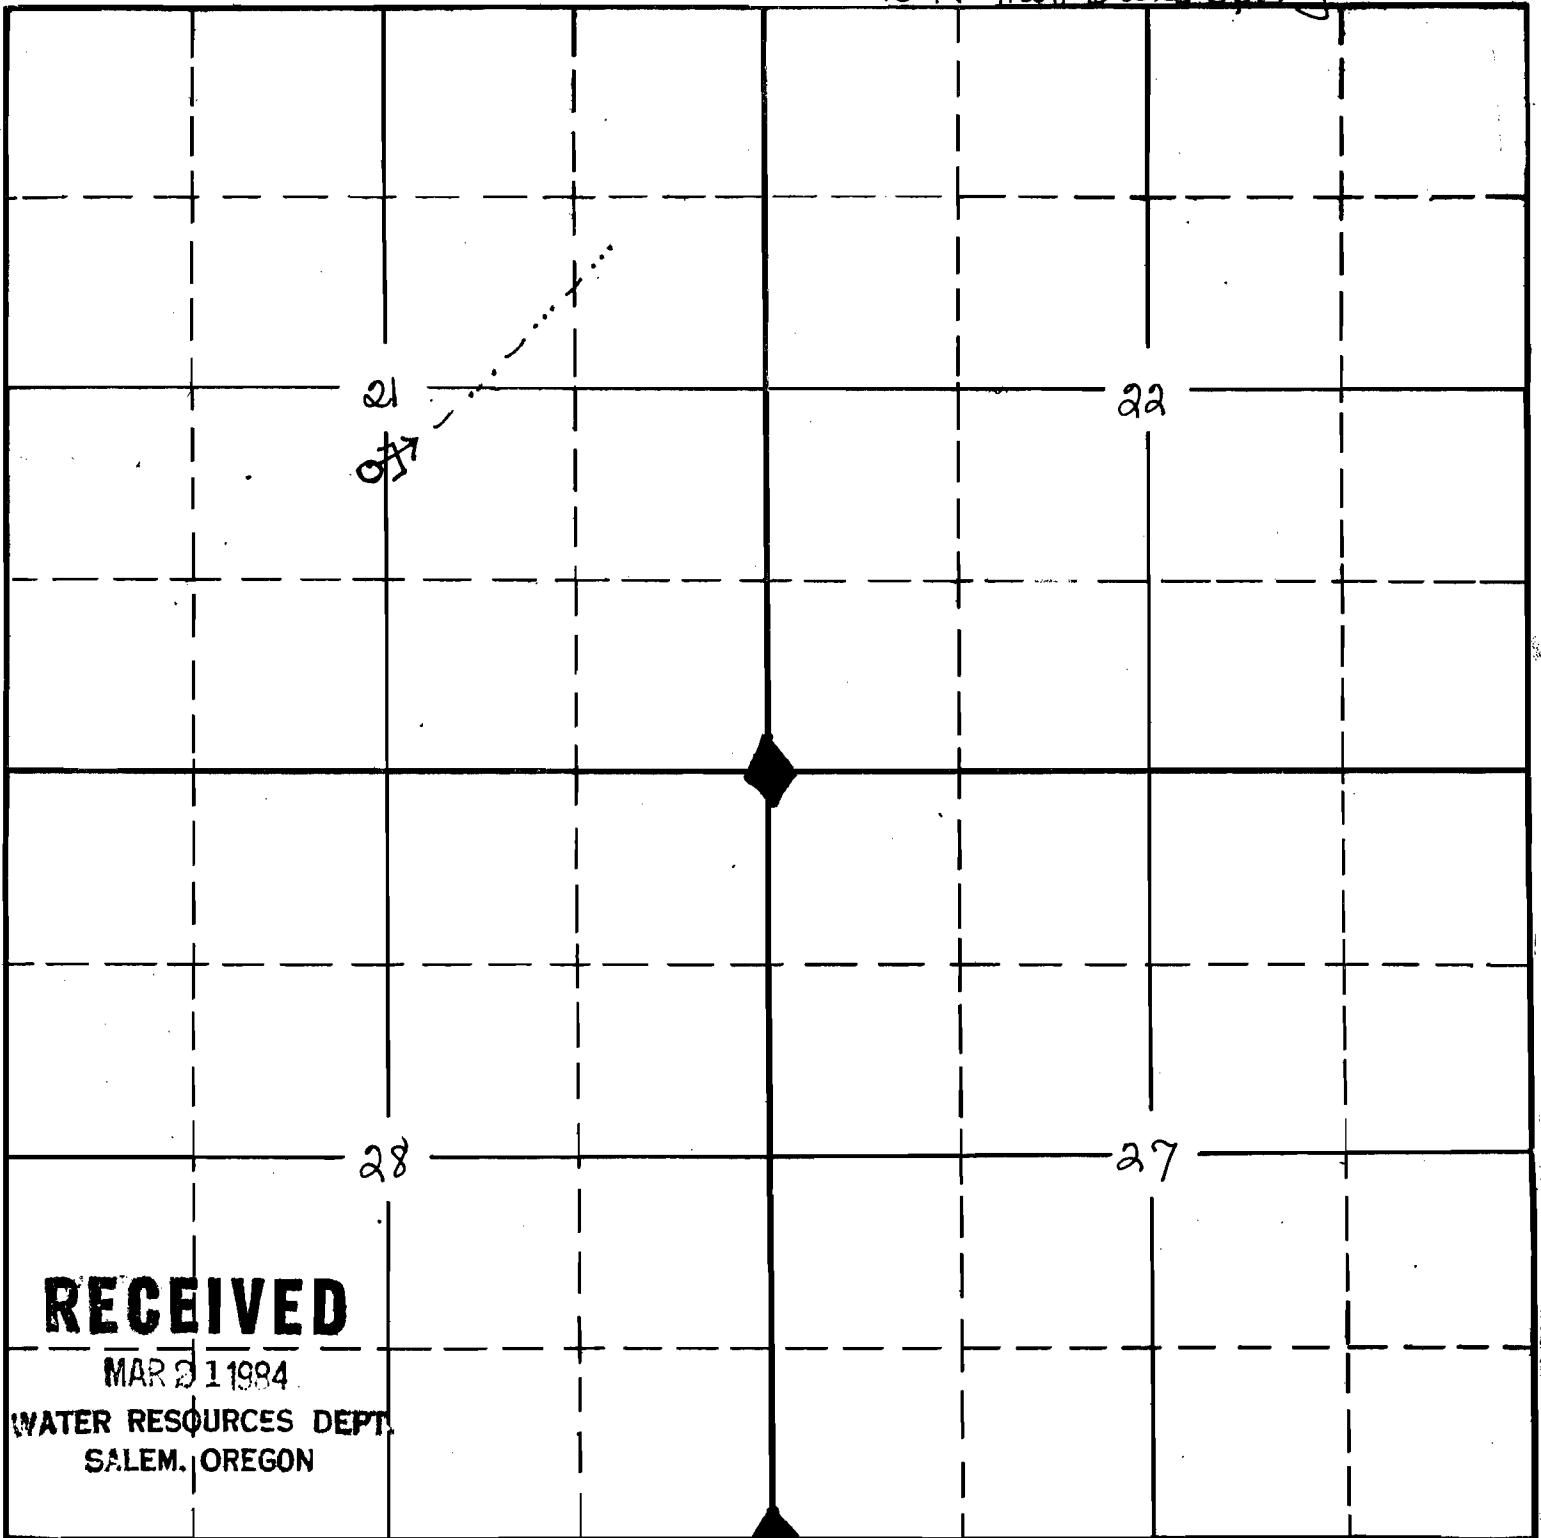

RECEIVED

MAR 21 1984

WATER RESOURCES DEPT.
SALEM, OREGON

South

APPLICATION No.

PERMIT No.

SEP 19 1993

WATER RESOURCES DEPT.
SALEM, OREGON

Application No. 66119
Permit No. 48354