


SW $\frac{1}{4}$ SE $\frac{1}{4}$ TOWNSHIP 23S, RANGE 34E, W. M.

North

Clear Spring # 5364

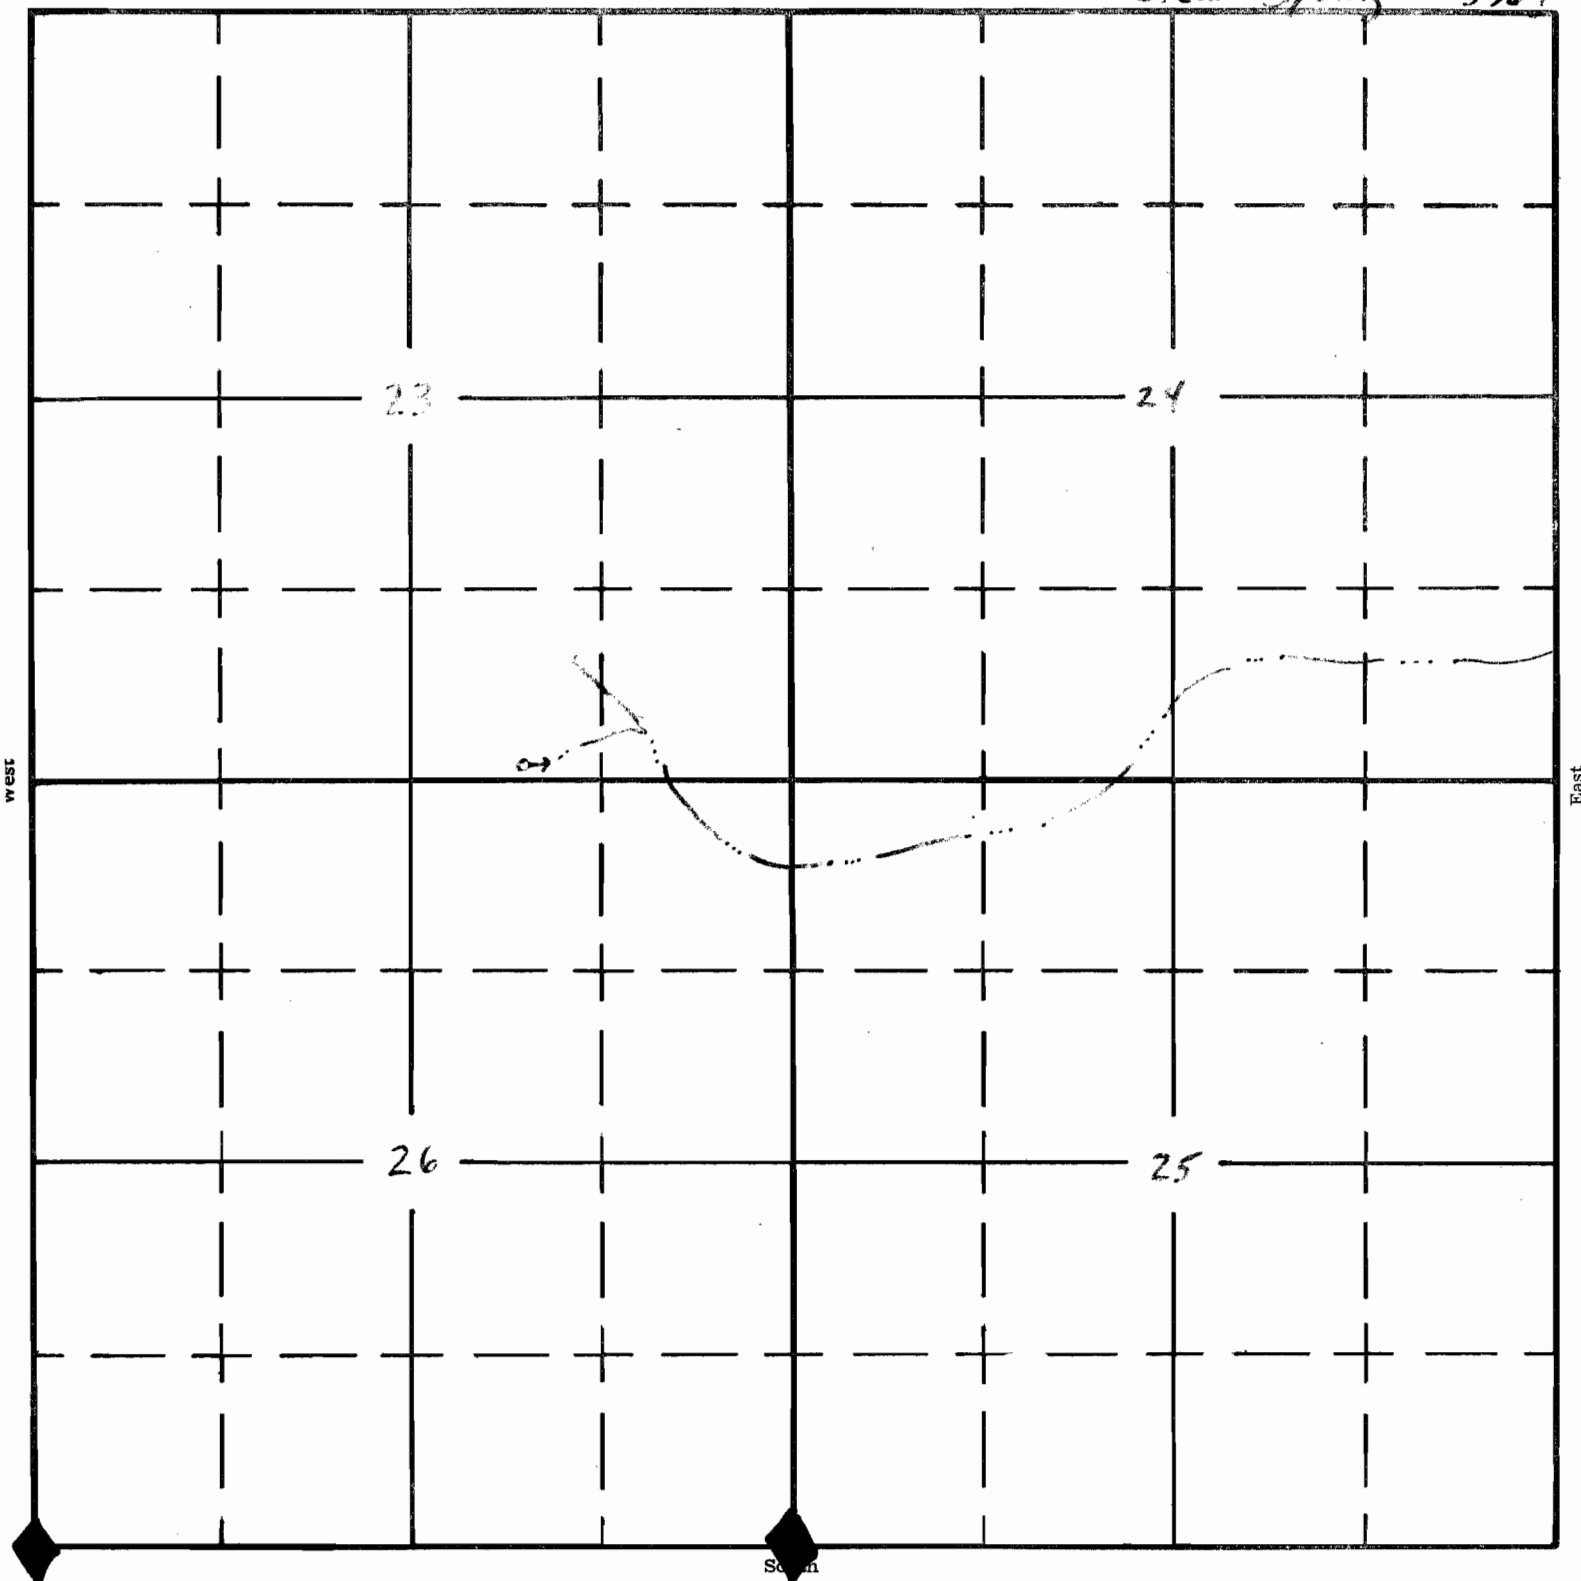

RECEIVED

SEP 19 1983
WATER RESOURCES DEPT.
SALEM, OREG.

Application No. 66125
Permit No. 48360