


SECTION

35 NE SW

TOWNSHIP 21 S, RANGE 30 E, W. M.

North # 1510 - ~~Water~~ HW Spring

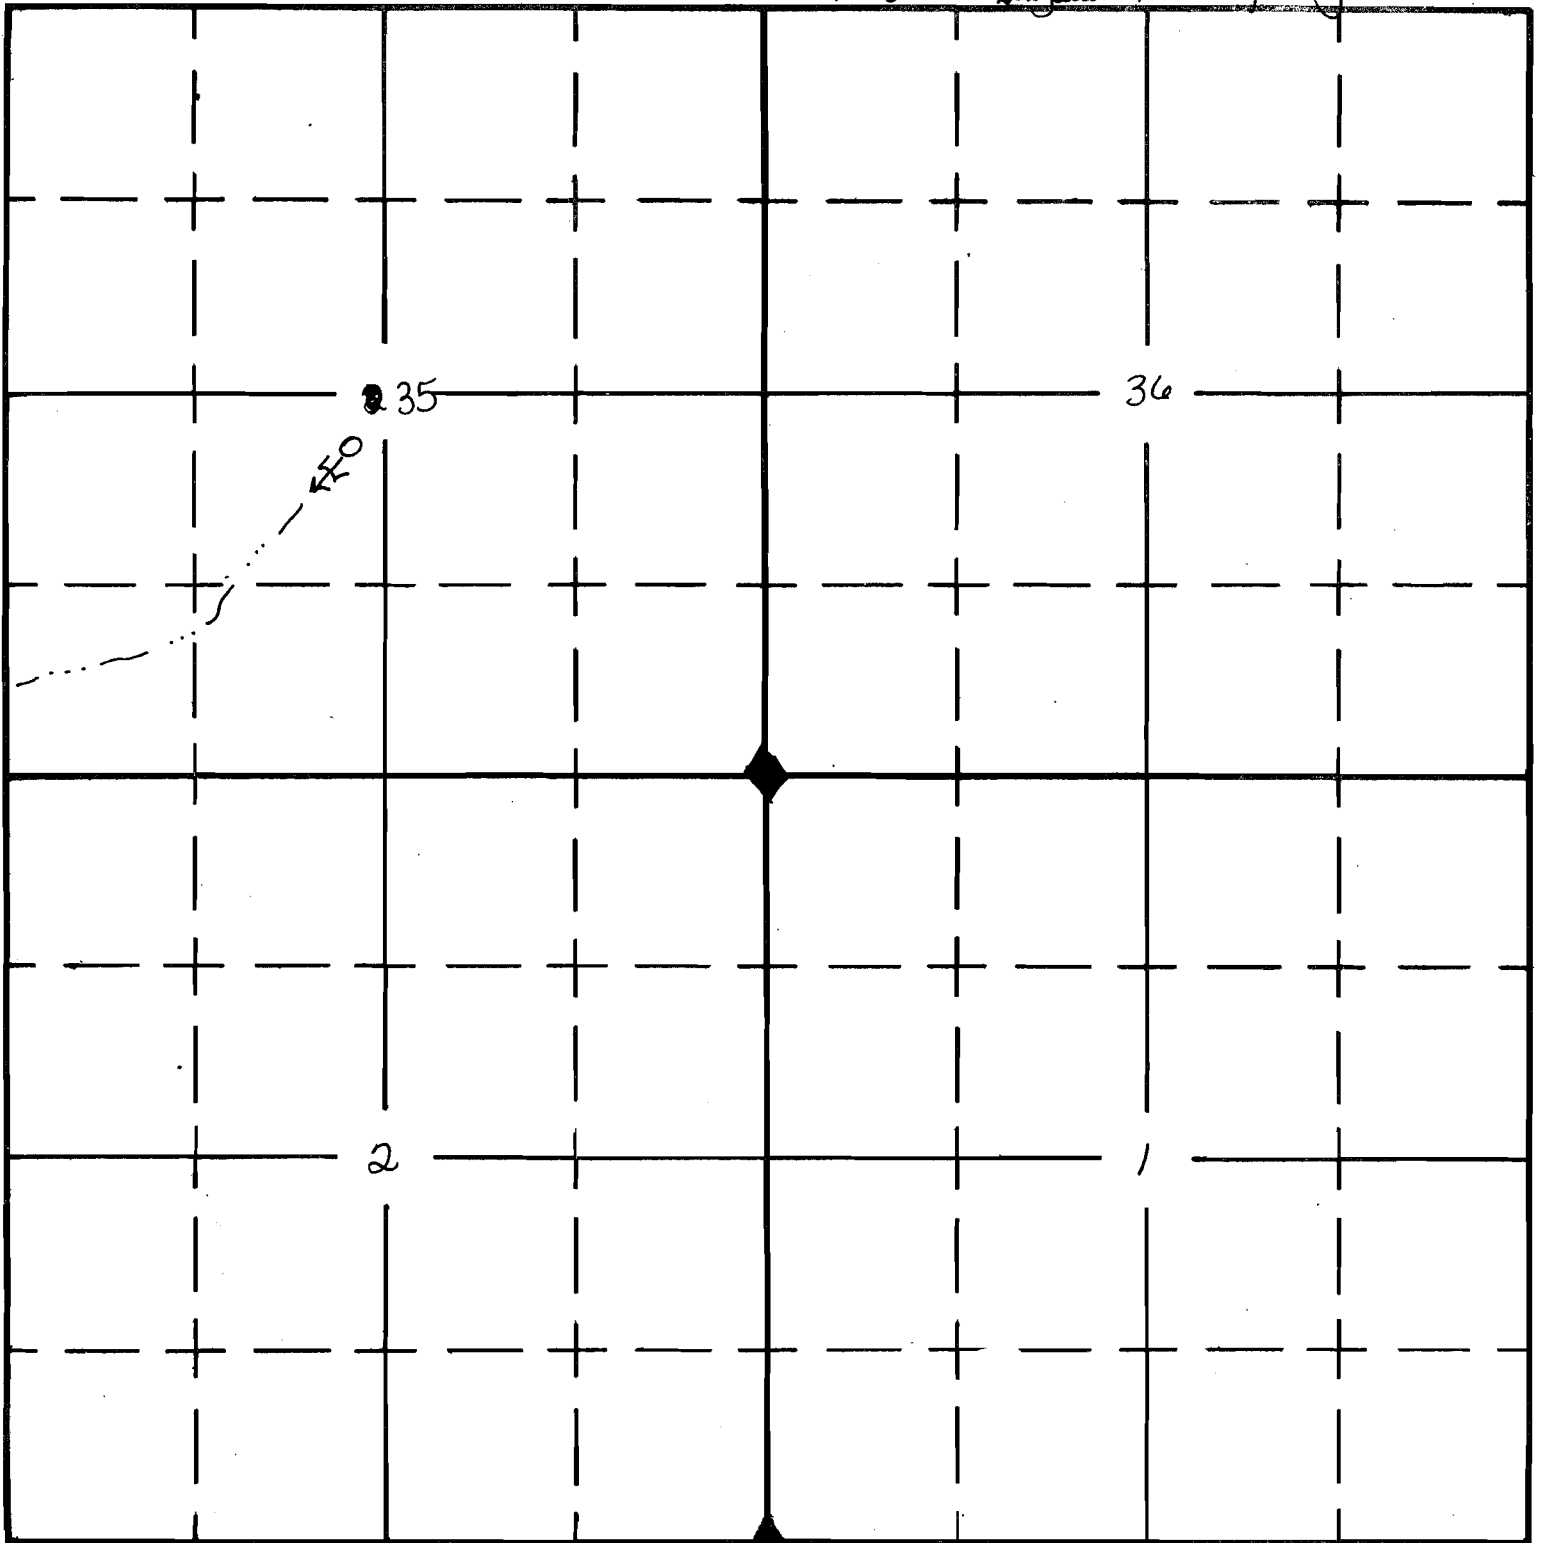

RECEIVED

SEP 19 1983  
WATER RESOURCES DEPT.  
SALEM, OREGON

Application No. 66133  
Permit No. 48367