SECTION 5 SENE

#5122 - Chukar Spring

TOWNSHIP 23 S., RANGE 36 E., W. M.

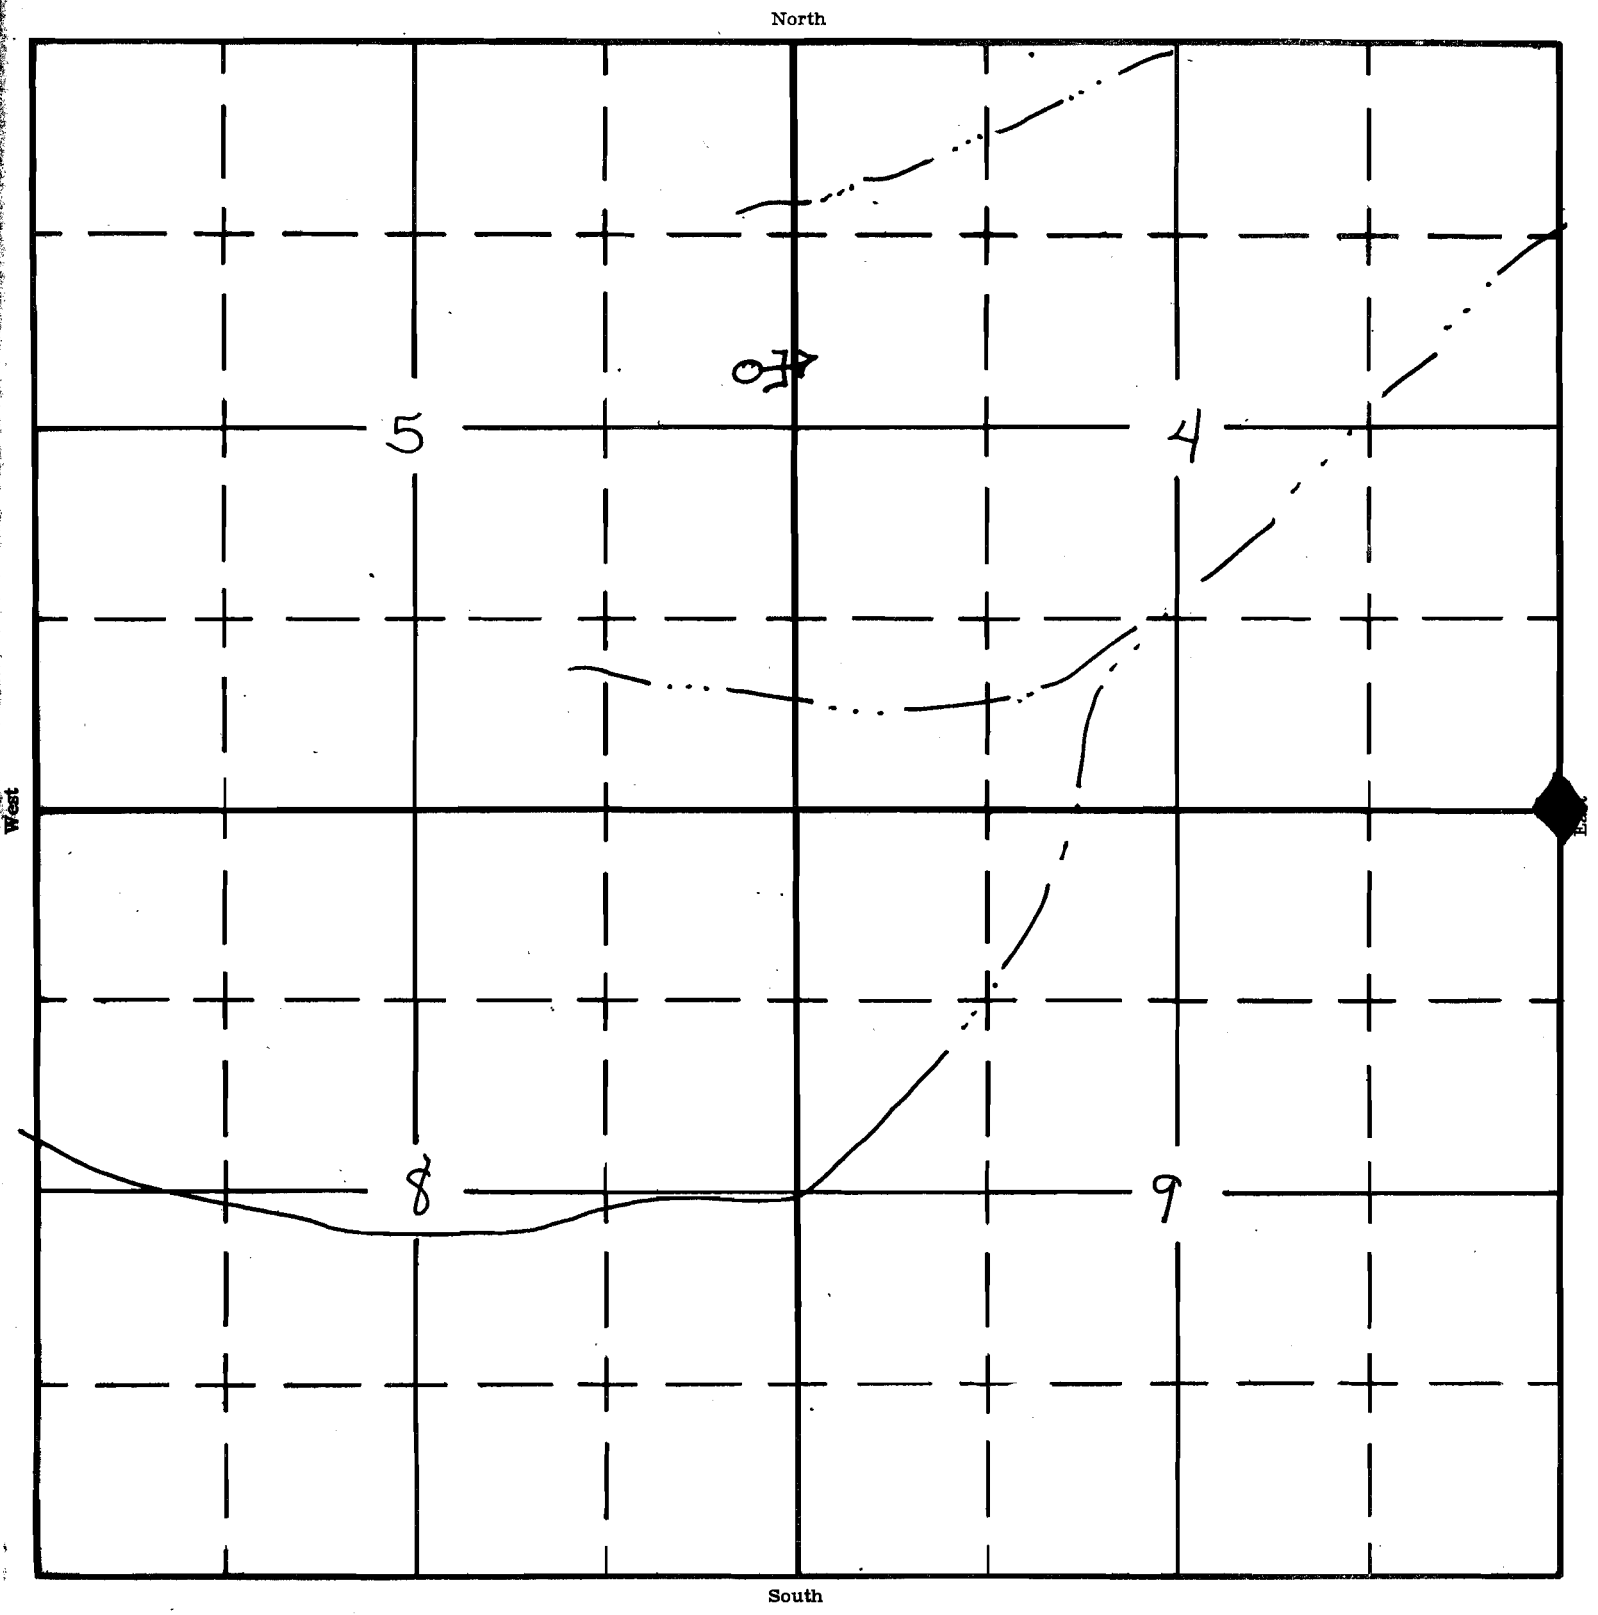

RECEIVED
SEP 19 1983
WATER RESOURCES DEPT.
SALEM, OREGON

Application No. 66142
Permit No. 48376